
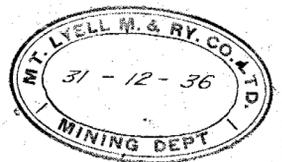


5 cm

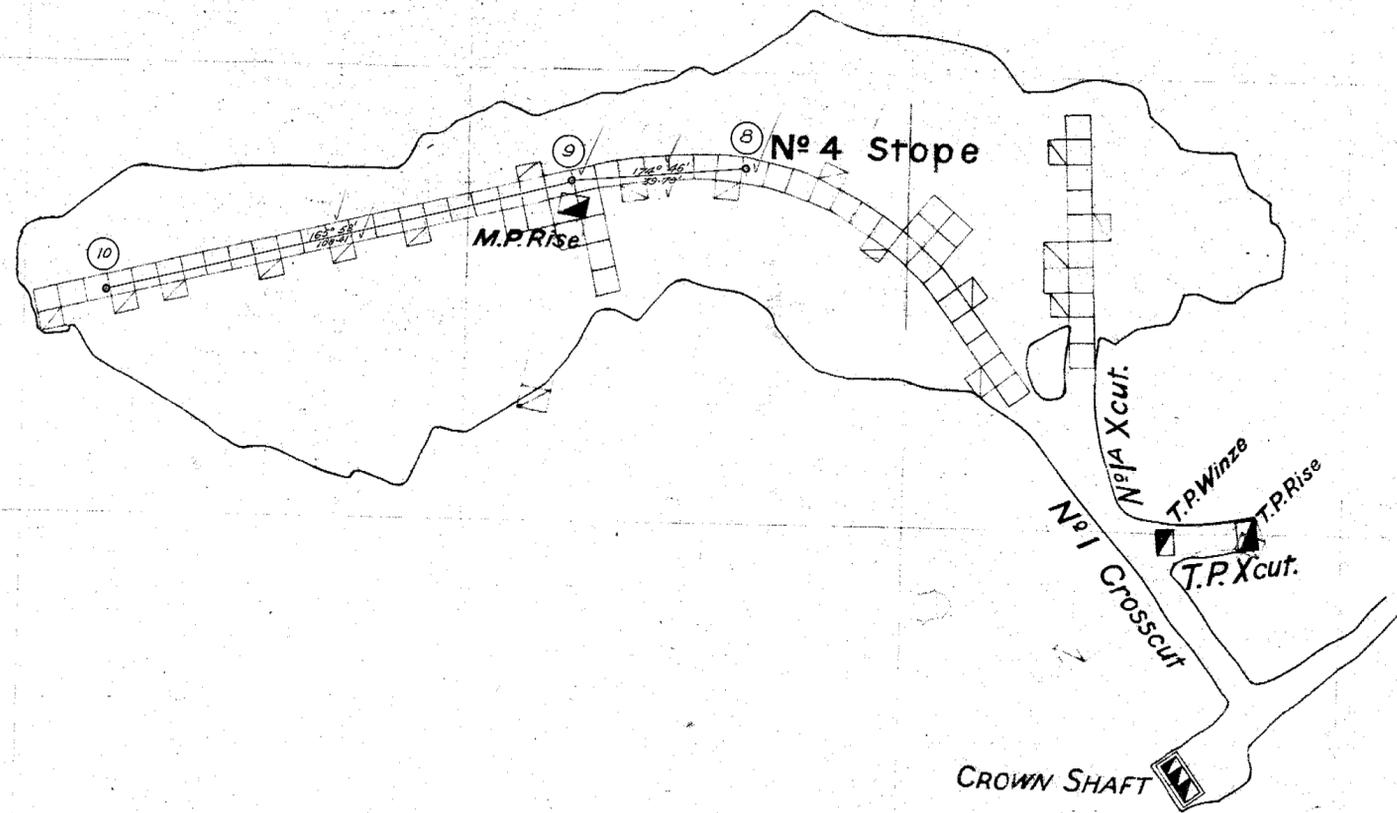

THE MOUNT LYELL M. & R. CO. LTD.

DETAIL PLAN

UNDERGROUND WORKINGS

400 FT. LEVEL

CROWN LYELL MINE

*R. W. ...* General Manager

*G. Fred. Jenkins* Mine Superintendent

SCALE - 30 FEET TO THE INCH

