
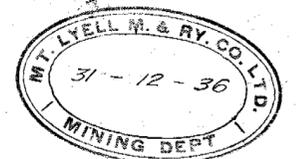
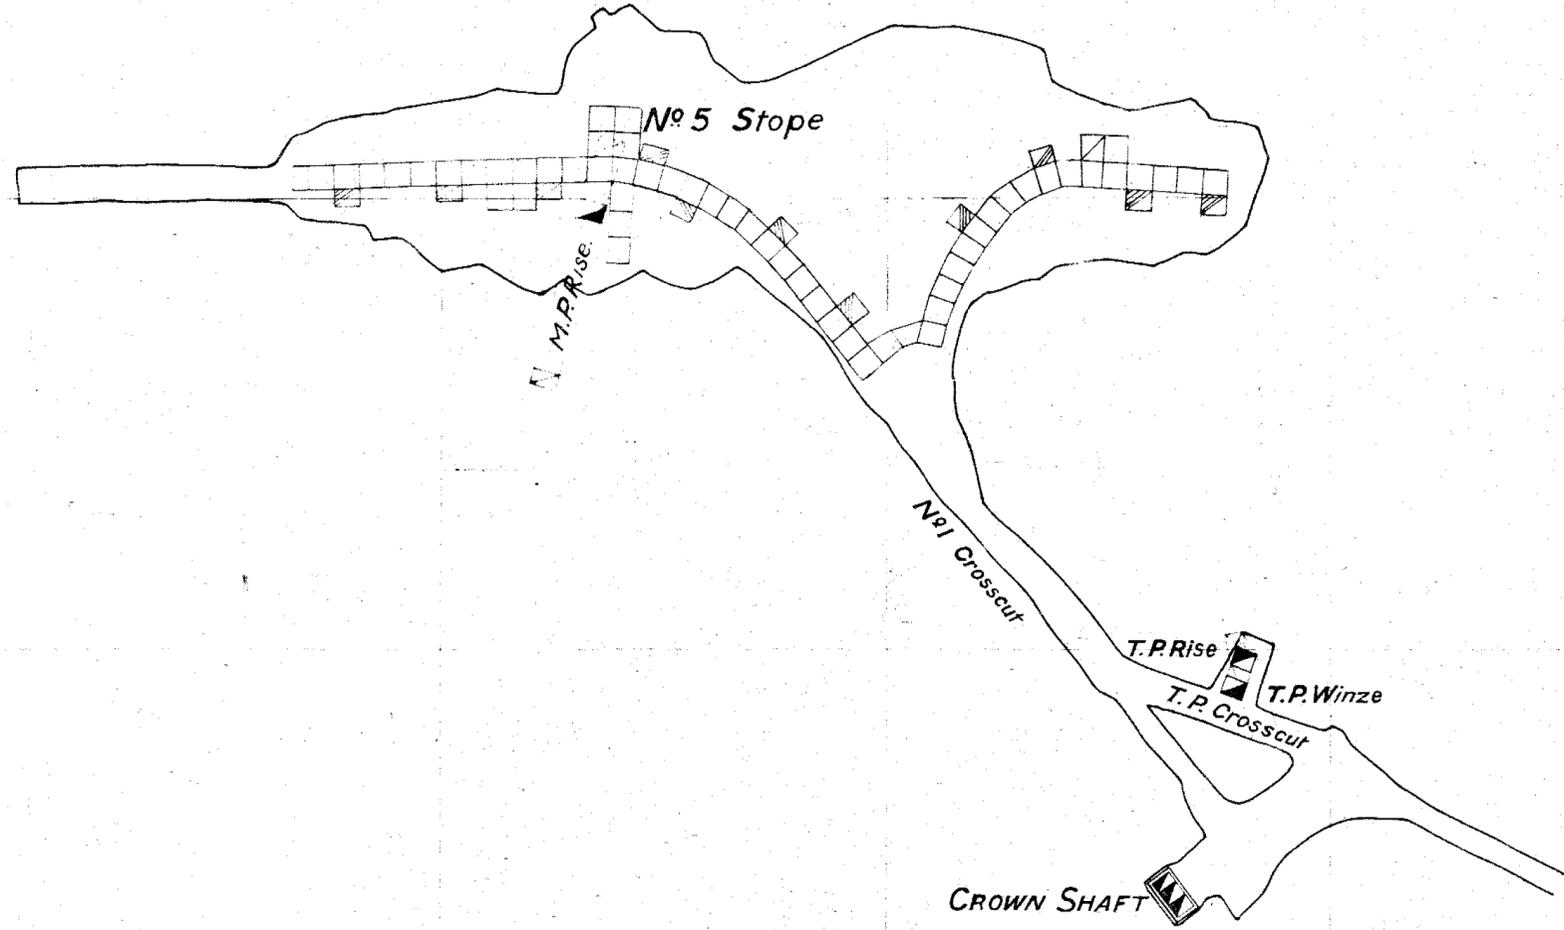


56-44

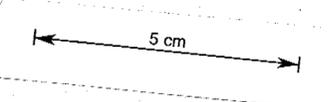


THE MOUNT LYELL M. & R. CO. LTD.

DETAIL PLAN

UNDERGROUND WORKINGS

500 FT. LEVEL

CROWN LYELL MINE

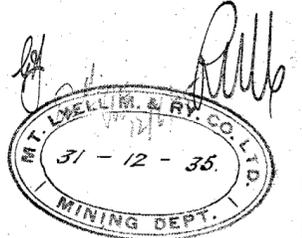

A. H. Williams General Manager
G. H. Jackson Mine Superintendent

SCALE - 30 FEET TO THE INCH

