


5 cm

1000 W.

900 W.

800 W.

700 W.

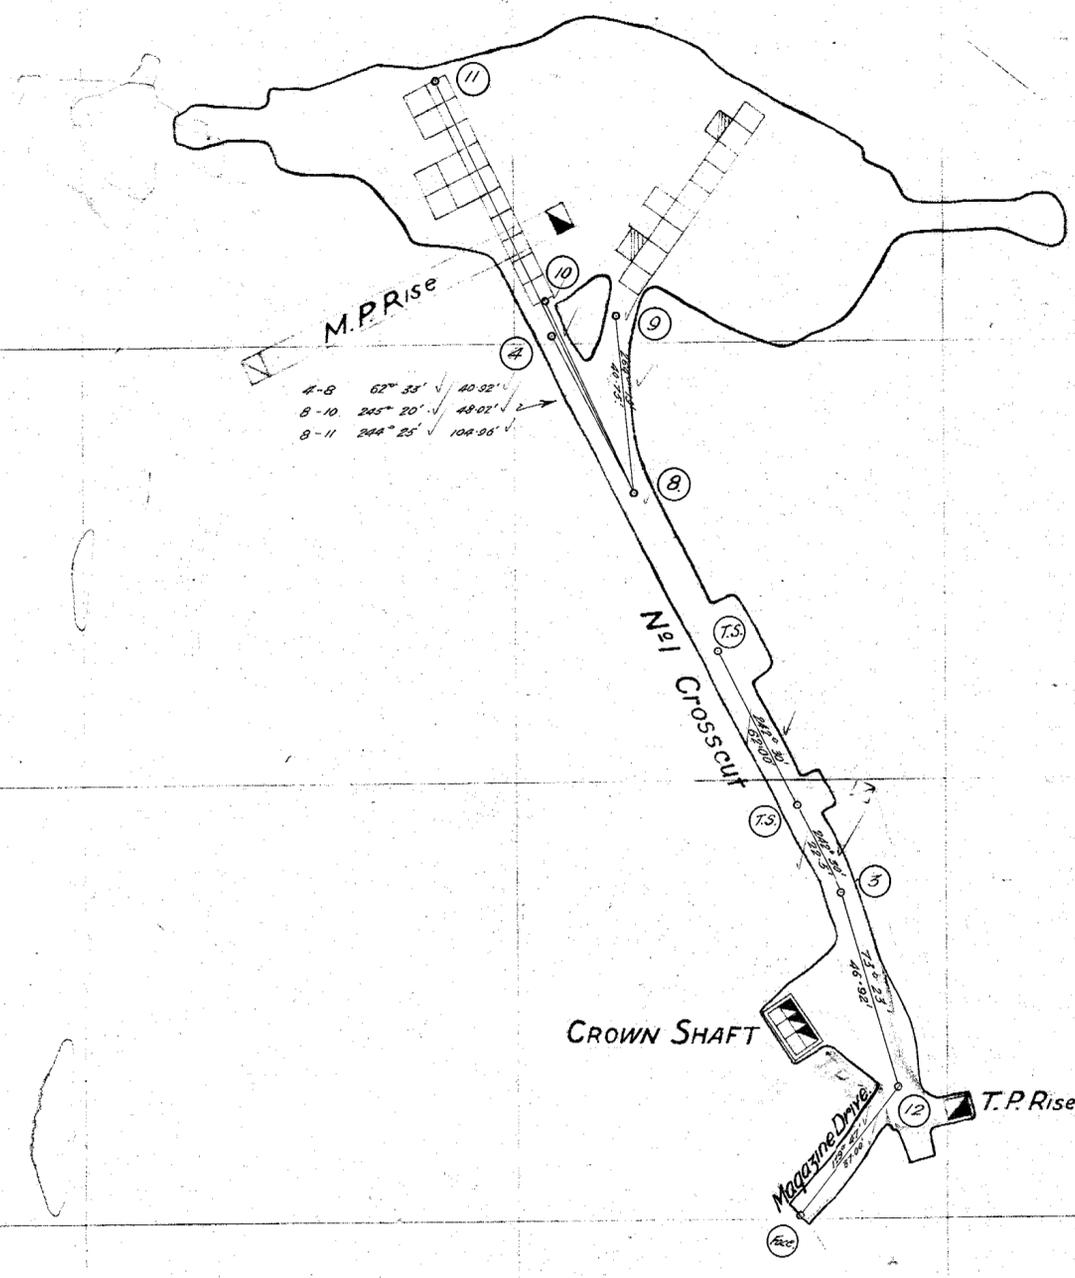

THE MOUNT LYELL M. & R. CO. LTD.


DETAIL PLAN
UNDERGROUND WORKINGS
600 FT. LEVEL

CROWN LYELL MINE

R. W. Murray General Manager

G. Redfords Mine Superintendent

SCALE - 30 FEET TO THE INCH

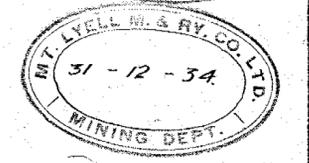

100 S.

80

100 N.

200 N.

300 N.

1100

900

800