
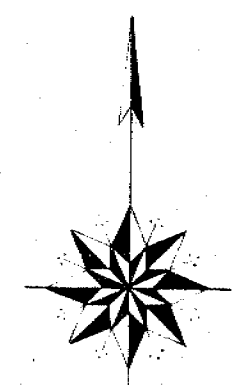


56-18


5 cm

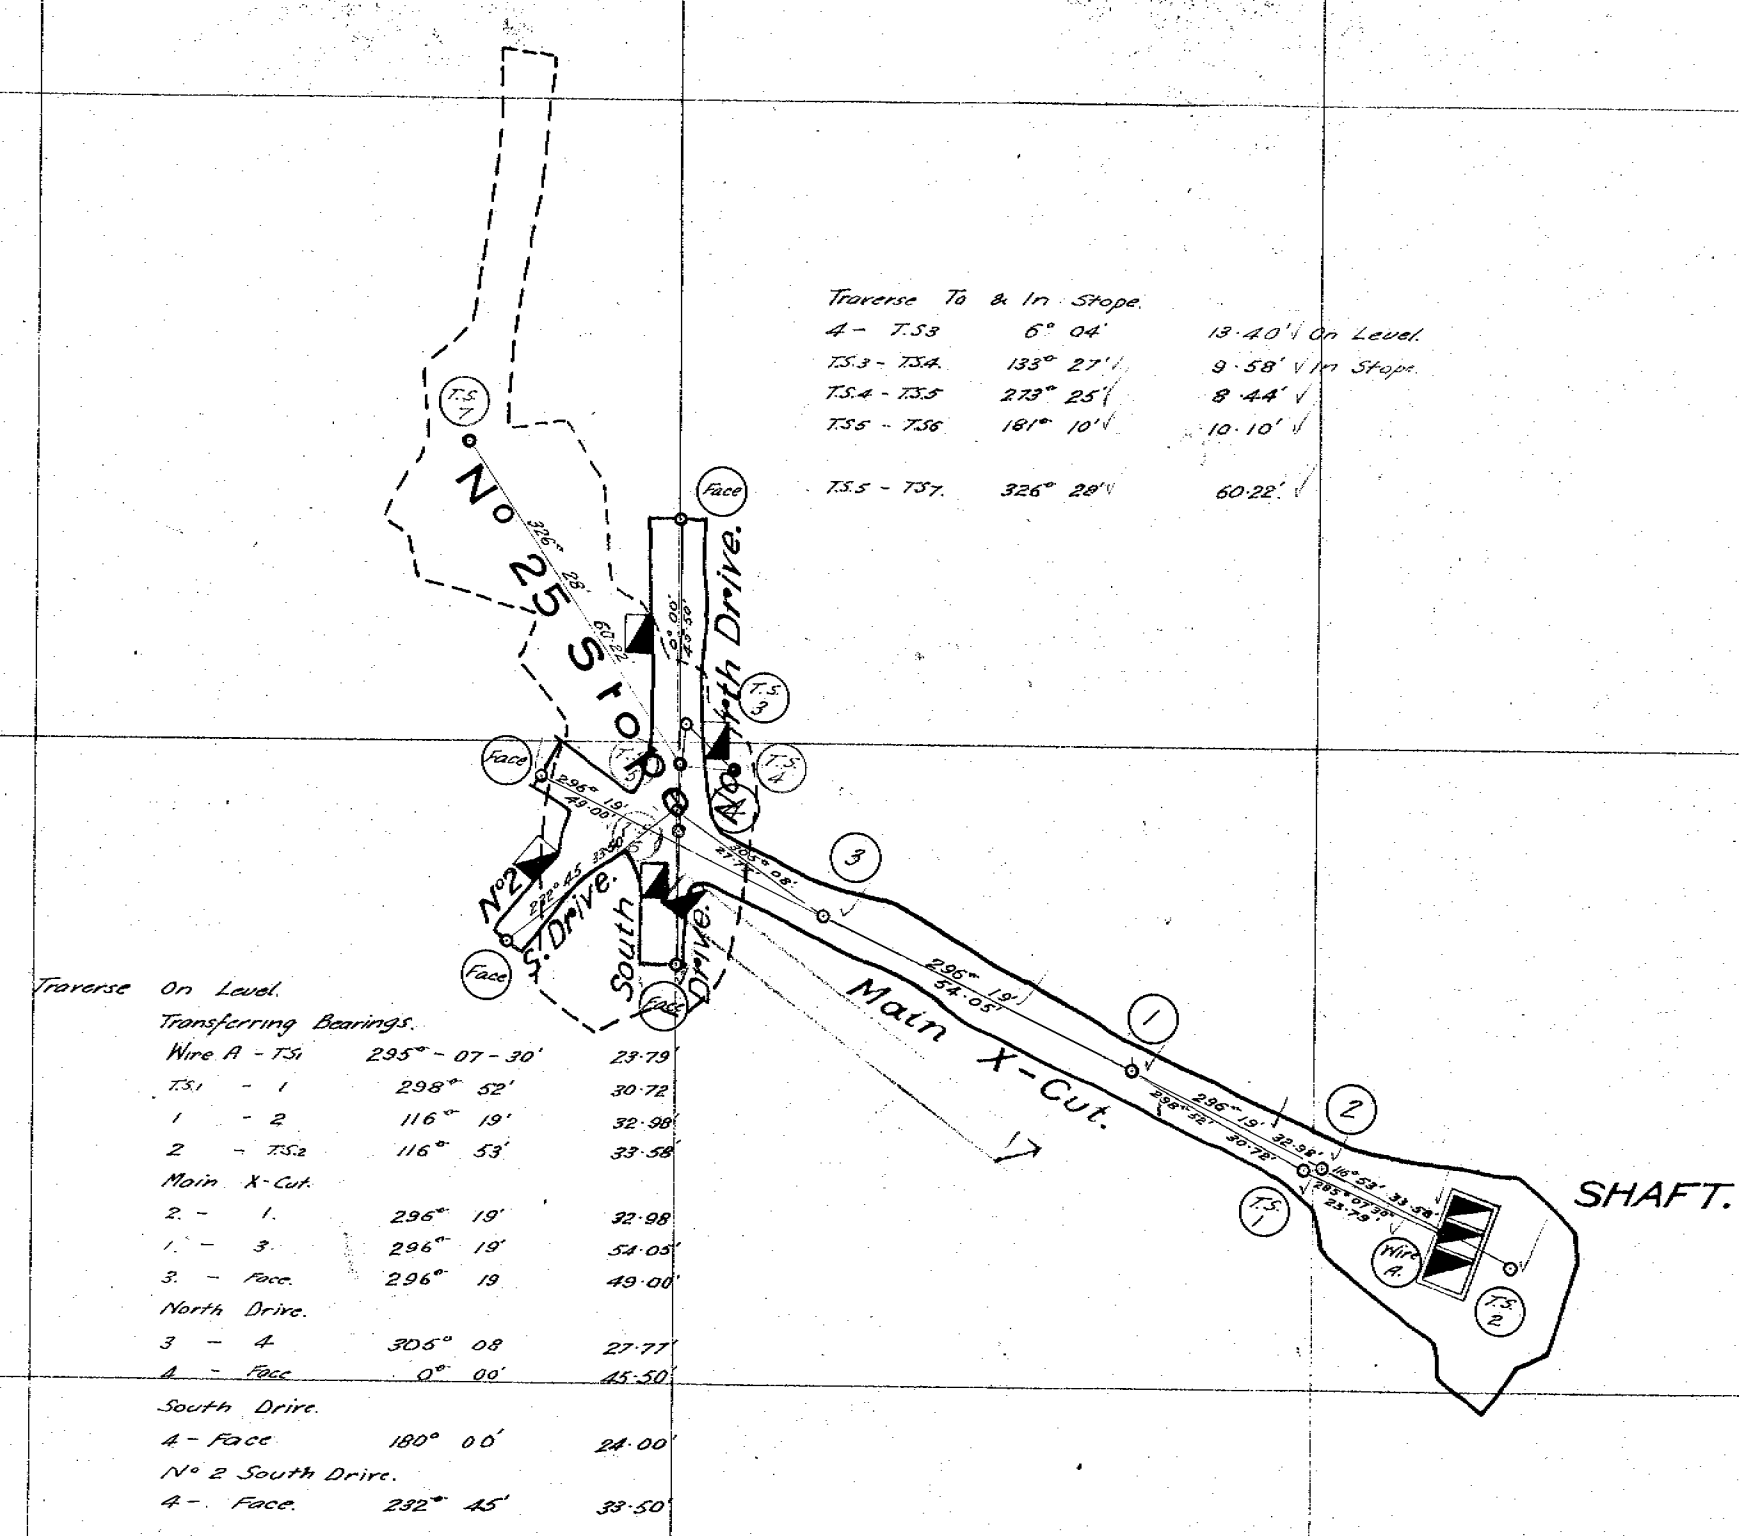

THE MOUNT LYELL M. & R. CO. LTD.
LYELL COMSTOCK MINE.

No 9 LEVEL.

SCALE : 1 INCH = 30 FEET.

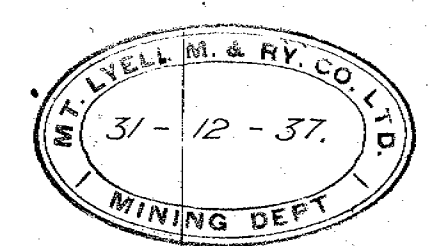

W. H. H. H. GENERAL MANAGER.
A. H. H. H. MINE SUPERINTENDENT.

3/1/38