



17-19

56-49

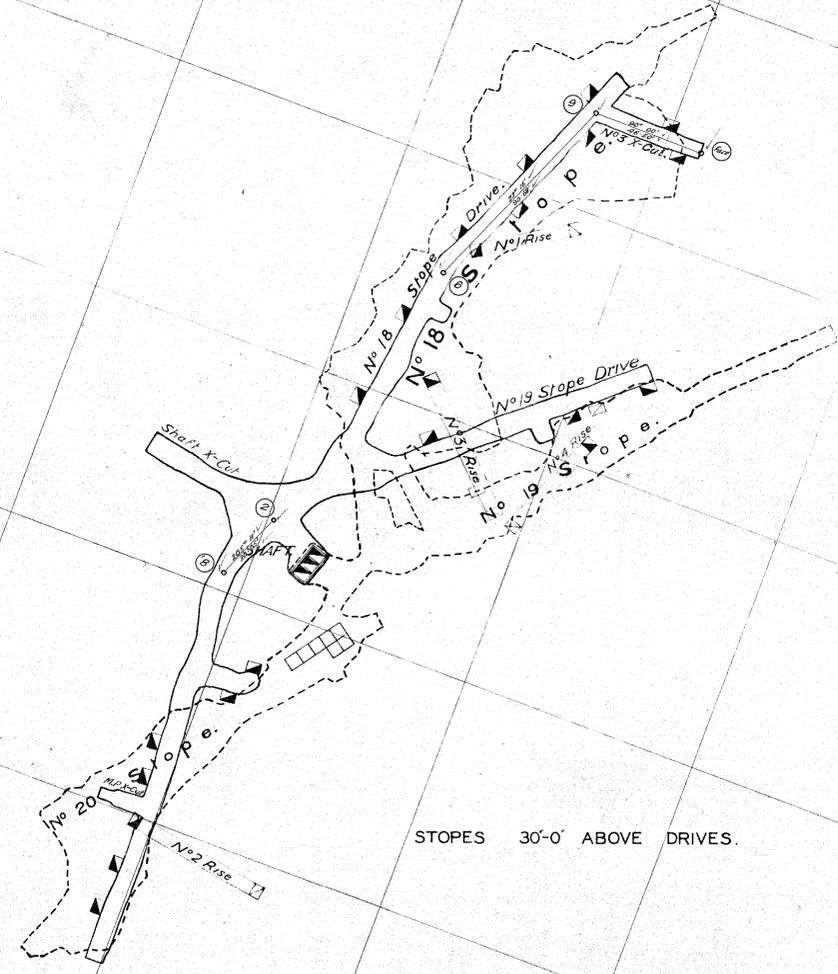

STOPES 30'-0" ABOVE DRIVES.

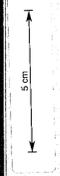

THE MOUNT LYELL M. & R. CO. LTD.
LYELL COMSTOCK MINE.

No. 6 LEVEL.
 SCALE - 1 INCH = 30 FEET

C. H. Plummer GENERAL MANAGER.
G. Red Jakes MINE SUPERINTENDENT.

