

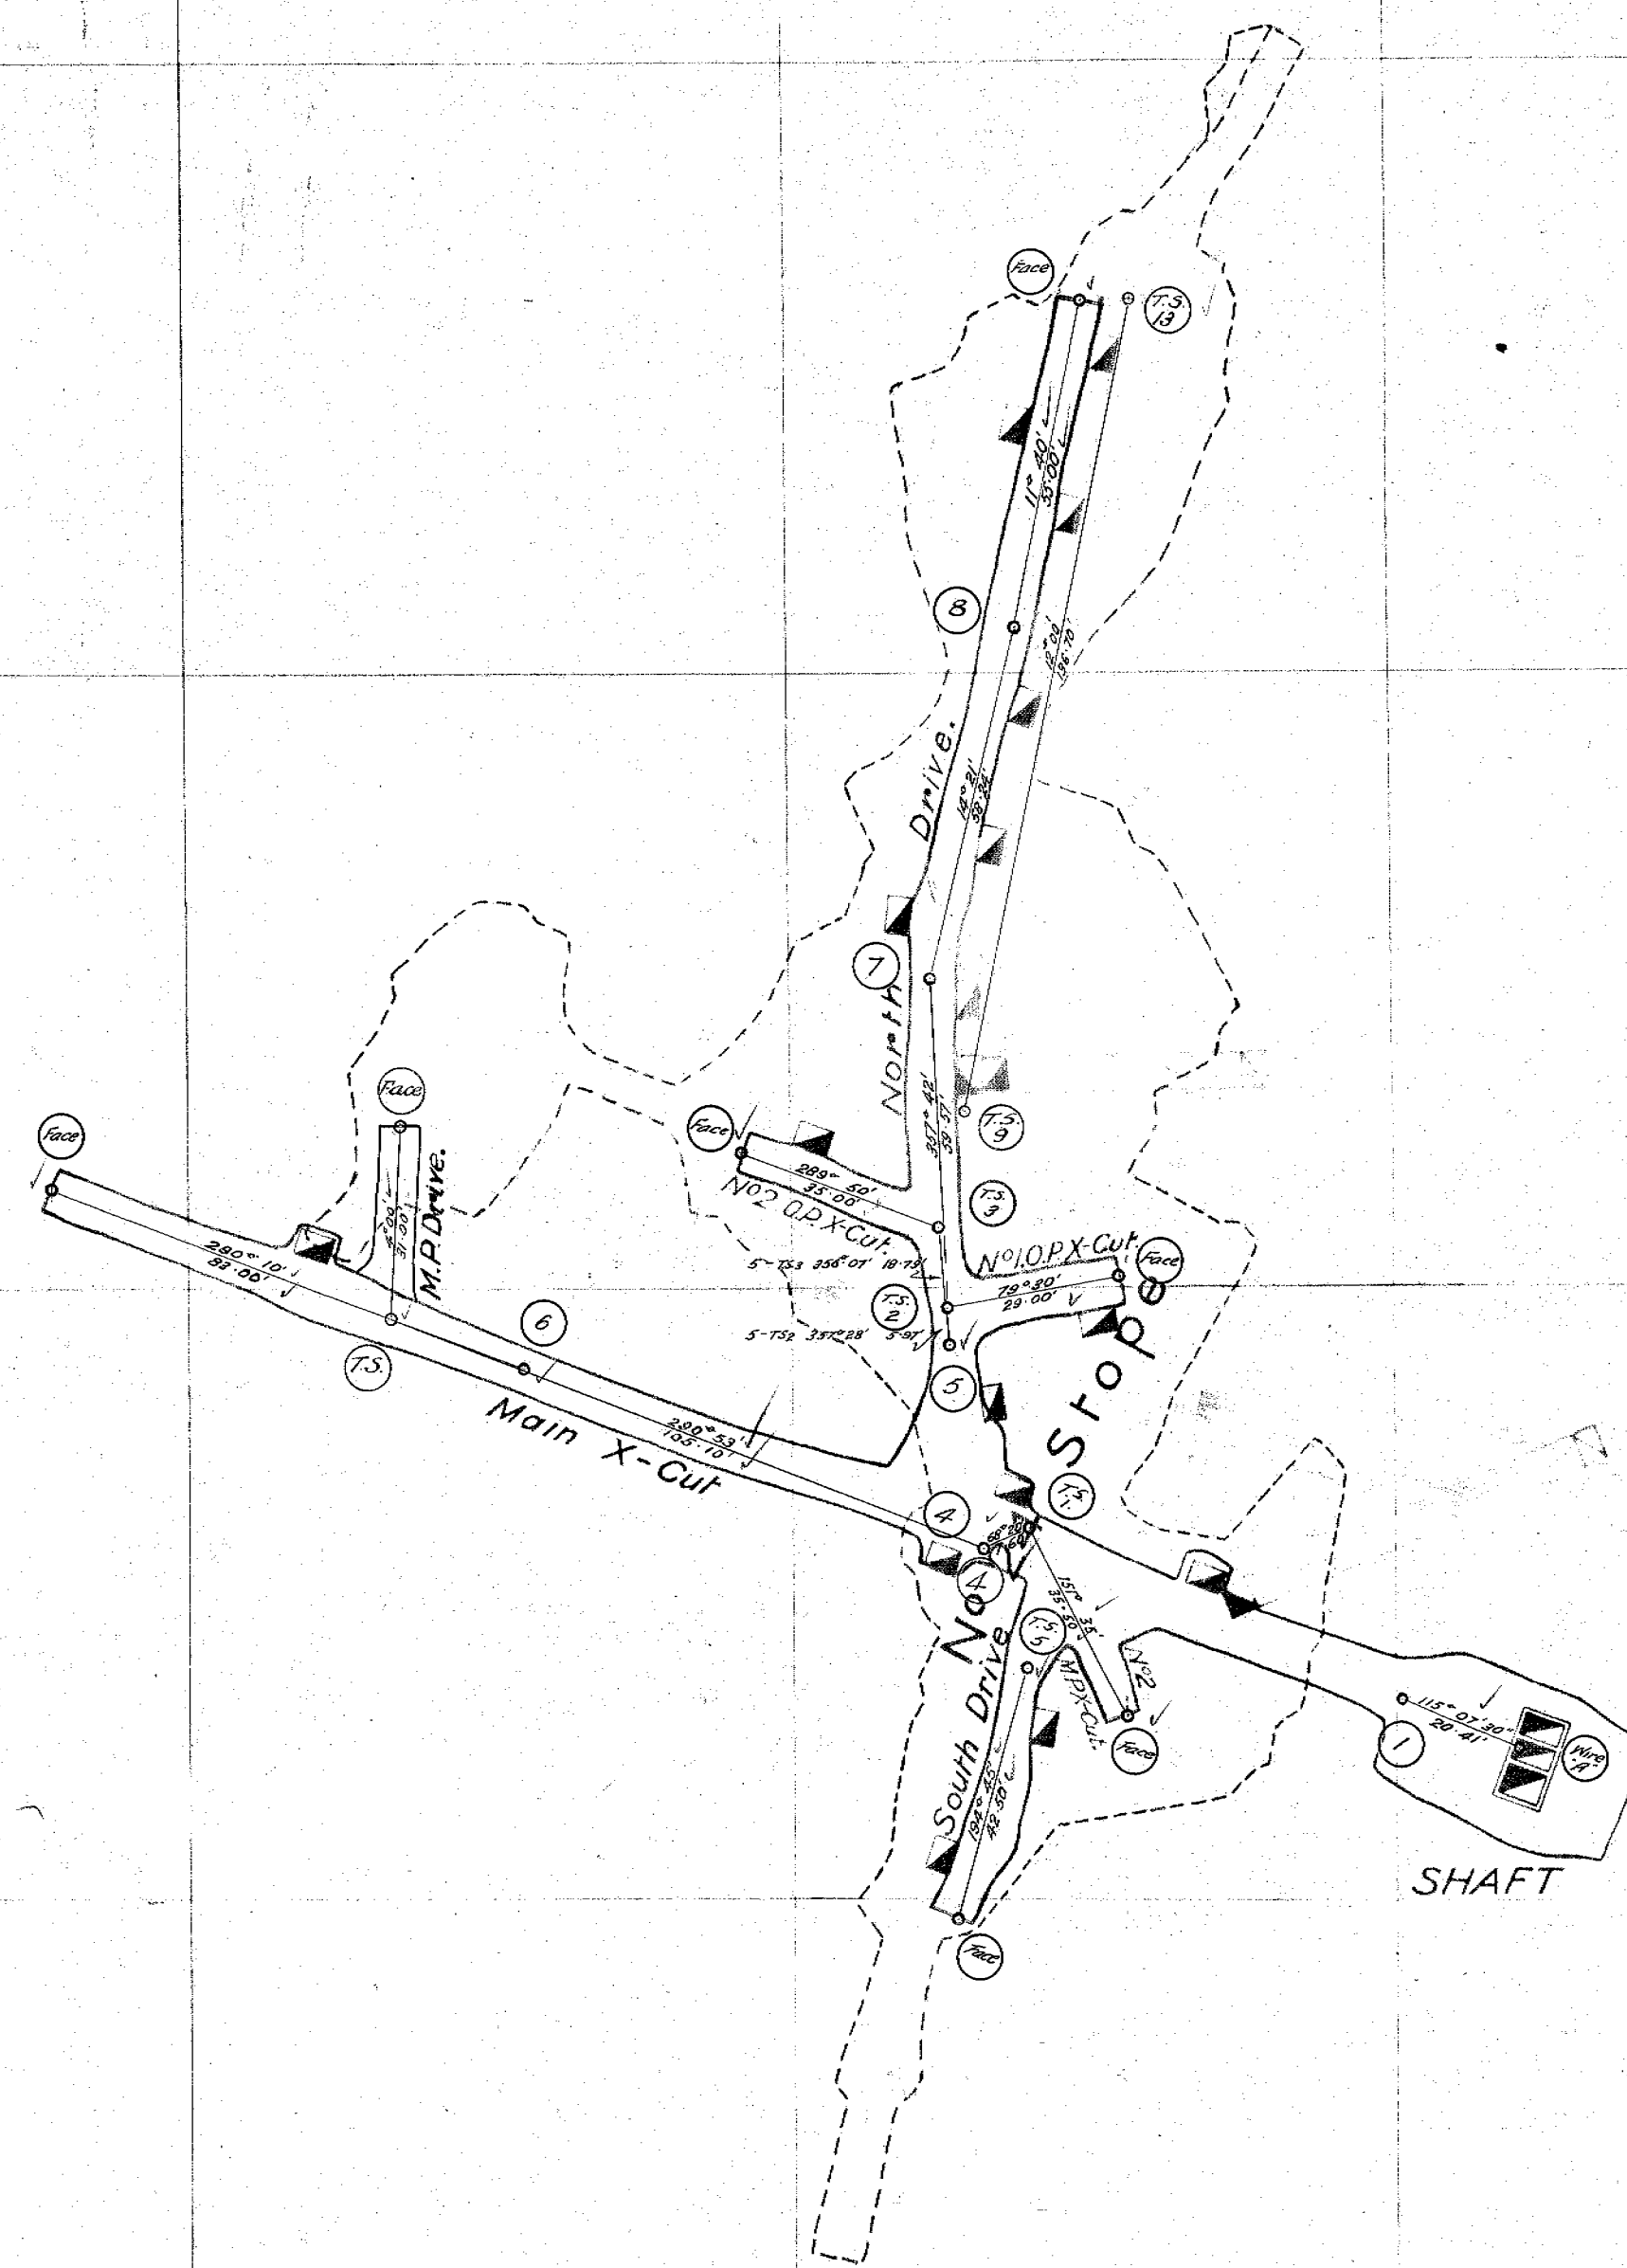


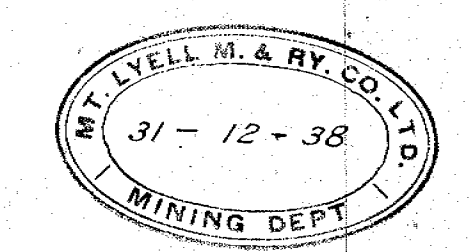

THE MOUNT LYELL M. & R. CO. LTD. LYELL COMSTOCK MINE.

No. 8 LEVEL.

SCALE - 1 INCH = 30 FEET

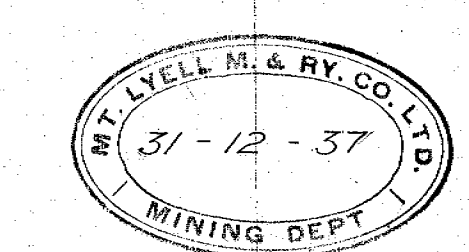

[Signature] GENERAL MANAGER *[Signature]* General Manager
[Signature] MINE SUPERINTENDENT *[Signature]* Mine Superintendent