


56-52

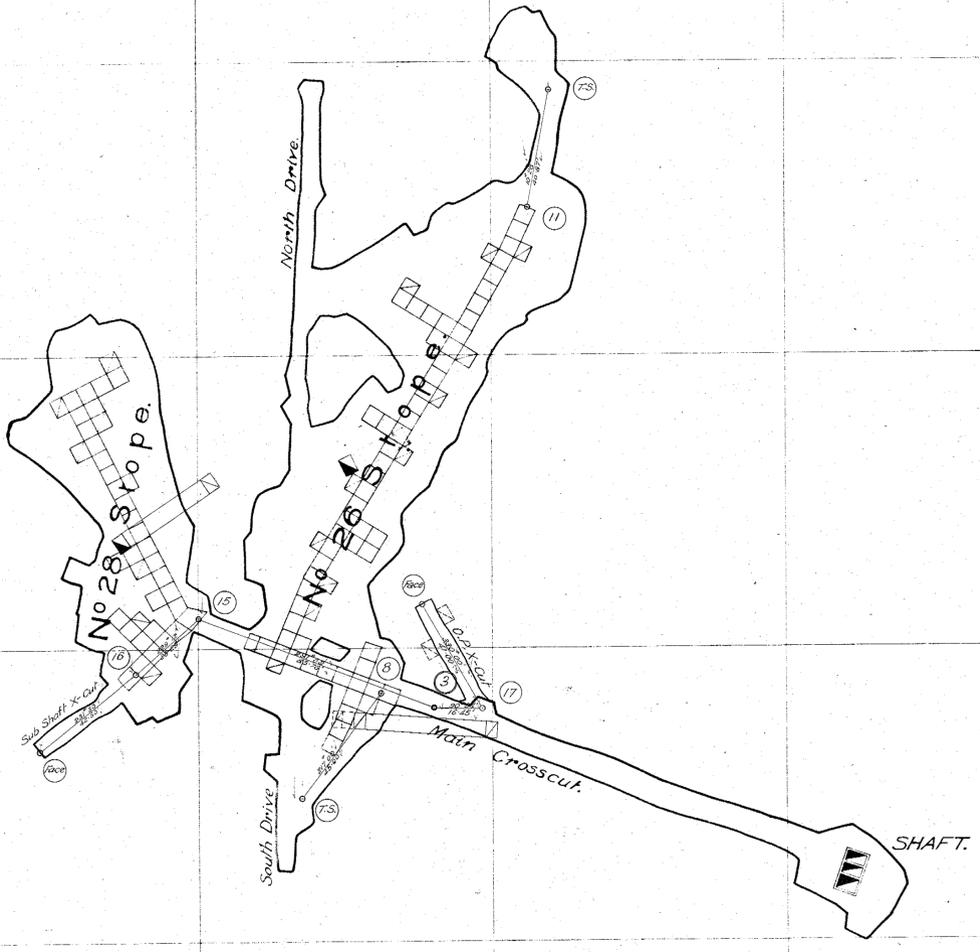

THE MOUNT LYELL M. & R. CO. LTD.

LYELL COMSTOCK MINE.

No 10 LEVEL.

SCALE - 1 INCH = 30 FEET.

*R. Murray* General Manager

*G. Red. Jenkins* Mine Superintendent

*R. Murray* General Manager

*G. Red. Jenkins* Mine Superintendent



*17/9/45*