


5 cm

56-53

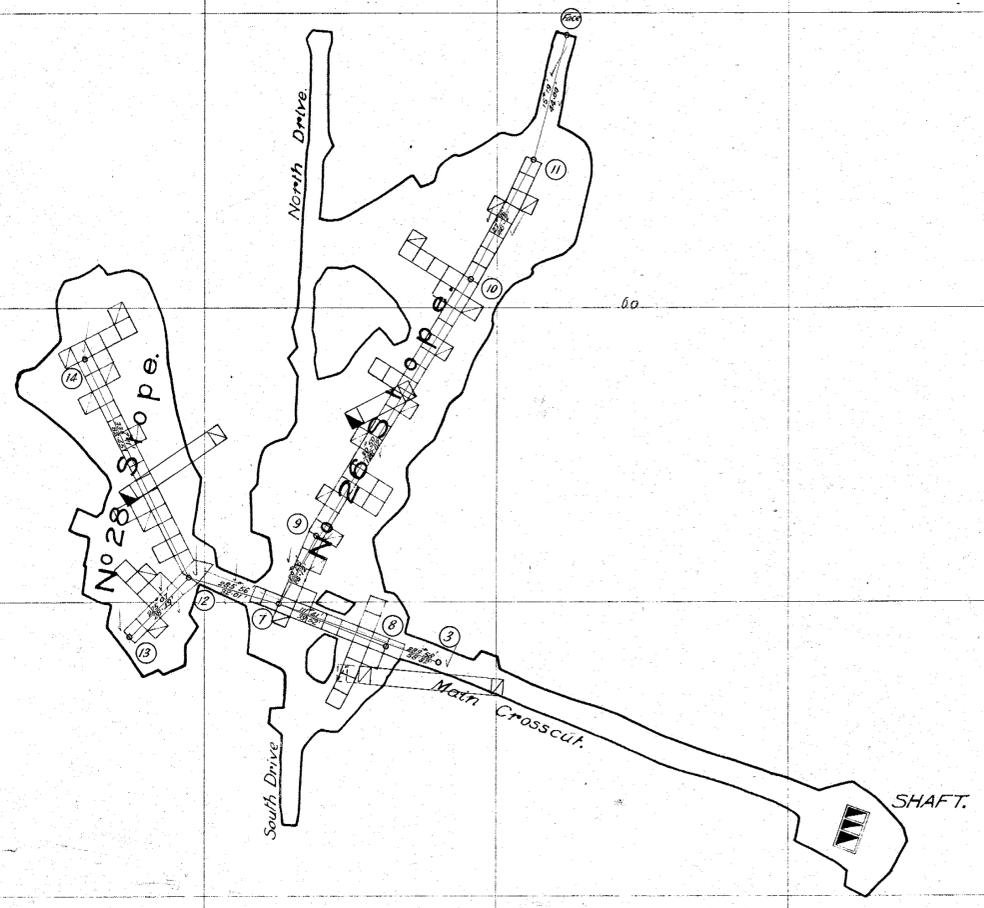

THE MOUNT LYELL M. & R. CO. LTD.

LYELL COMSTOCK MINE.

No 10 LEVEL.

SCALE = 1 INCH = 30 FEET.

R. H. Williams General Manager

A. H. Johnson Mine Superintendent



E. J. [unclear]
6/1/41