
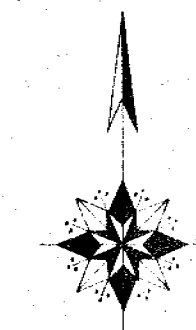


56-56

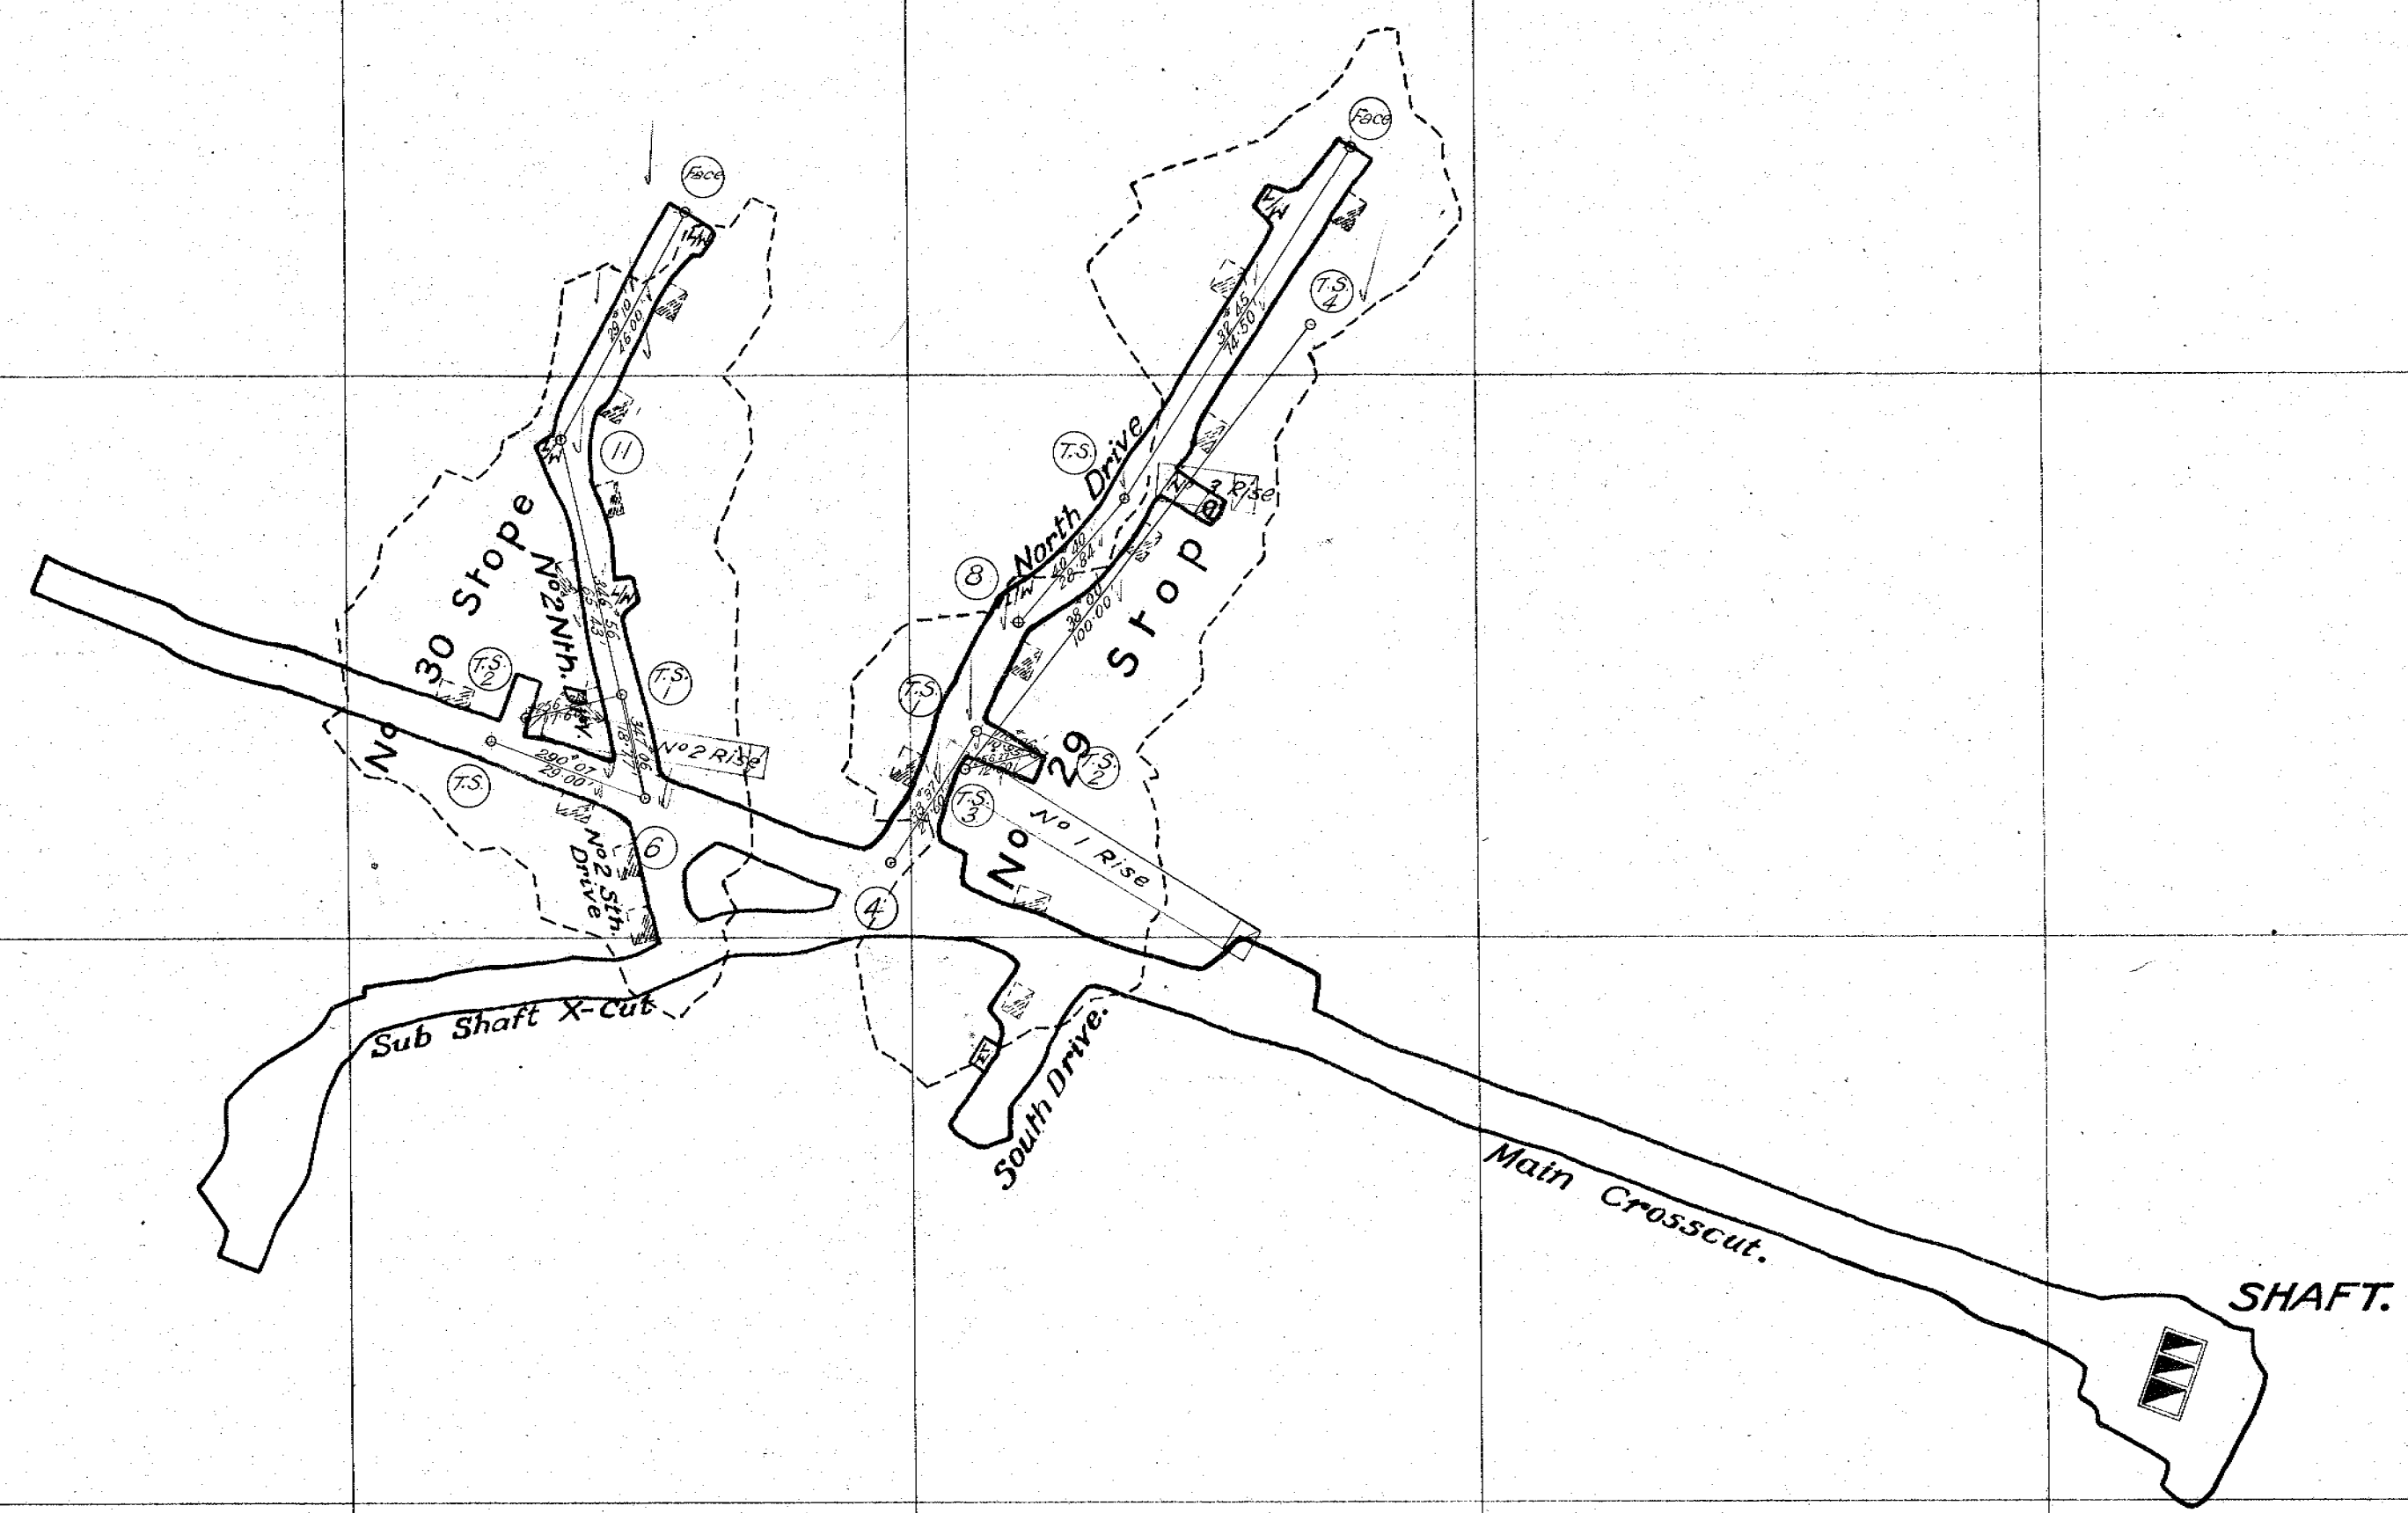


THE MOUNT LYELL M. & R. CO. LTD.

LYELL COMSTOCK MINE.

No 11 LEVEL.

SCALE :- 1 INCH = 30 FEET.

[Signature] General Manager
[Signature] Mine Superintendent

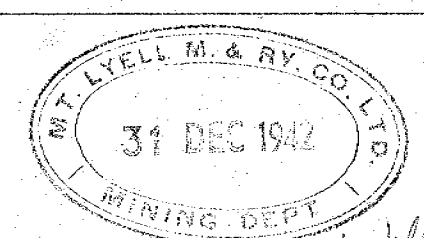

[Handwritten notes]
17/9/43

56-56

