


56-59

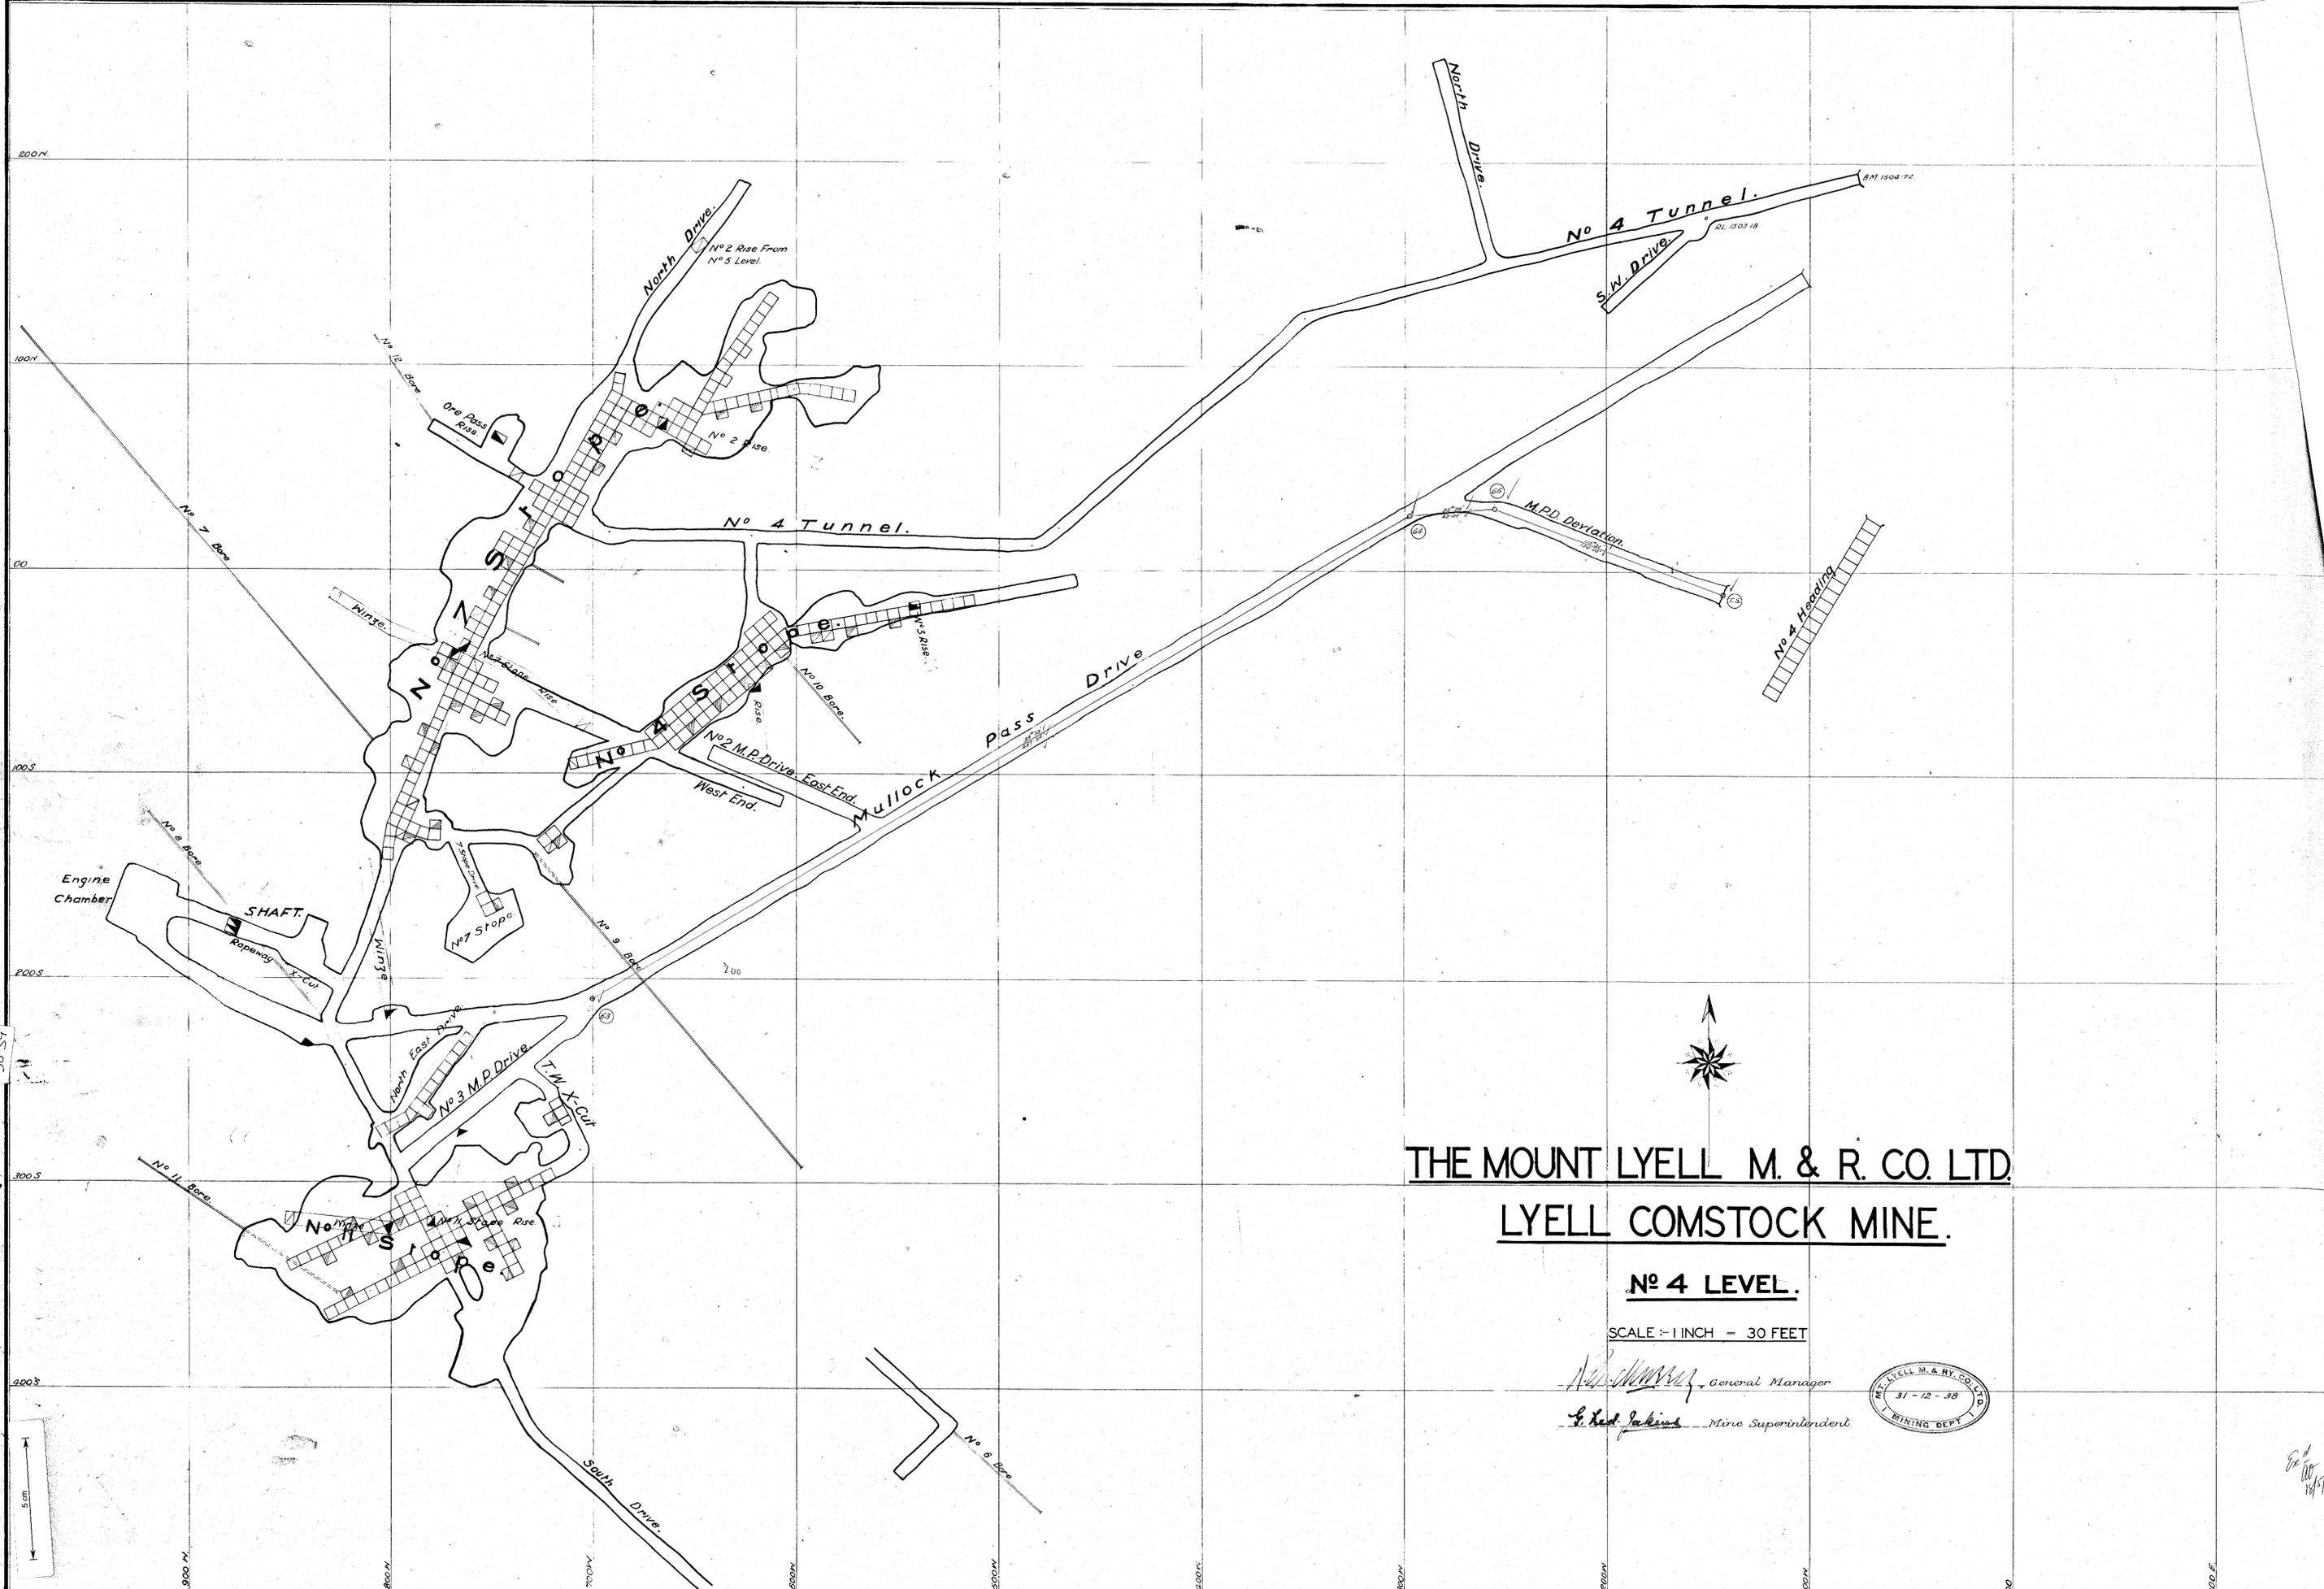

**No. 4 LEVEL.**  
 SCALE = 1 INCH = 30 FEET

*[Signature]* General Manager  
*[Signature]* Mine Superintendent



*[Handwritten initials]*