


56-63

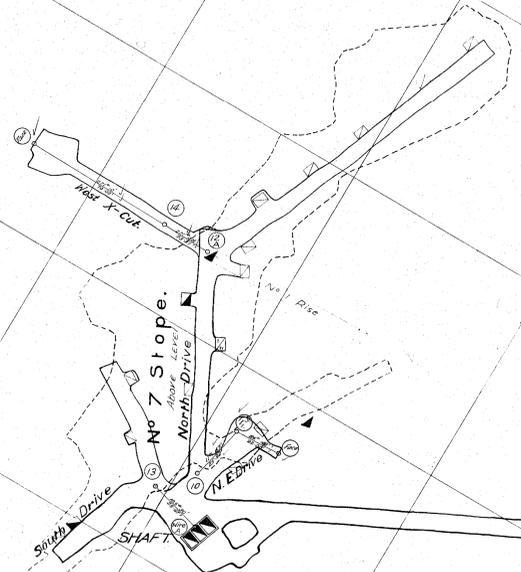

Main Tunnel

TASMAN-CROWN SHAFT

THE MOUNT LYELL M. & R. CO. LTD.
 LYELL COMSTOCK MINE.

No. 7 LEVEL.

SCALE 1/4 INCH = 30 FEET



C. P. ... GENERAL MANAGER.
S. ... MINE SUPERINTENDENT.

R. ... General Manager
S. ... Mine Superintendent

