


58-67

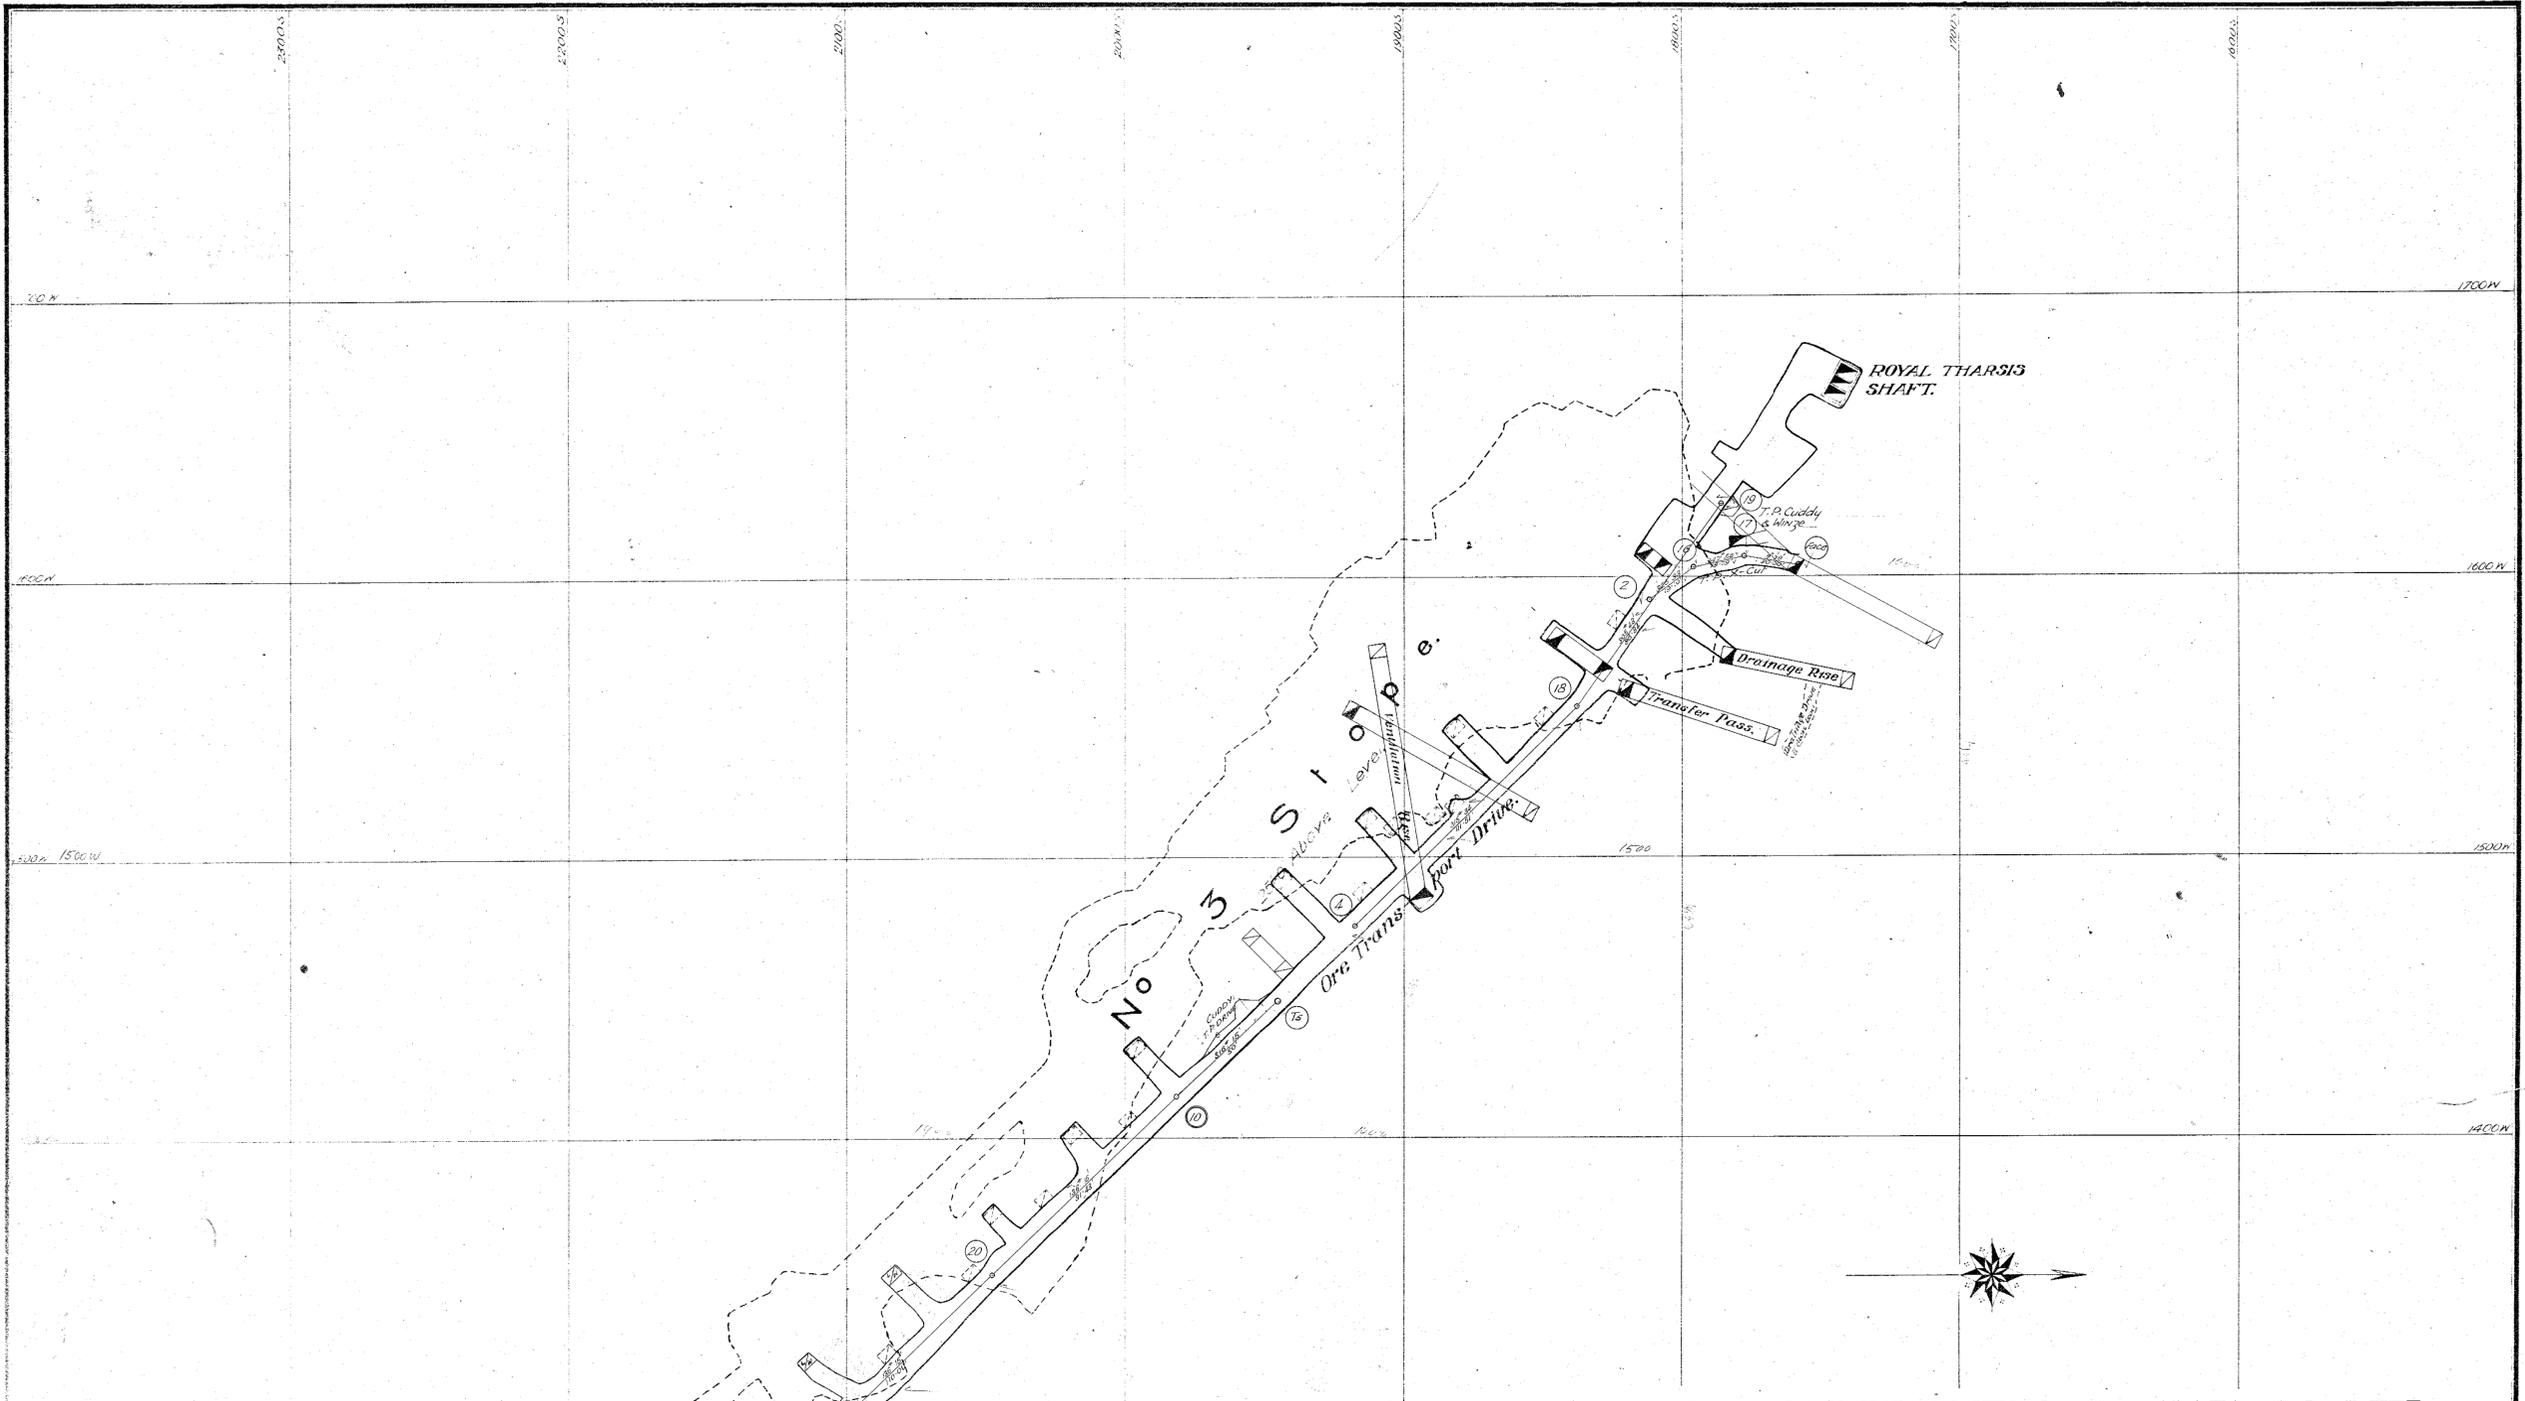

**THE MOUNT LYELL M. & R. CO. LTD.**

**ROYAL THARSIS MINE.**


**No 3 LEVEL.**

SCALE : 1 INCH = 30 FEET.

*R. H. ...* General Manager  
*S. Fred. Jenkins* Mine Superintendent



*R. H. ...* General Manager  
*S. Fred. Jenkins* Mine Superintendent

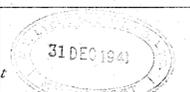

*R. H. ...* General Manager  
*S. Fred. Jenkins* Mine Superintendent



17/12/43  
18/12/43