


EL-20

3
11359
M

56-69

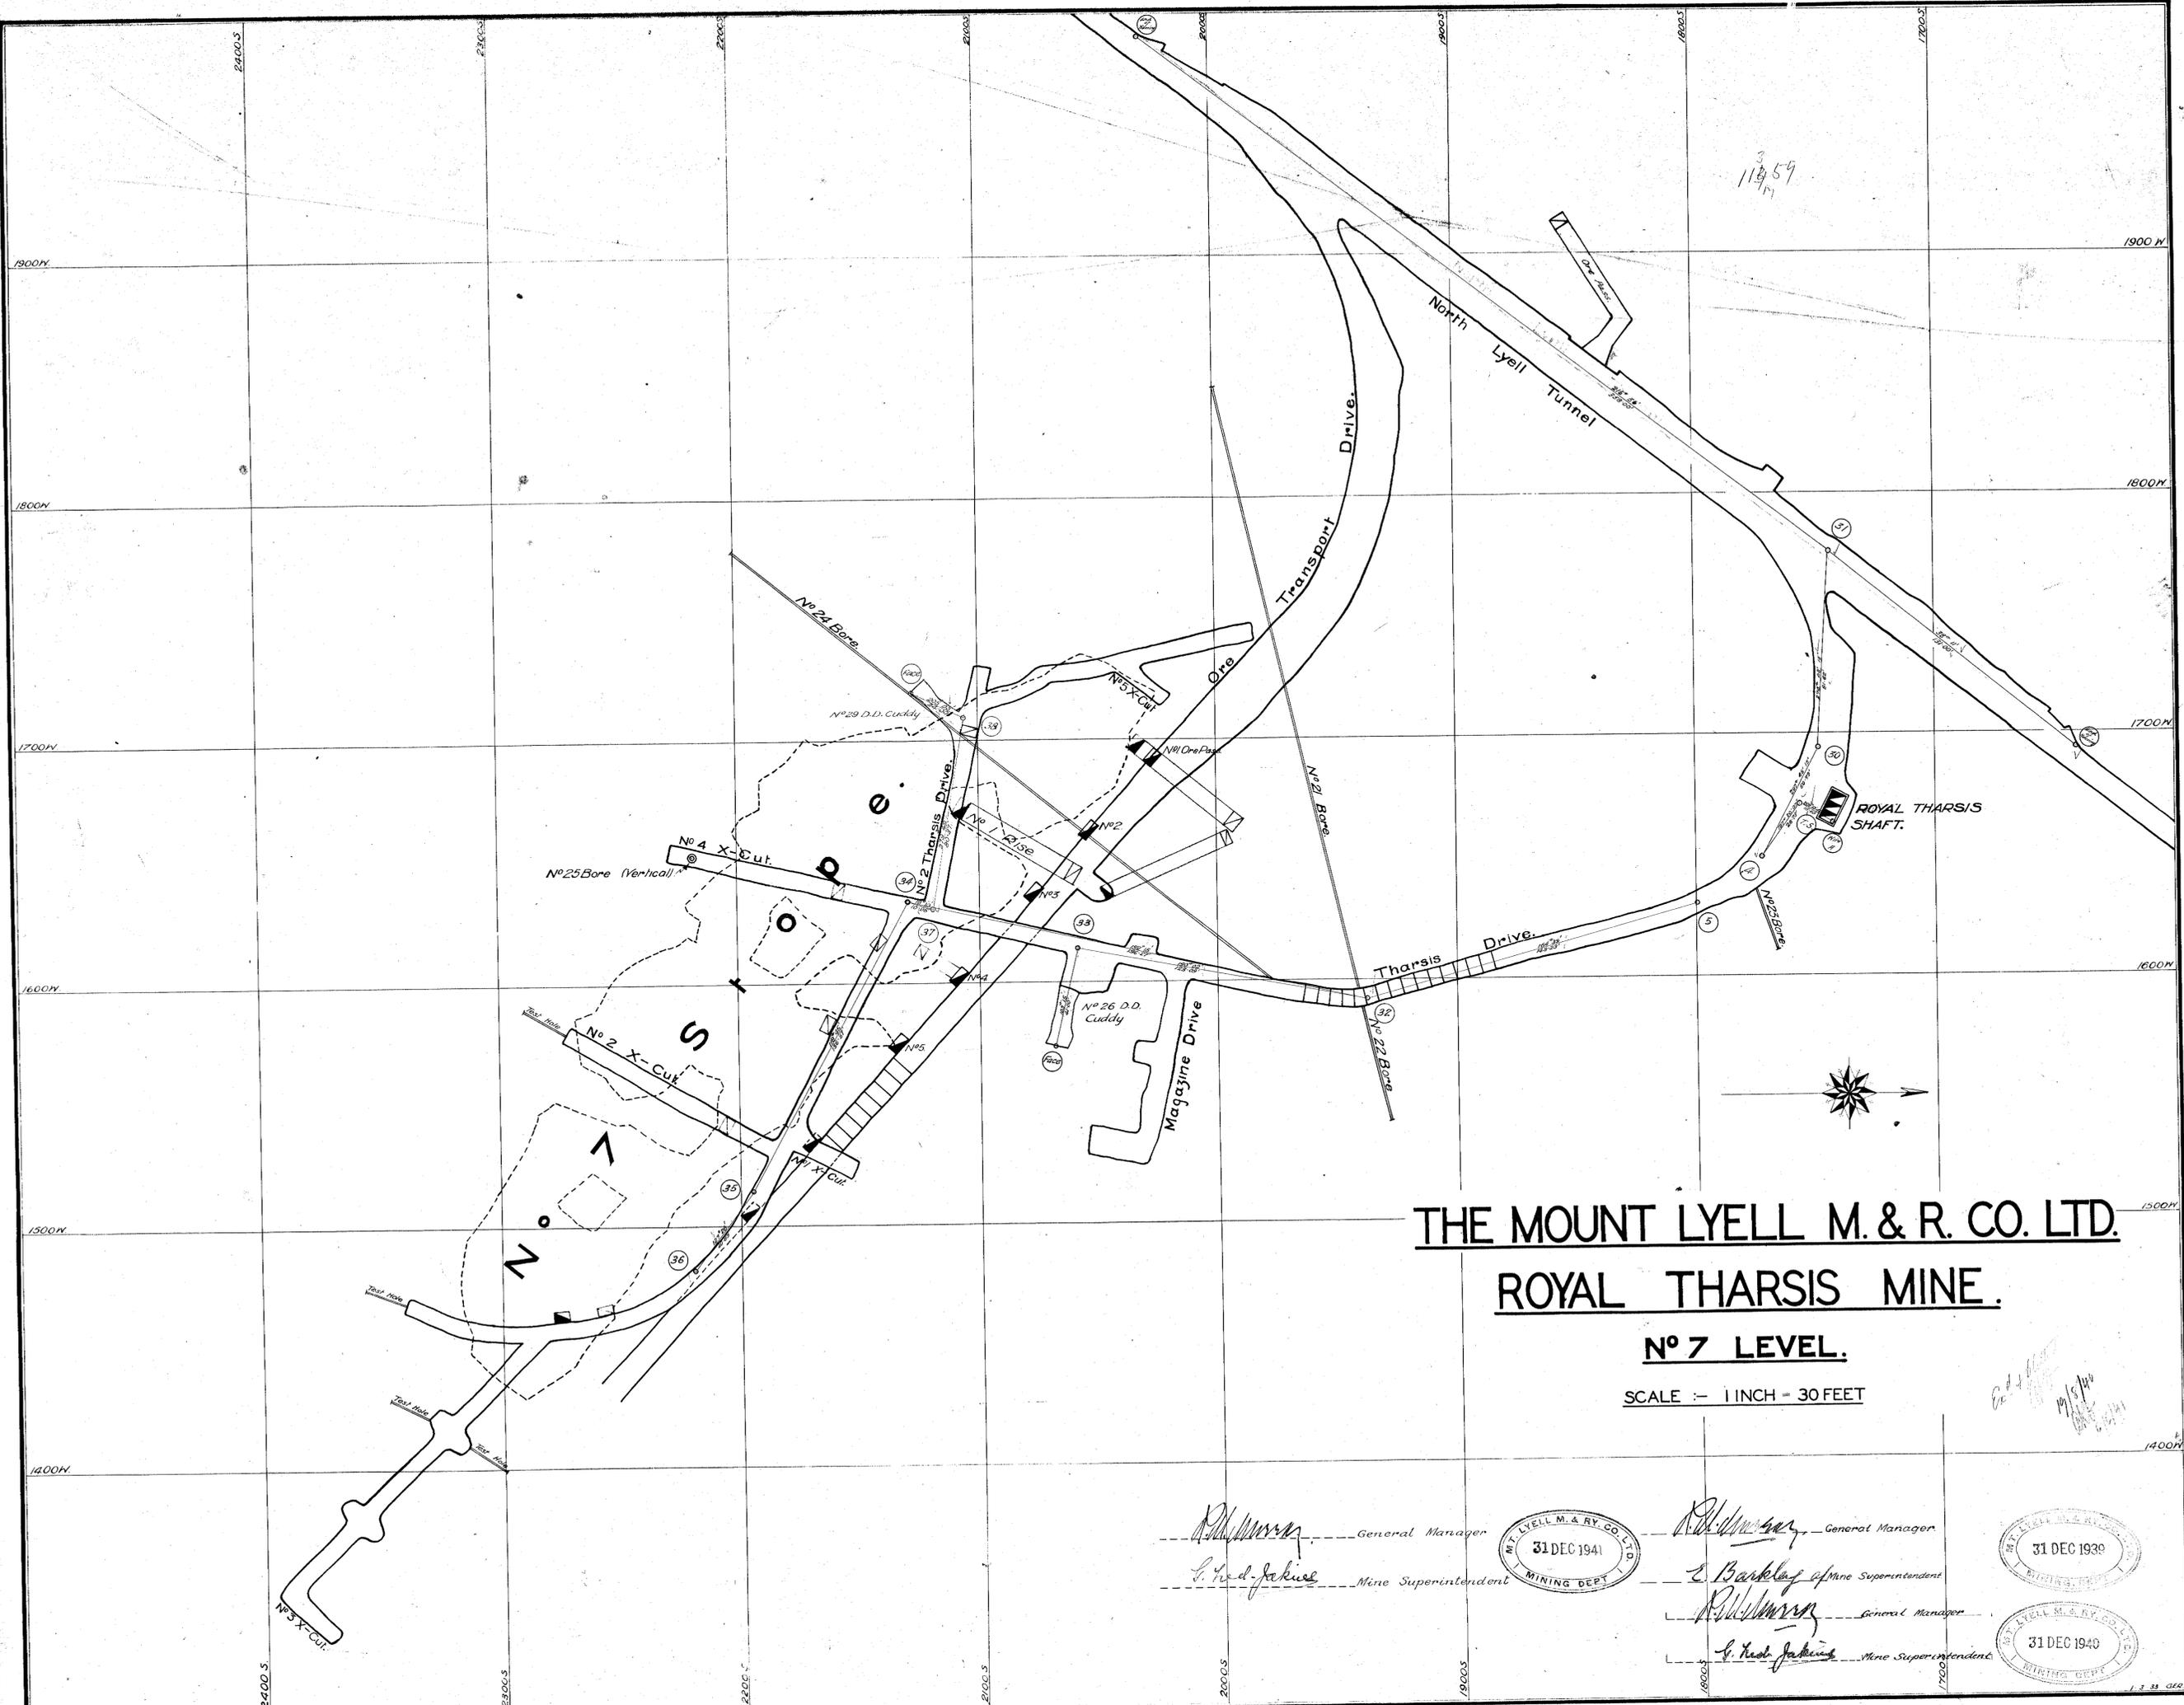

THE MOUNT LYELL M. & R. CO. LTD.
ROYAL THARSIS MINE.

No. 7 LEVEL.
 SCALE :- 1 INCH = 30 FEET

5 cm

R. H. Murray General Manager
L. Noel Jenkins Mine Superintendent



R. H. Murray General Manager
L. Noel Jenkins Mine Superintendent

