


56-71

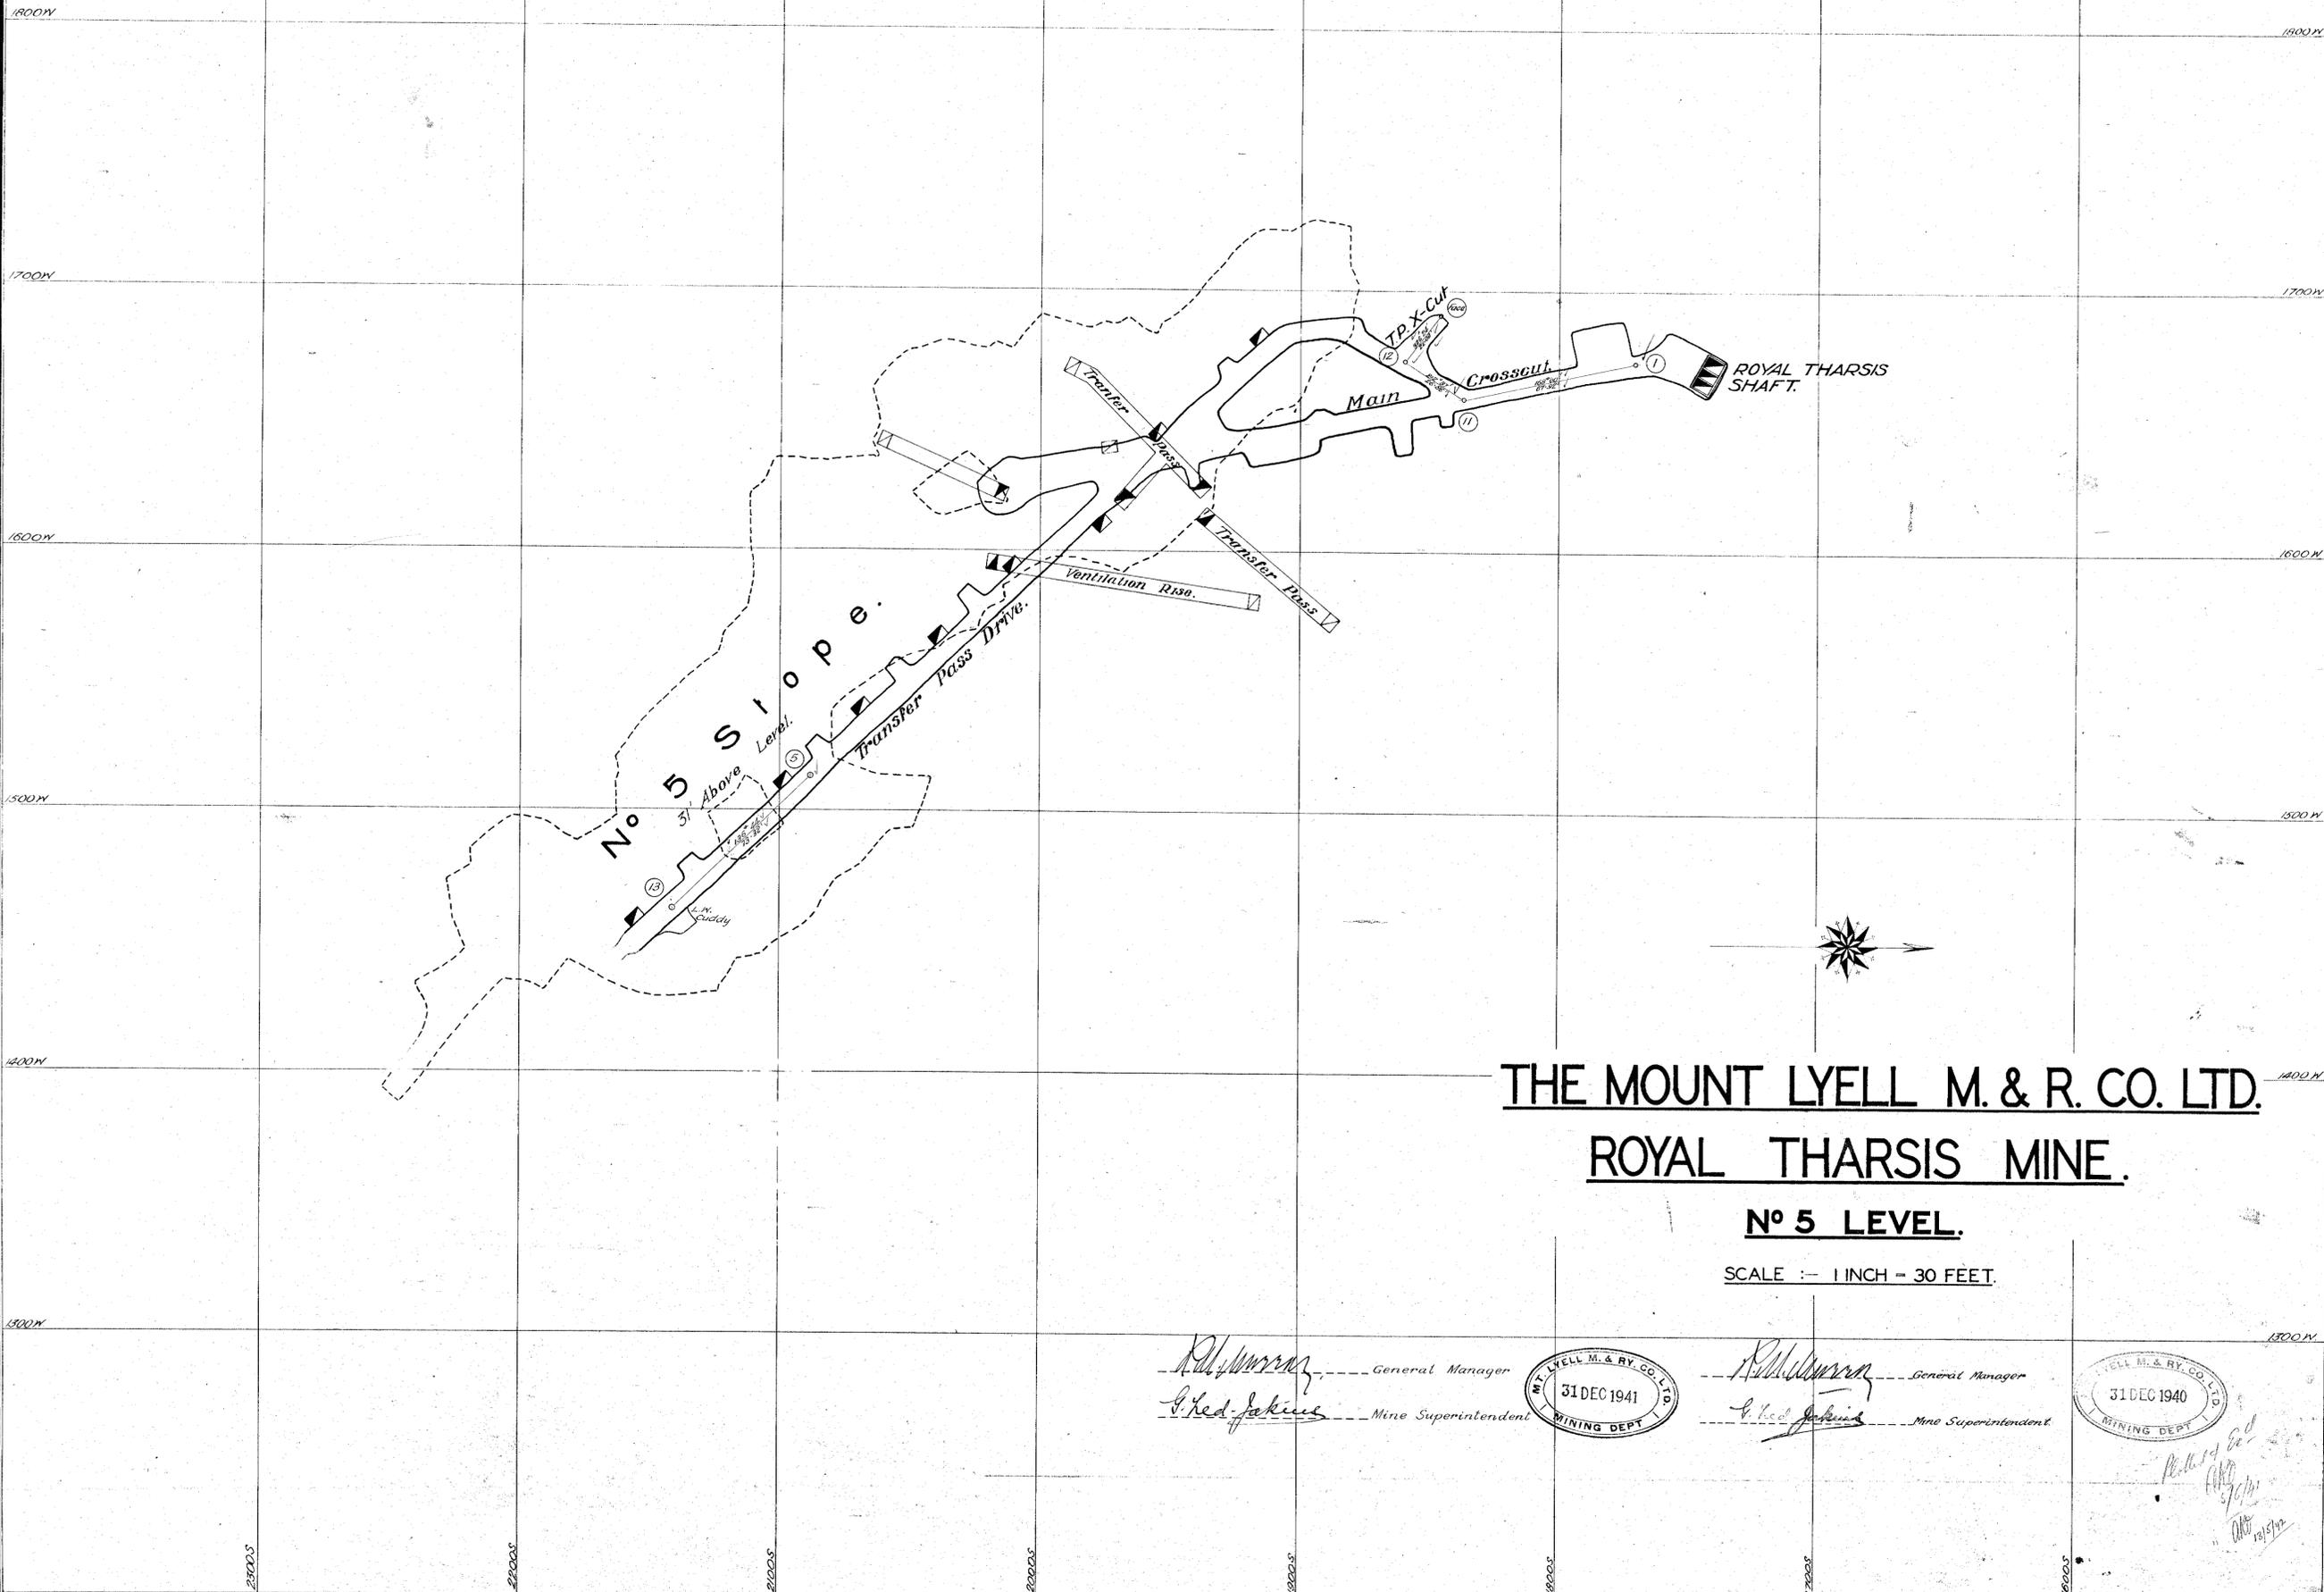


THE MOUNT LYELL M. & R. CO. LTD.

ROYAL THARSIS MINE.


No 5 LEVEL.

SCALE :- 1 INCH = 30 FEET.

56-71

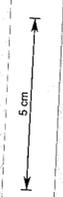

R. W. Murray General Manager
G. Hed. Jenkins Mine Superintendent

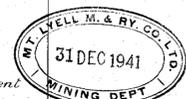

R. W. Murray General Manager
G. Hed. Jenkins Mine Superintendent



Arthur G. Bell
AKG
AKG
AKG