


56-72

56-72

1" = 30 FEET

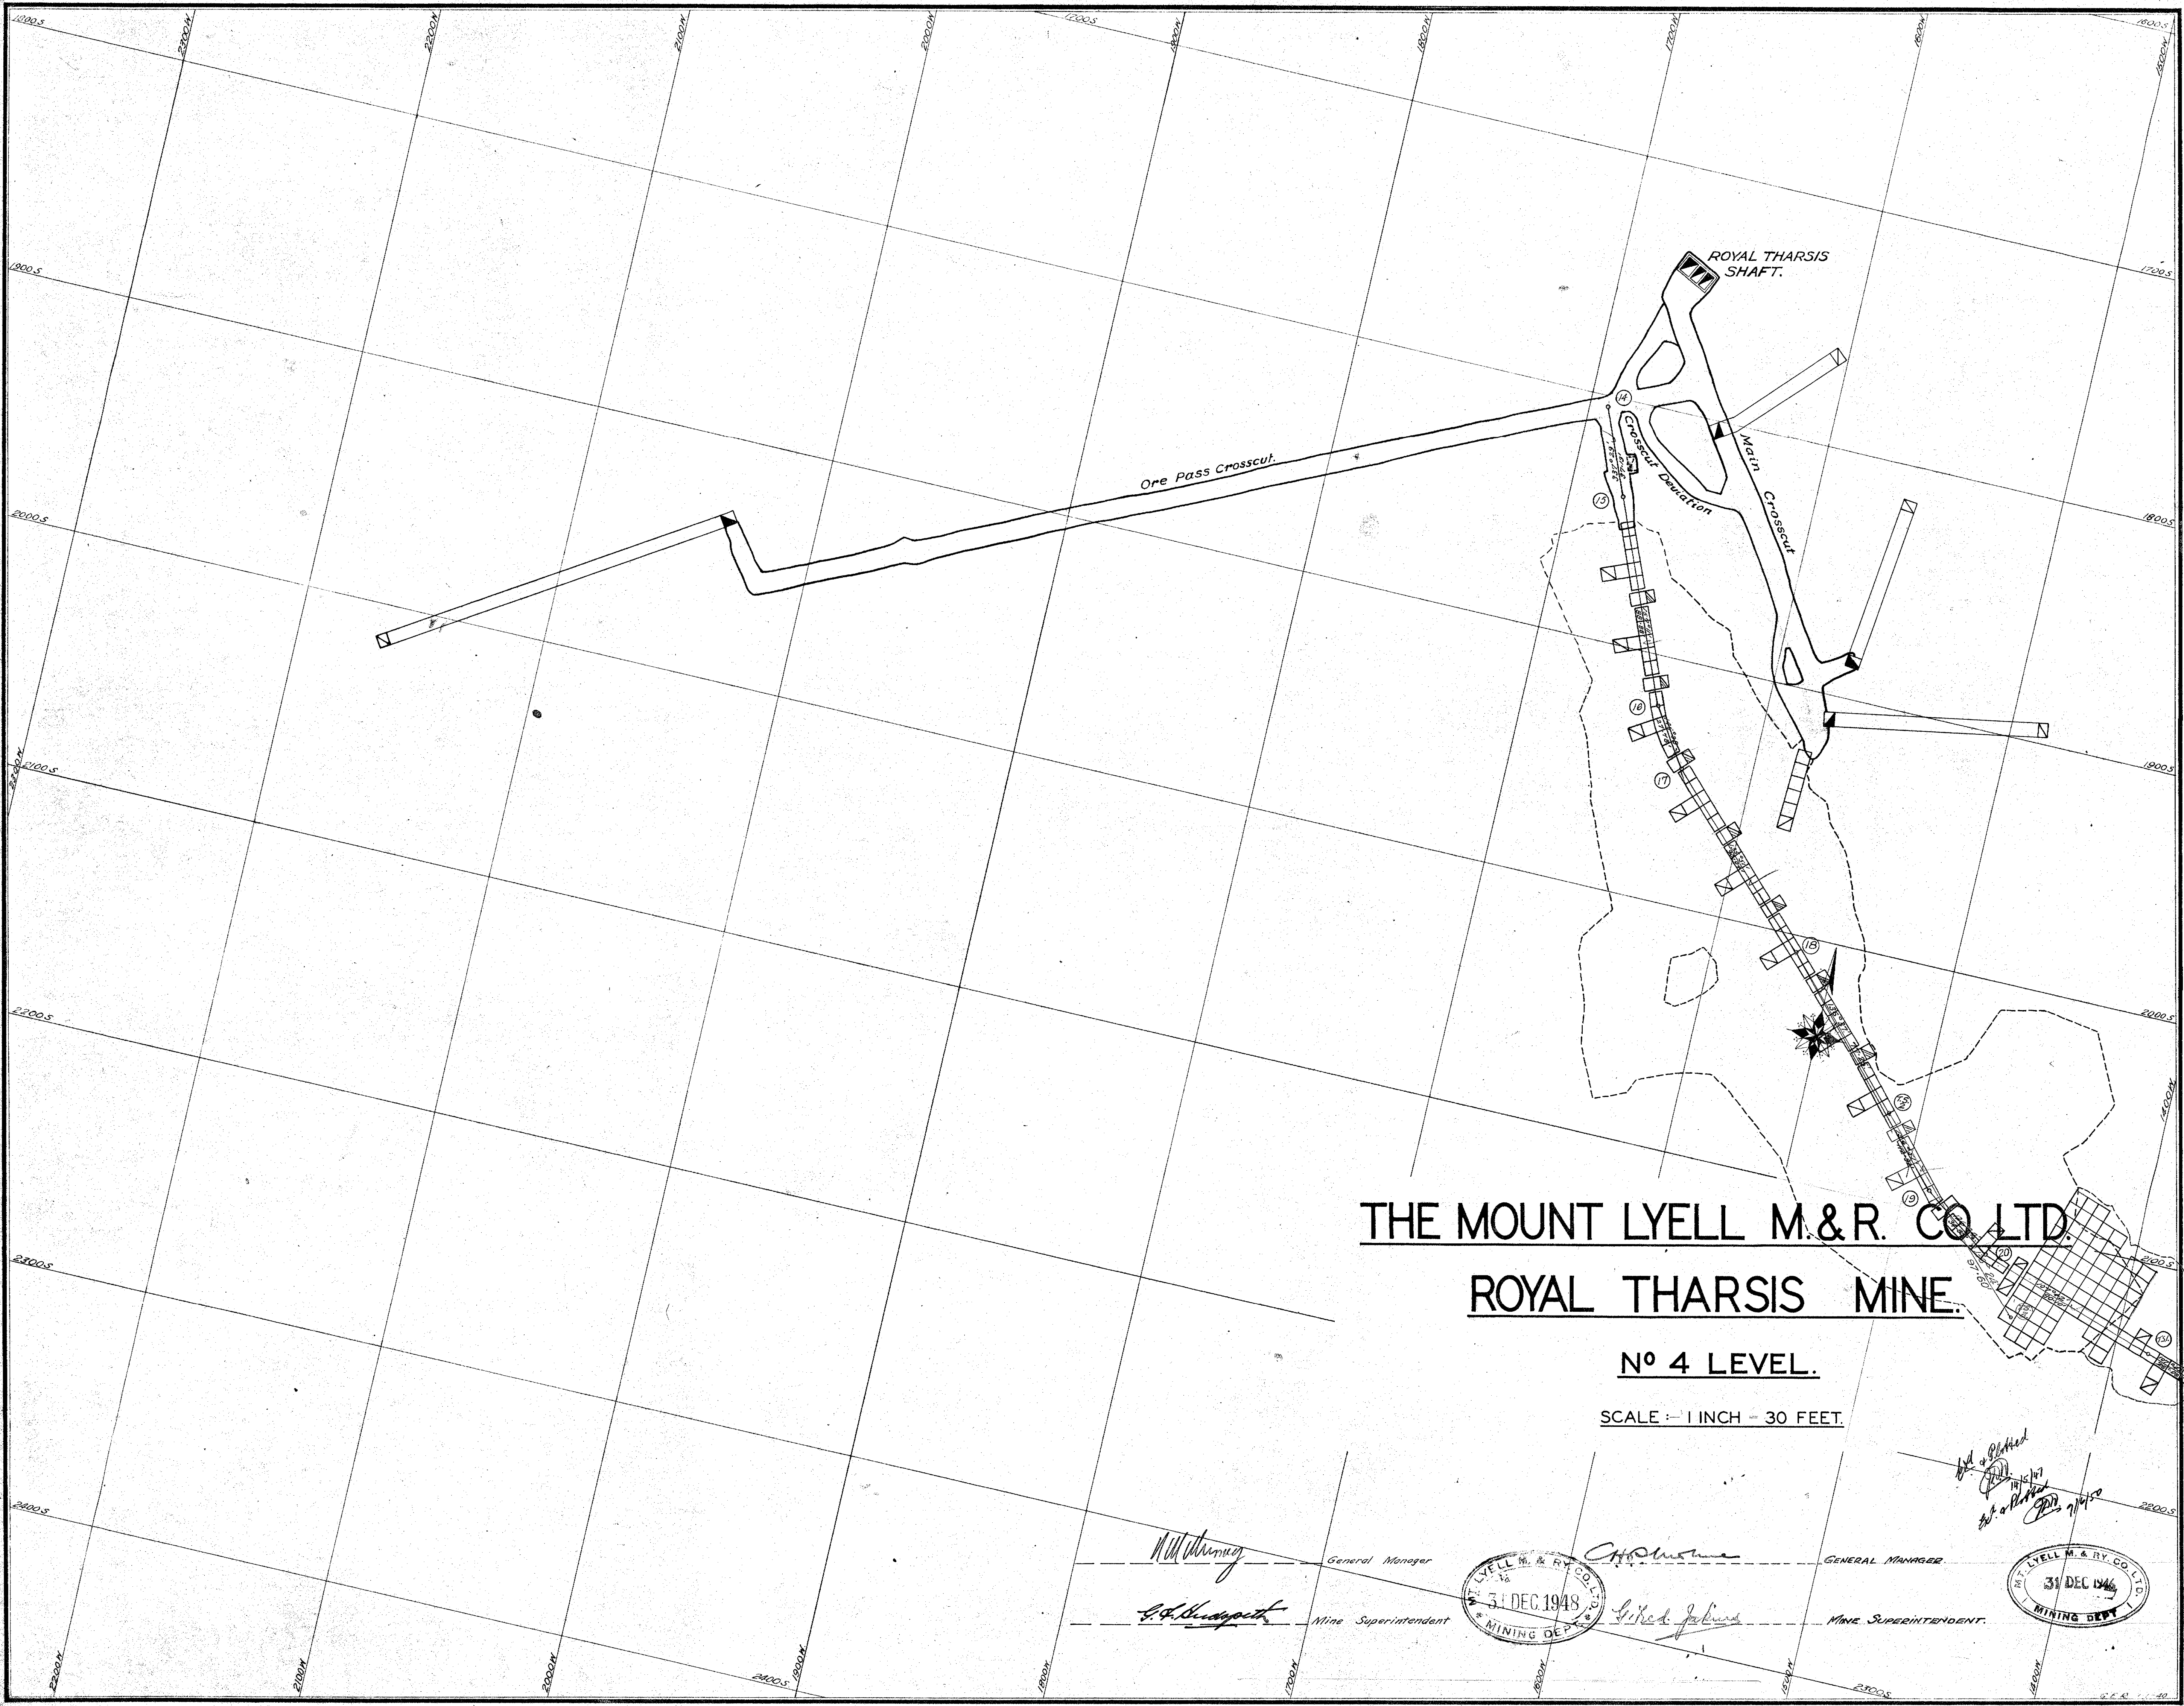

THE MOUNT LYELL M. & R. CO. LTD.
ROYAL THARSIS MINE.

NO 4 LEVEL.

SCALE: 1 INCH = 30 FEET.

W. H. Whiting

General Manager

S. F. Macgregor

Mine Superintendent



Chas. J. Jones

General Manager

Mine Superintendent

