


56-73

56-73

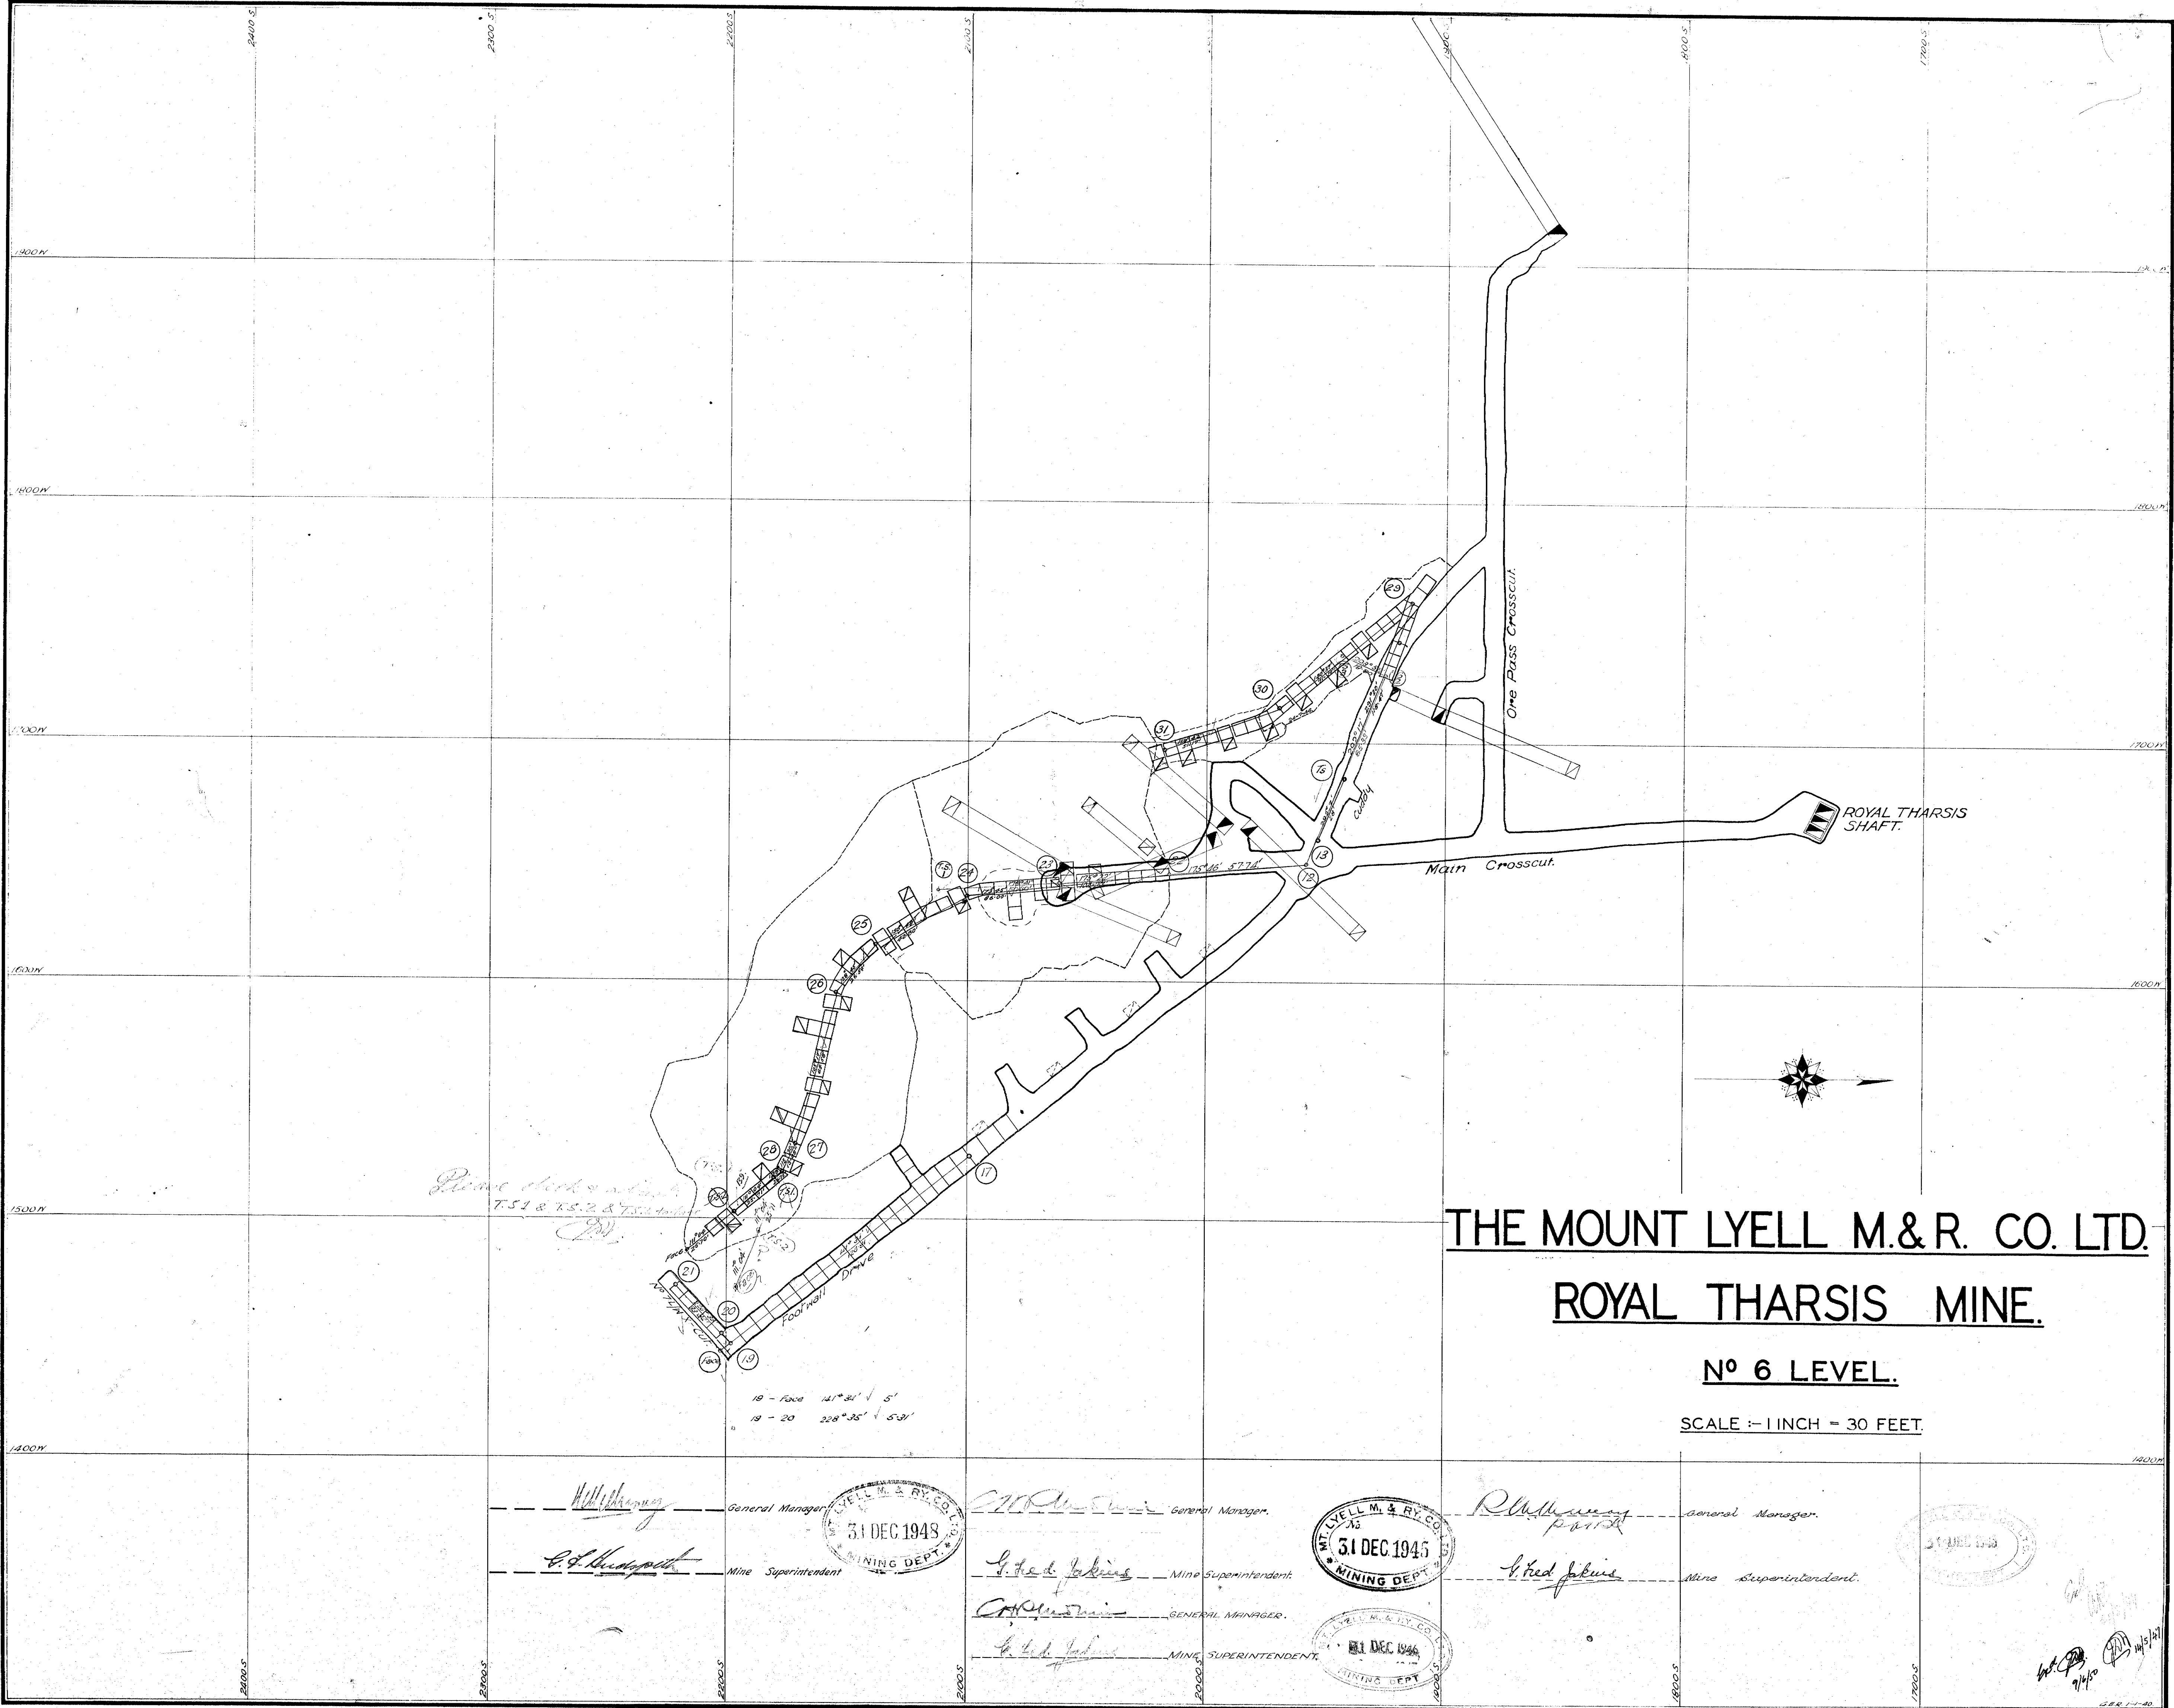

THE MOUNT LYELL M. & R. CO. LTD.

ROYAL THARSIS MINE.


No 6 LEVEL.

SCALE :- 1 INCH = 30 FEET.

[Signature] General Manager.
[Signature] Mine Superintendent.
31 DEC 1948
MINING DEPT.

[Signature] General Manager.
[Signature] Mine Superintendent.
31 DEC 1948
MINING DEPT.

[Signature] General Manager.
[Signature] Mine Superintendent.

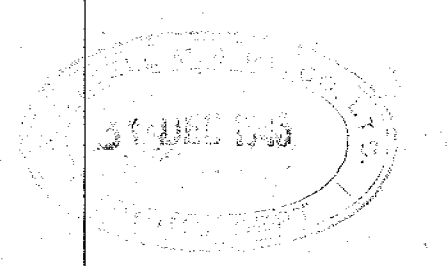

[Handwritten notes and signatures]