


55-714

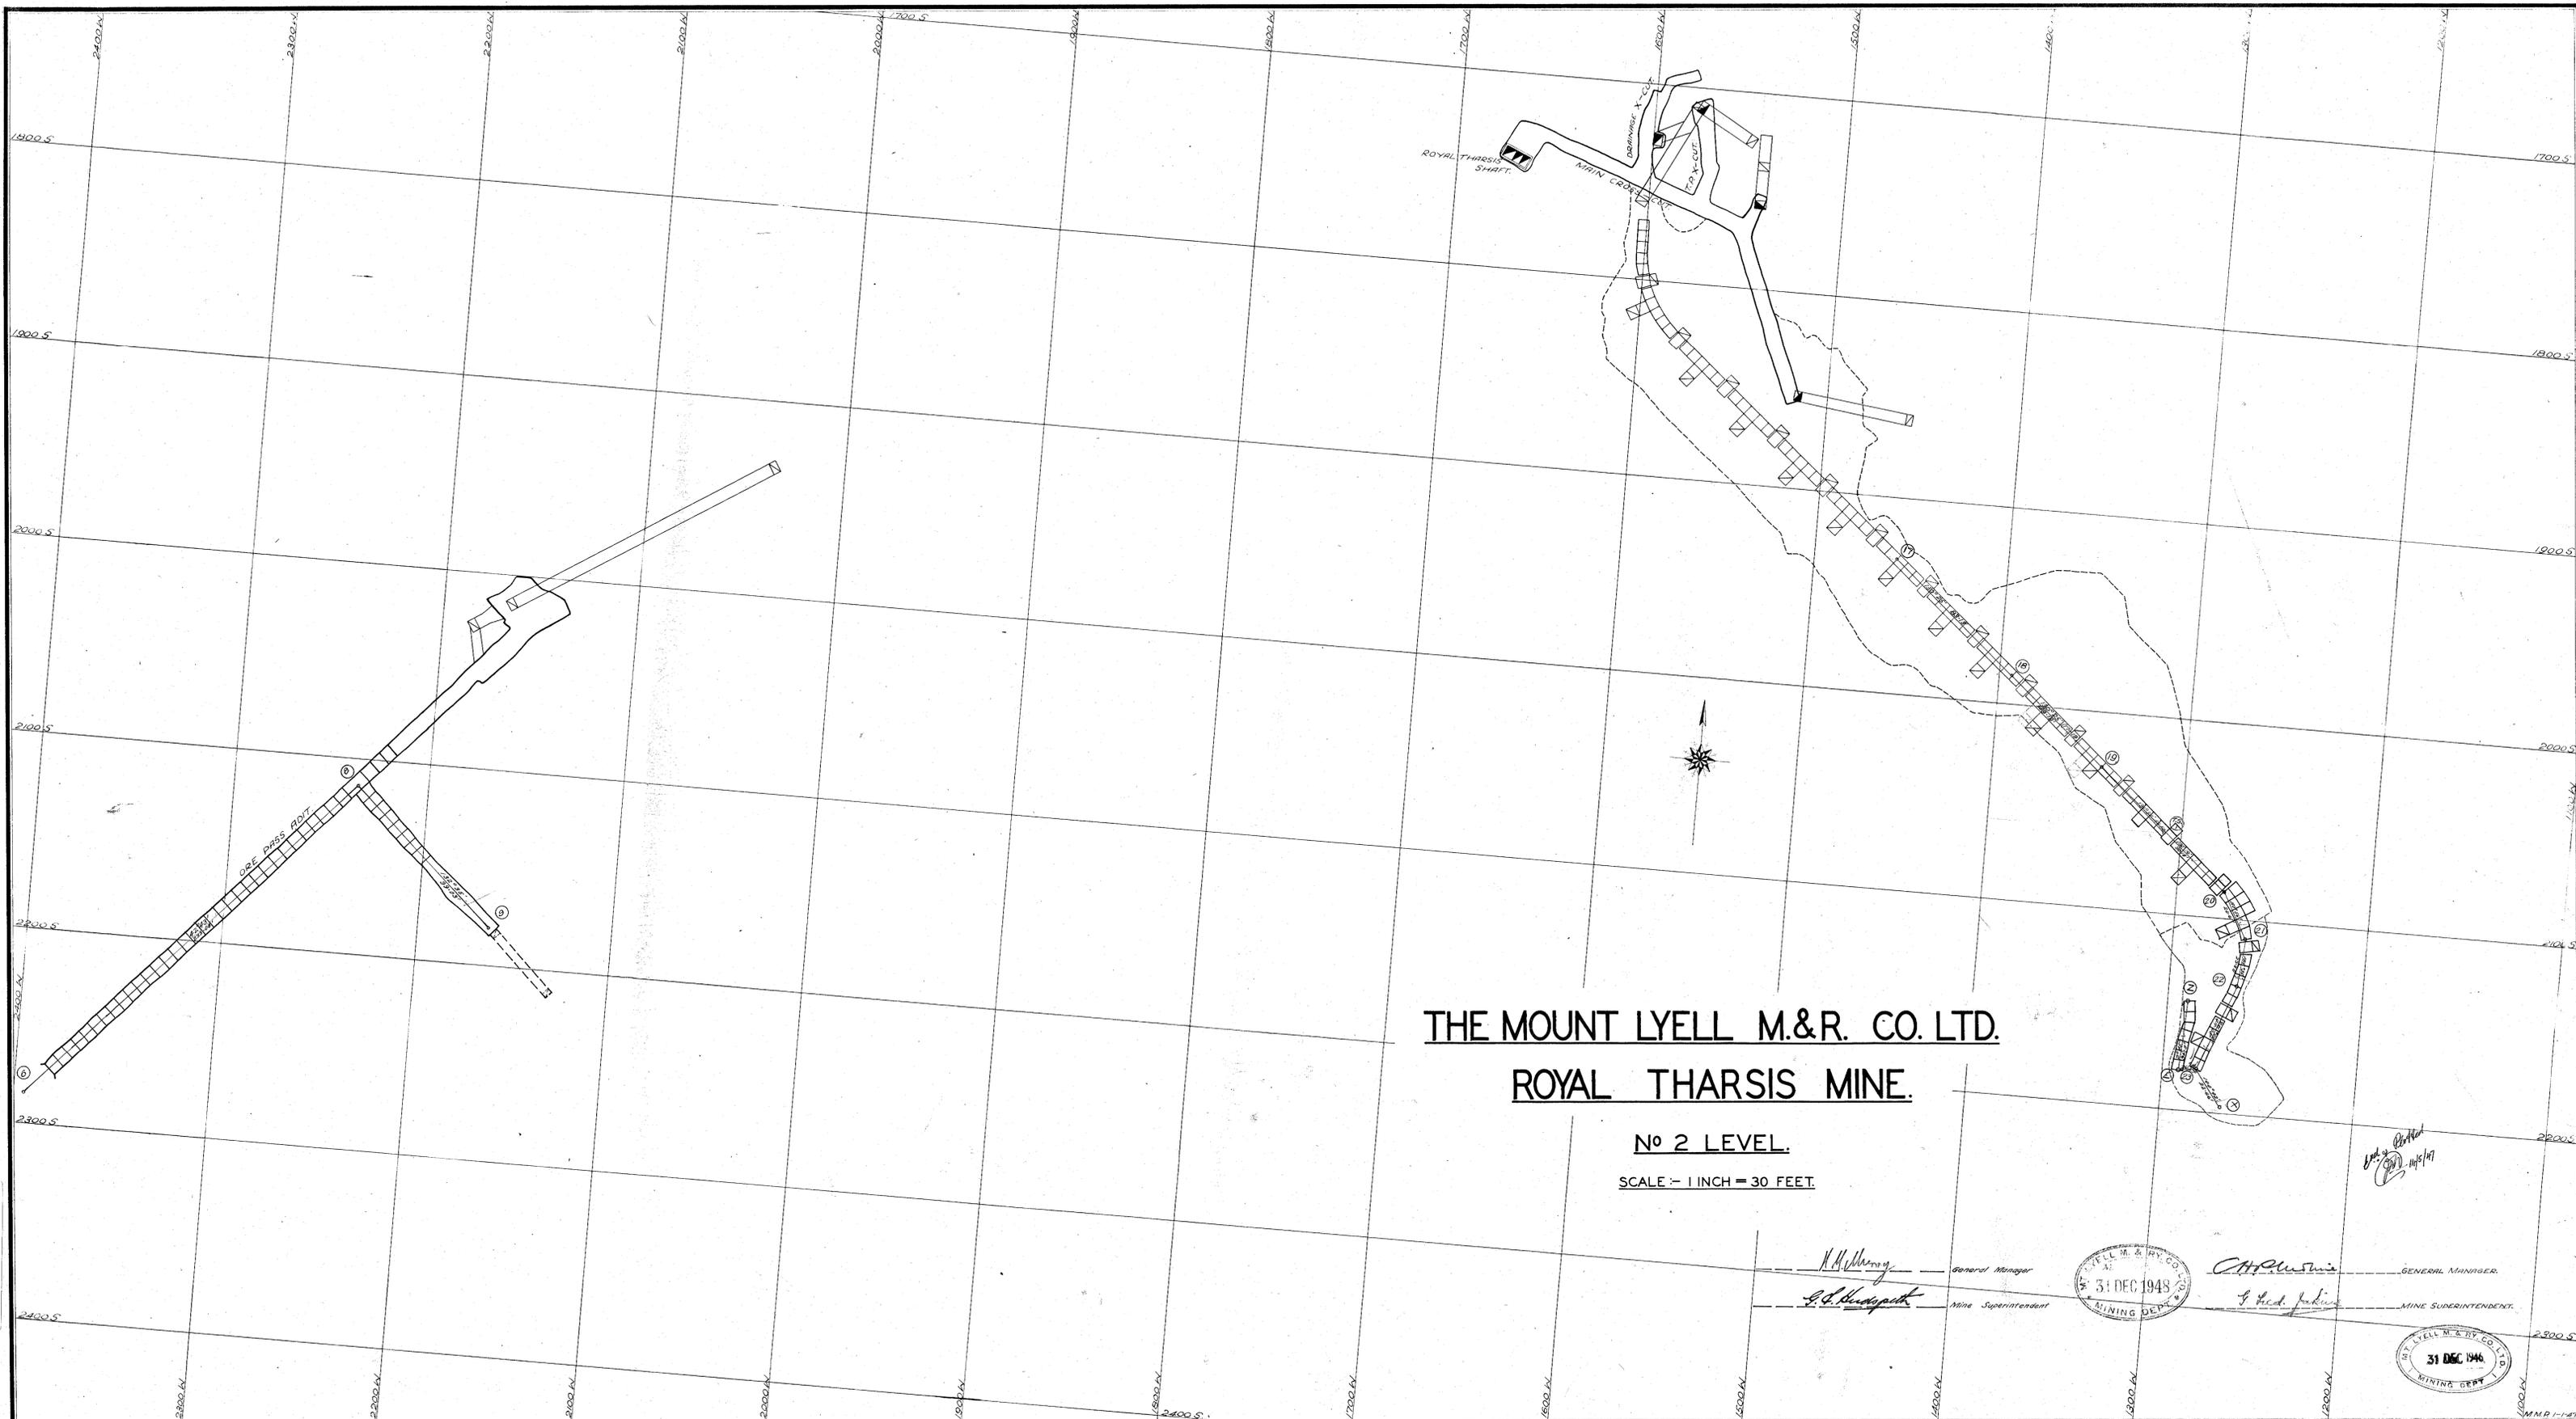

**THE MOUNT LYELL M.&R. CO. LTD.**  
**ROYAL THARSIS MINE.**

**NO 2 LEVEL.**  
 SCALE :- 1 INCH = 30 FEET.

*K.H. Wherry* General Manager  
*G.D. Hargreaves* Mine Superintendent

THE MOUNT LYELL M.&R. CO. LTD.  
 31 DEC 1948  
 MINING DEPT.

*C.H. Pius* GENERAL MANAGER  
*J. H. Jenkins* MINE SUPERINTENDENT

THE MOUNT LYELL M.&R. CO. LTD.  
 31 DEC 1946  
 MINING DEPT.

6 cm

M.M.P. 1-197