


5 cm

56-77

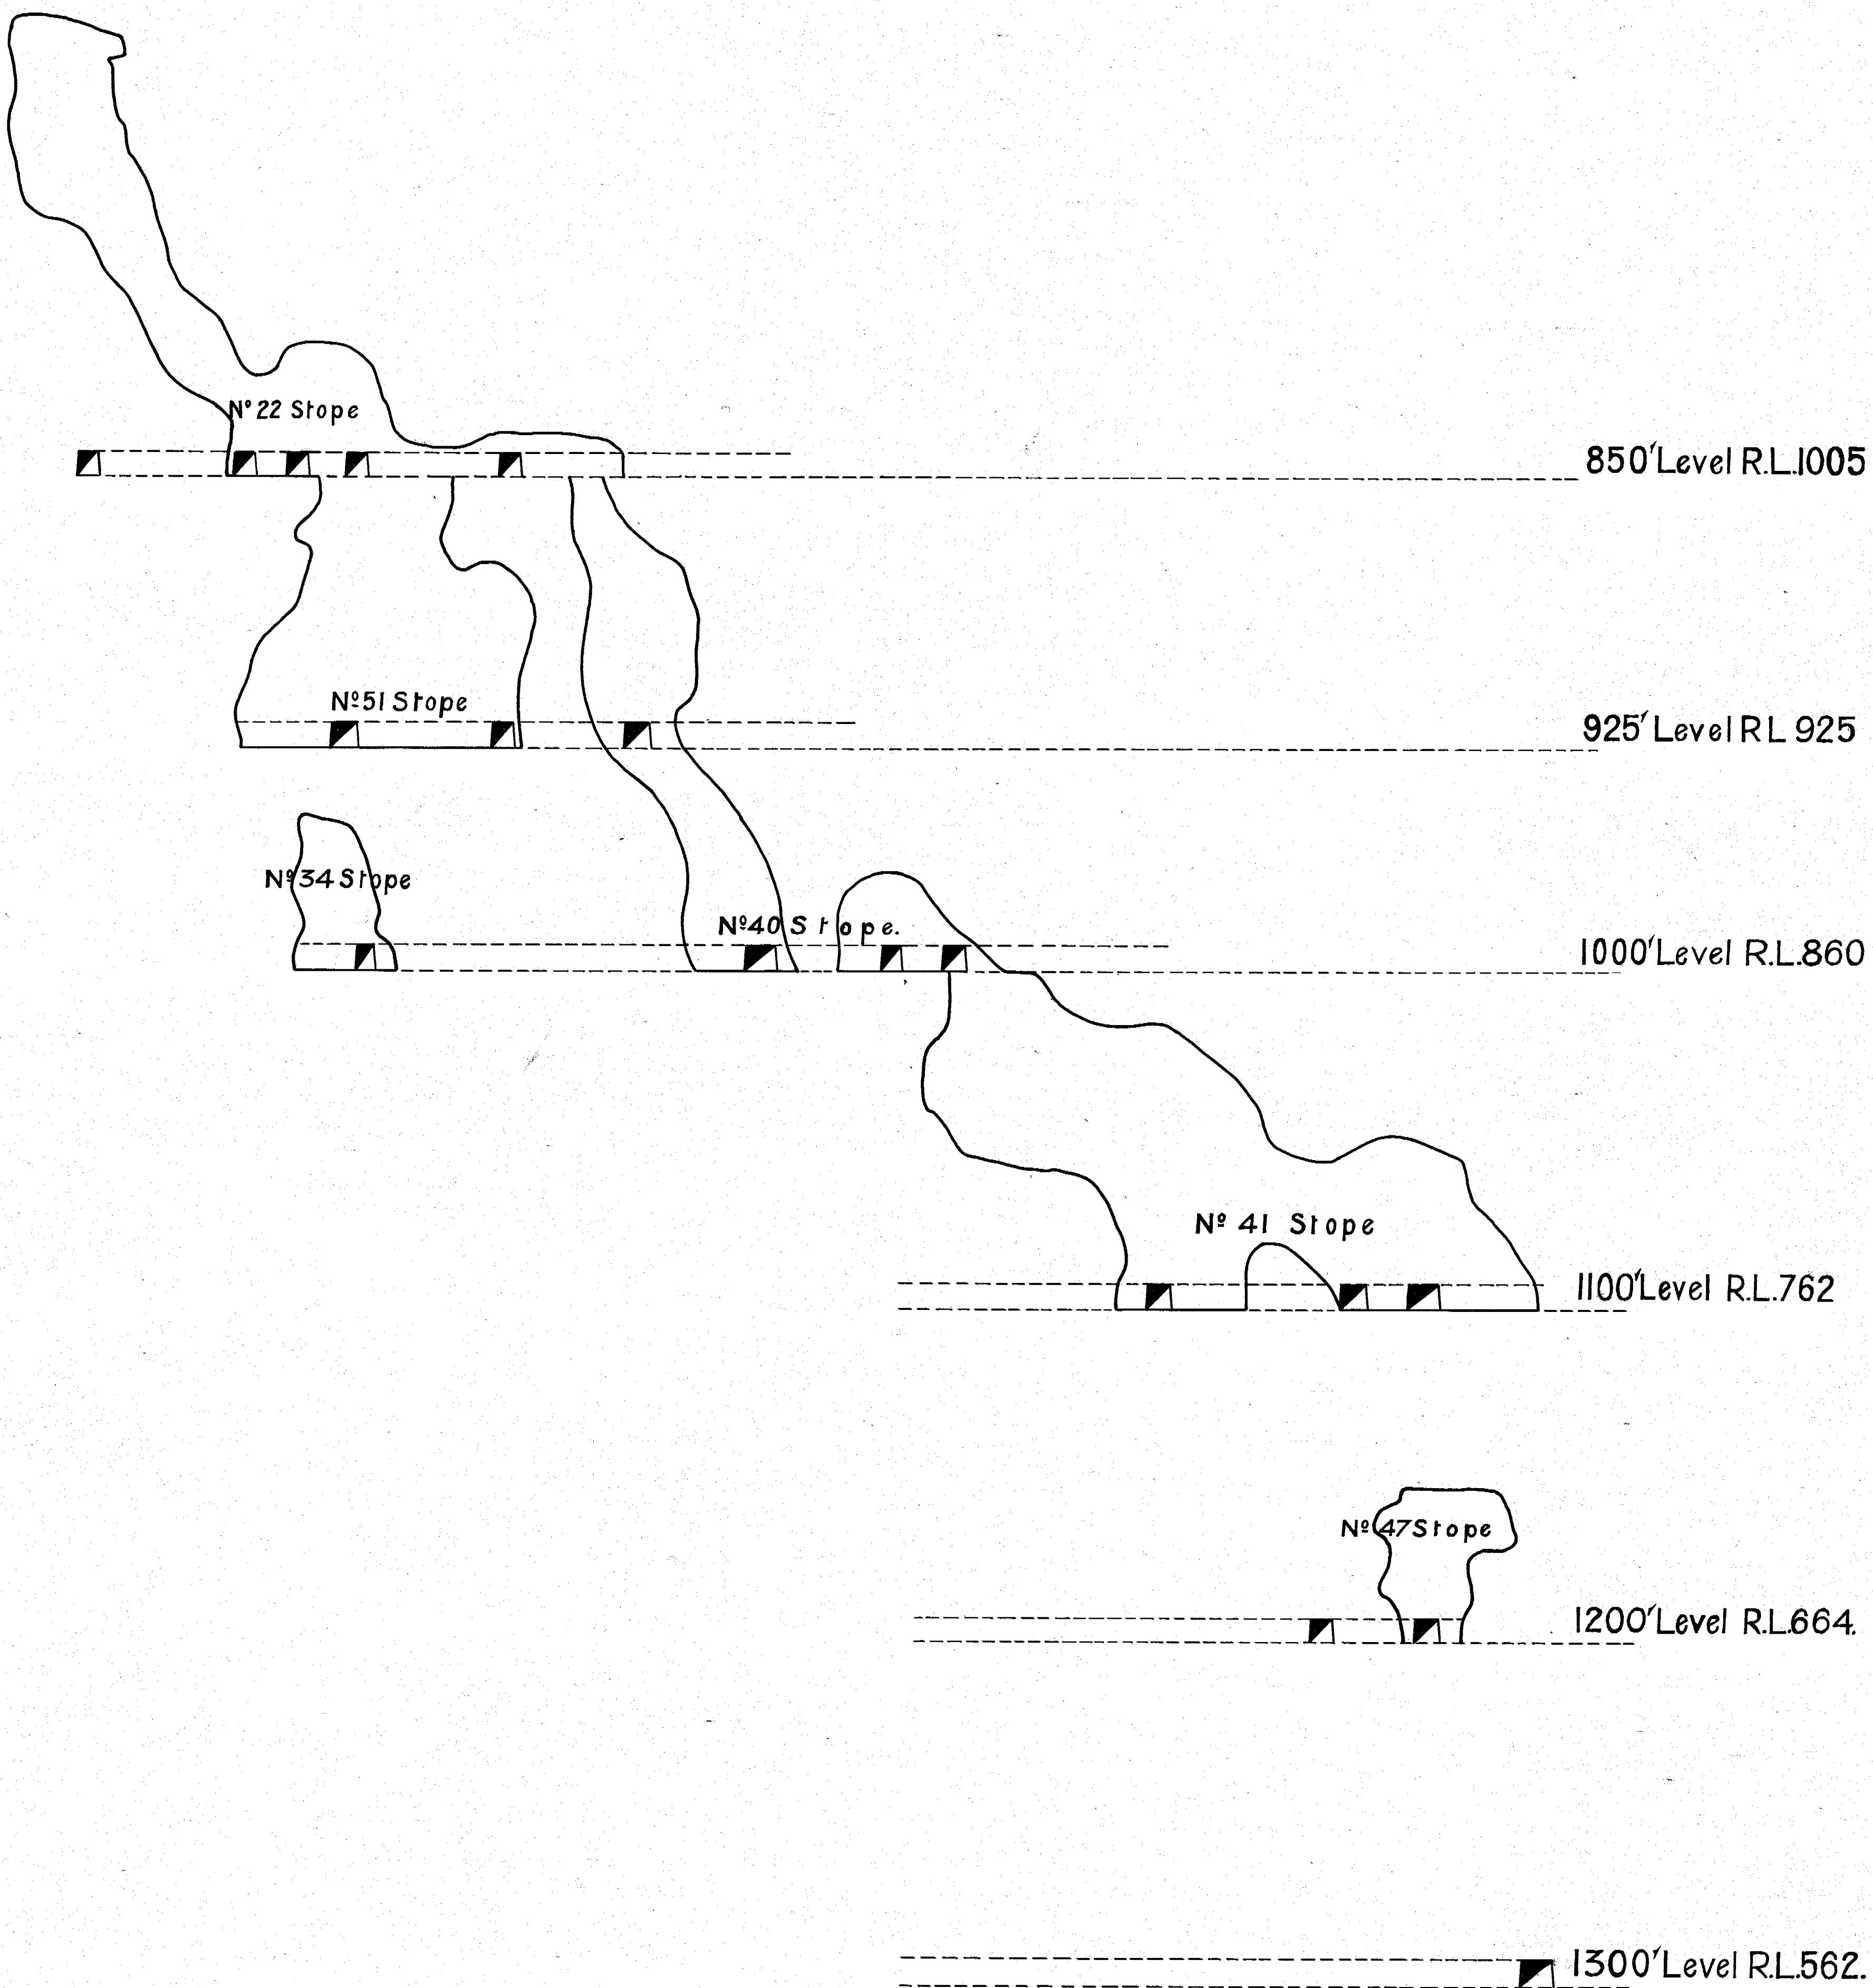

The Mount Lyell Mining & Railway Co., Ltd

Mine Department
NORTH LYELL MINE

Section on Line **DD** looking North

Brought up to Dec. 31st 1931.

Scale 1" = 30'

R. H. M. 3/3/32 General Manager
H. J. 14/6/32 Mine Superintendent