


5 cm

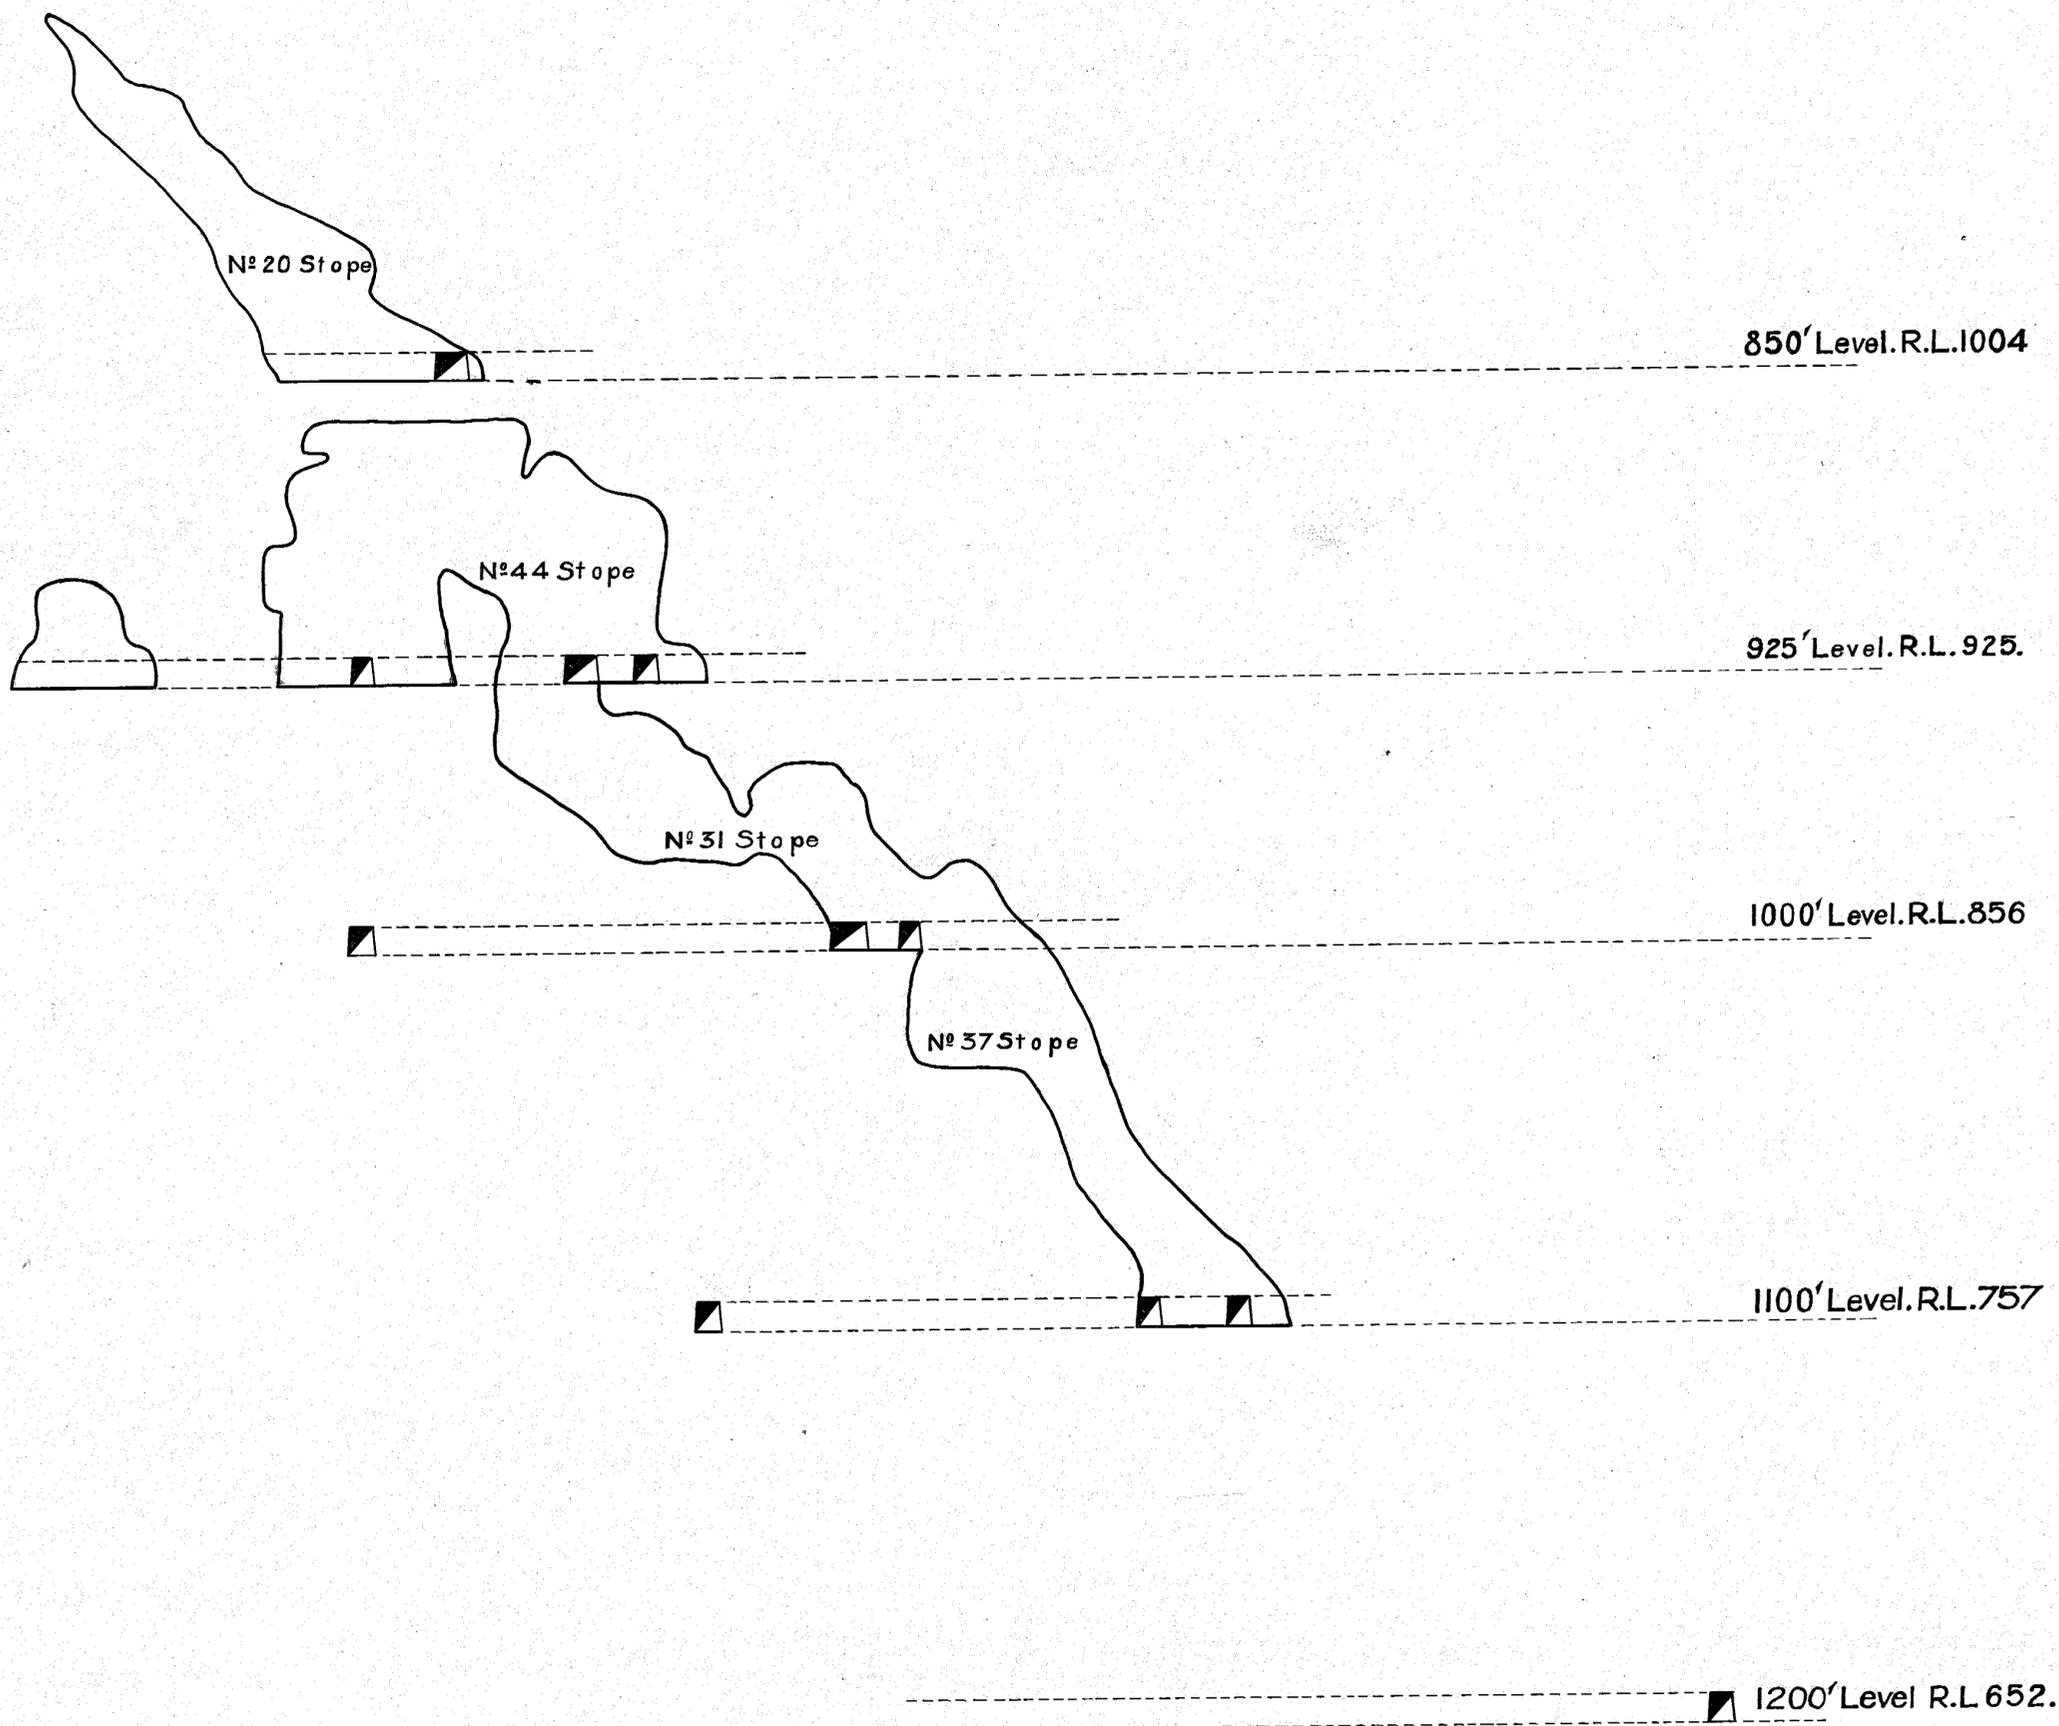

The Mount Lyell Mining & Railway Co., Ltd.

Mine Department.
 NORTH LYELL MINE
 Section on Line CC looking North.
 Brought up to Dec 31st 1931
 Scale 1" = 30'

Ed. 14-6-32
R. W. Murray General Manager
A. J. Jones Mine Superintendent