


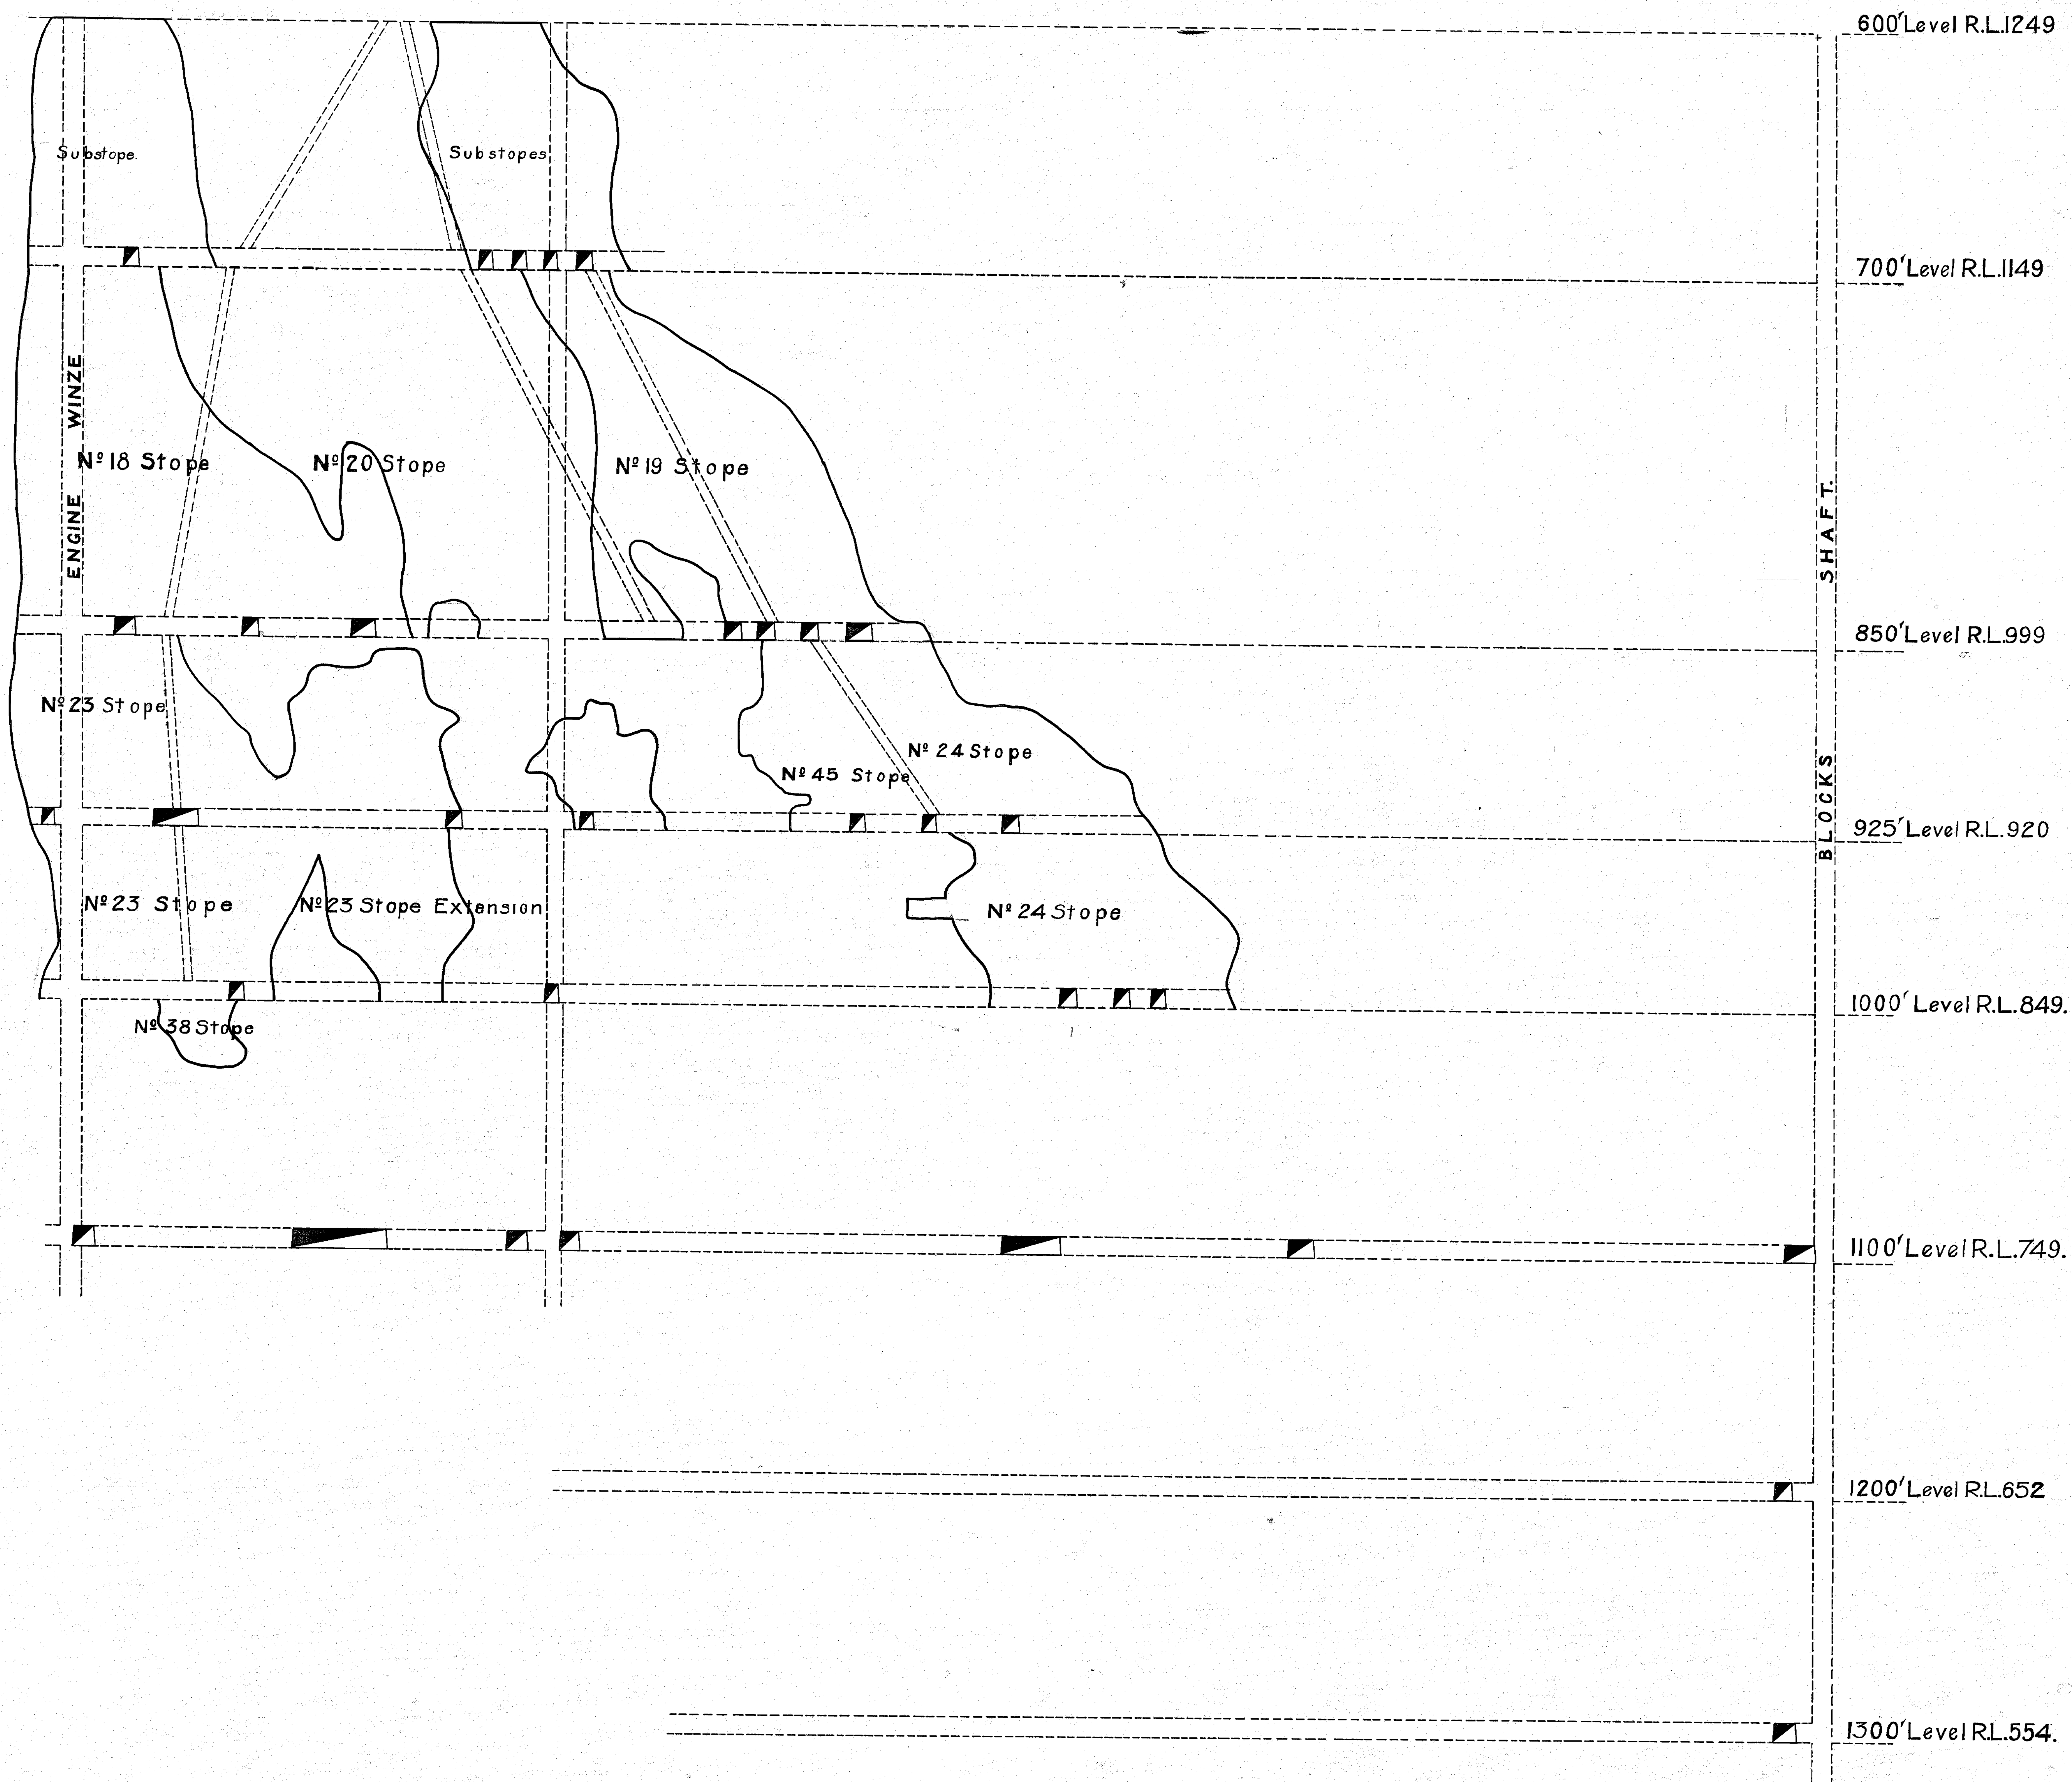

The Mount Lyell Mining & Railway Co Ltd.

Mine Department
 NORTH LYELL MINE
 Section on Line B B Looking North.
 Brought up to Dec 31st 1931
 Scale 1" = 30'

W. H. M. J. M. General Manager.
W. H. M. J. M. Mine Superintendent.

E. J. M. J. M.