


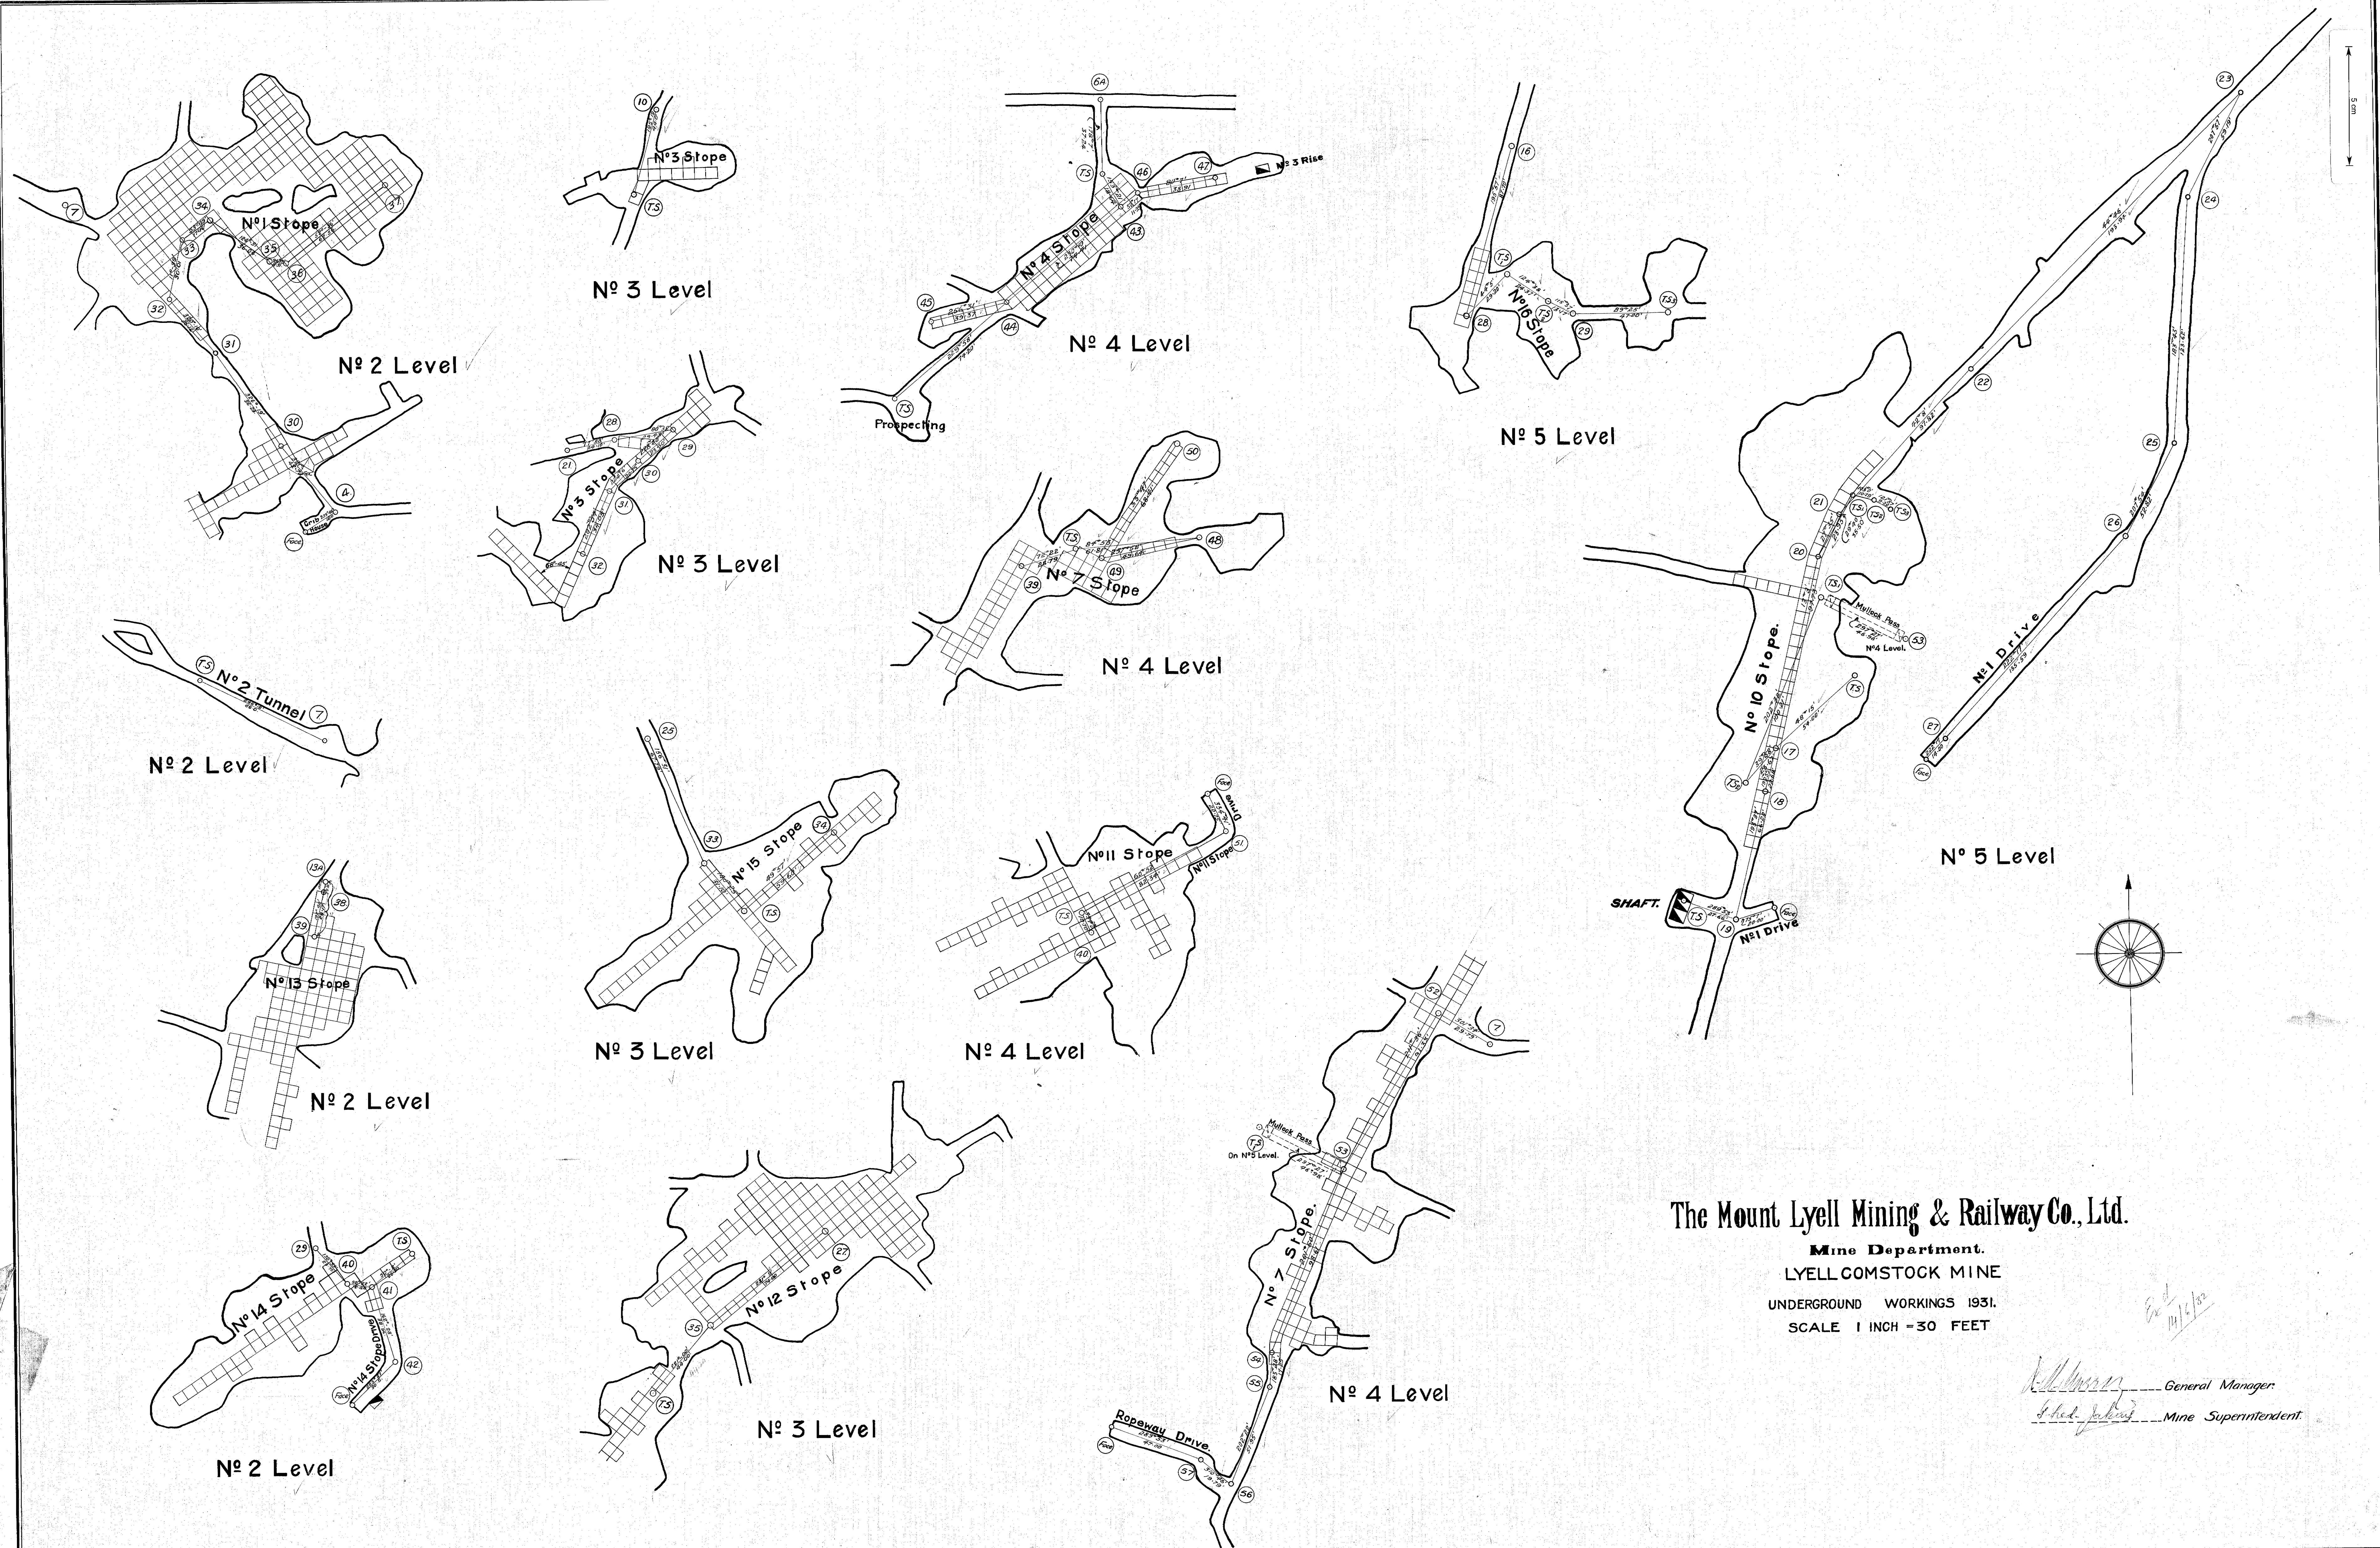

The Mount Lyell Mining & Railway Co., Ltd.

Mine Department.
 LYELL COMSTOCK MINE
 UNDERGROUND WORKINGS 1931.
 SCALE 1 INCH = 30 FEET

[Signature] General Manager
[Signature] Mine Superintendent