


56-90

58-90

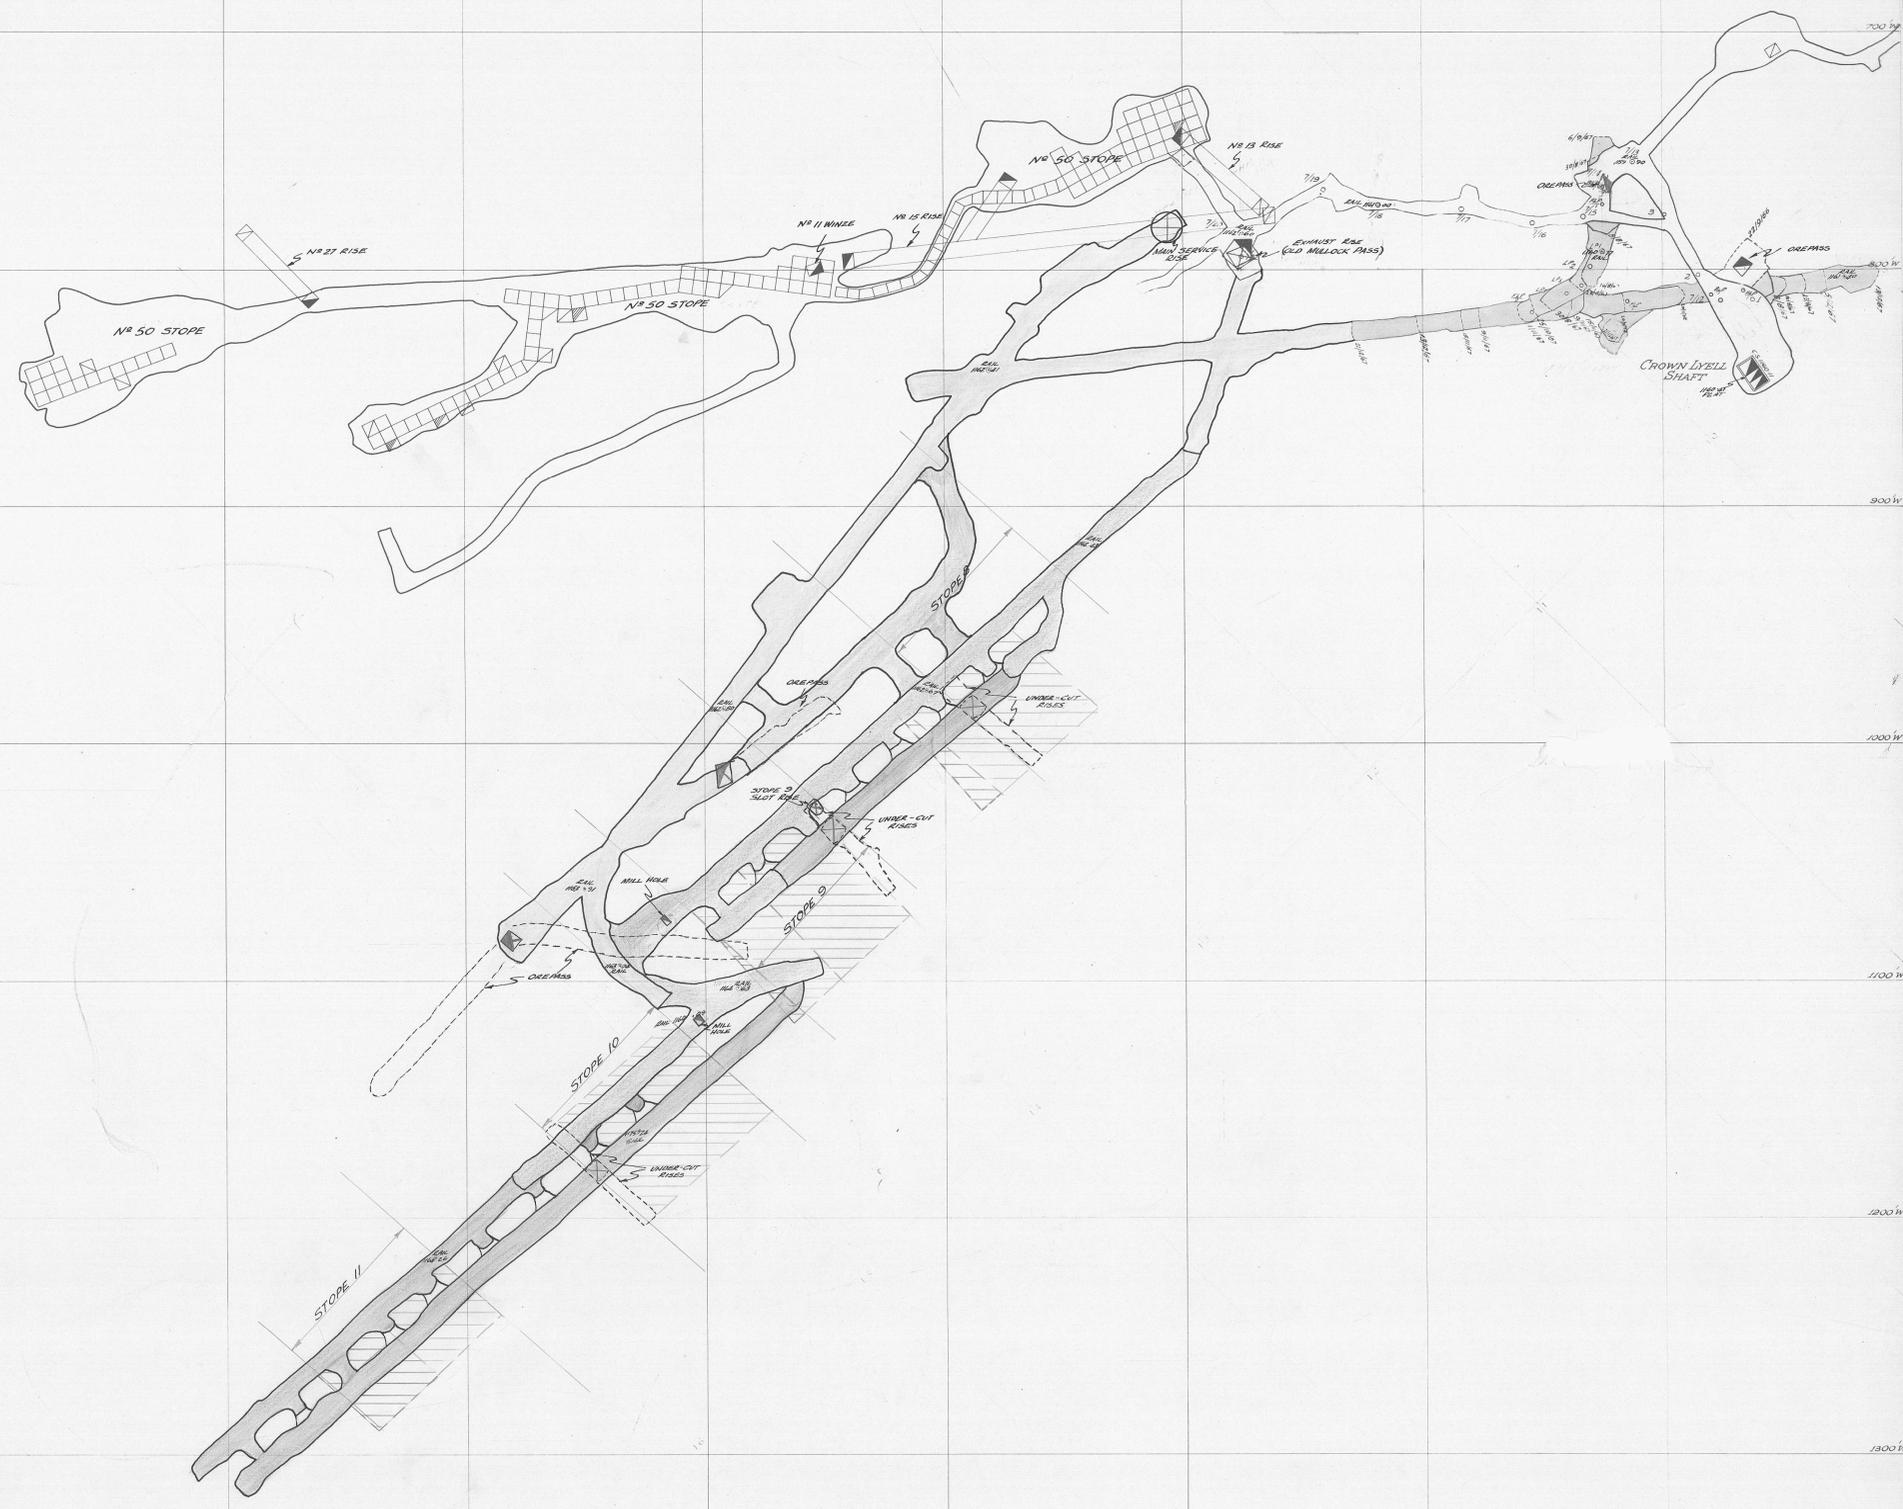

BROUGHT UP TO DATE	MINE MANAGER	CHIEF SURVEYOR
31-12-67	<i>[Signature]</i>	<i>[Signature]</i>
31-12-68	<i>[Signature]</i>	<i>[Signature]</i>
31-12-68	<i>[Signature]</i>	<i>[Signature]</i>
31-12-70	<i>[Signature]</i>	<i>[Signature]</i>
31-12-72	<i>[Signature]</i>	<i>[Signature]</i>

MOUNT LYEELL M. & R. COY. LTD.		Drawn by	APPROVED	
MINE DEPARTMENT		Traced by	<i>[Signature]</i>	<i>[Signature]</i> Mine Mgr.
Survey by	Date: 5-3-63	Scale: 1" = 30'	Checked by	<i>[Signature]</i> Chief Surv.
CROWN LYEELL MINE No. 7 LEVEL SILL PLAN SHEET 142				DRAWING NO. <b>BS-6</b>

5 cm