


58-92

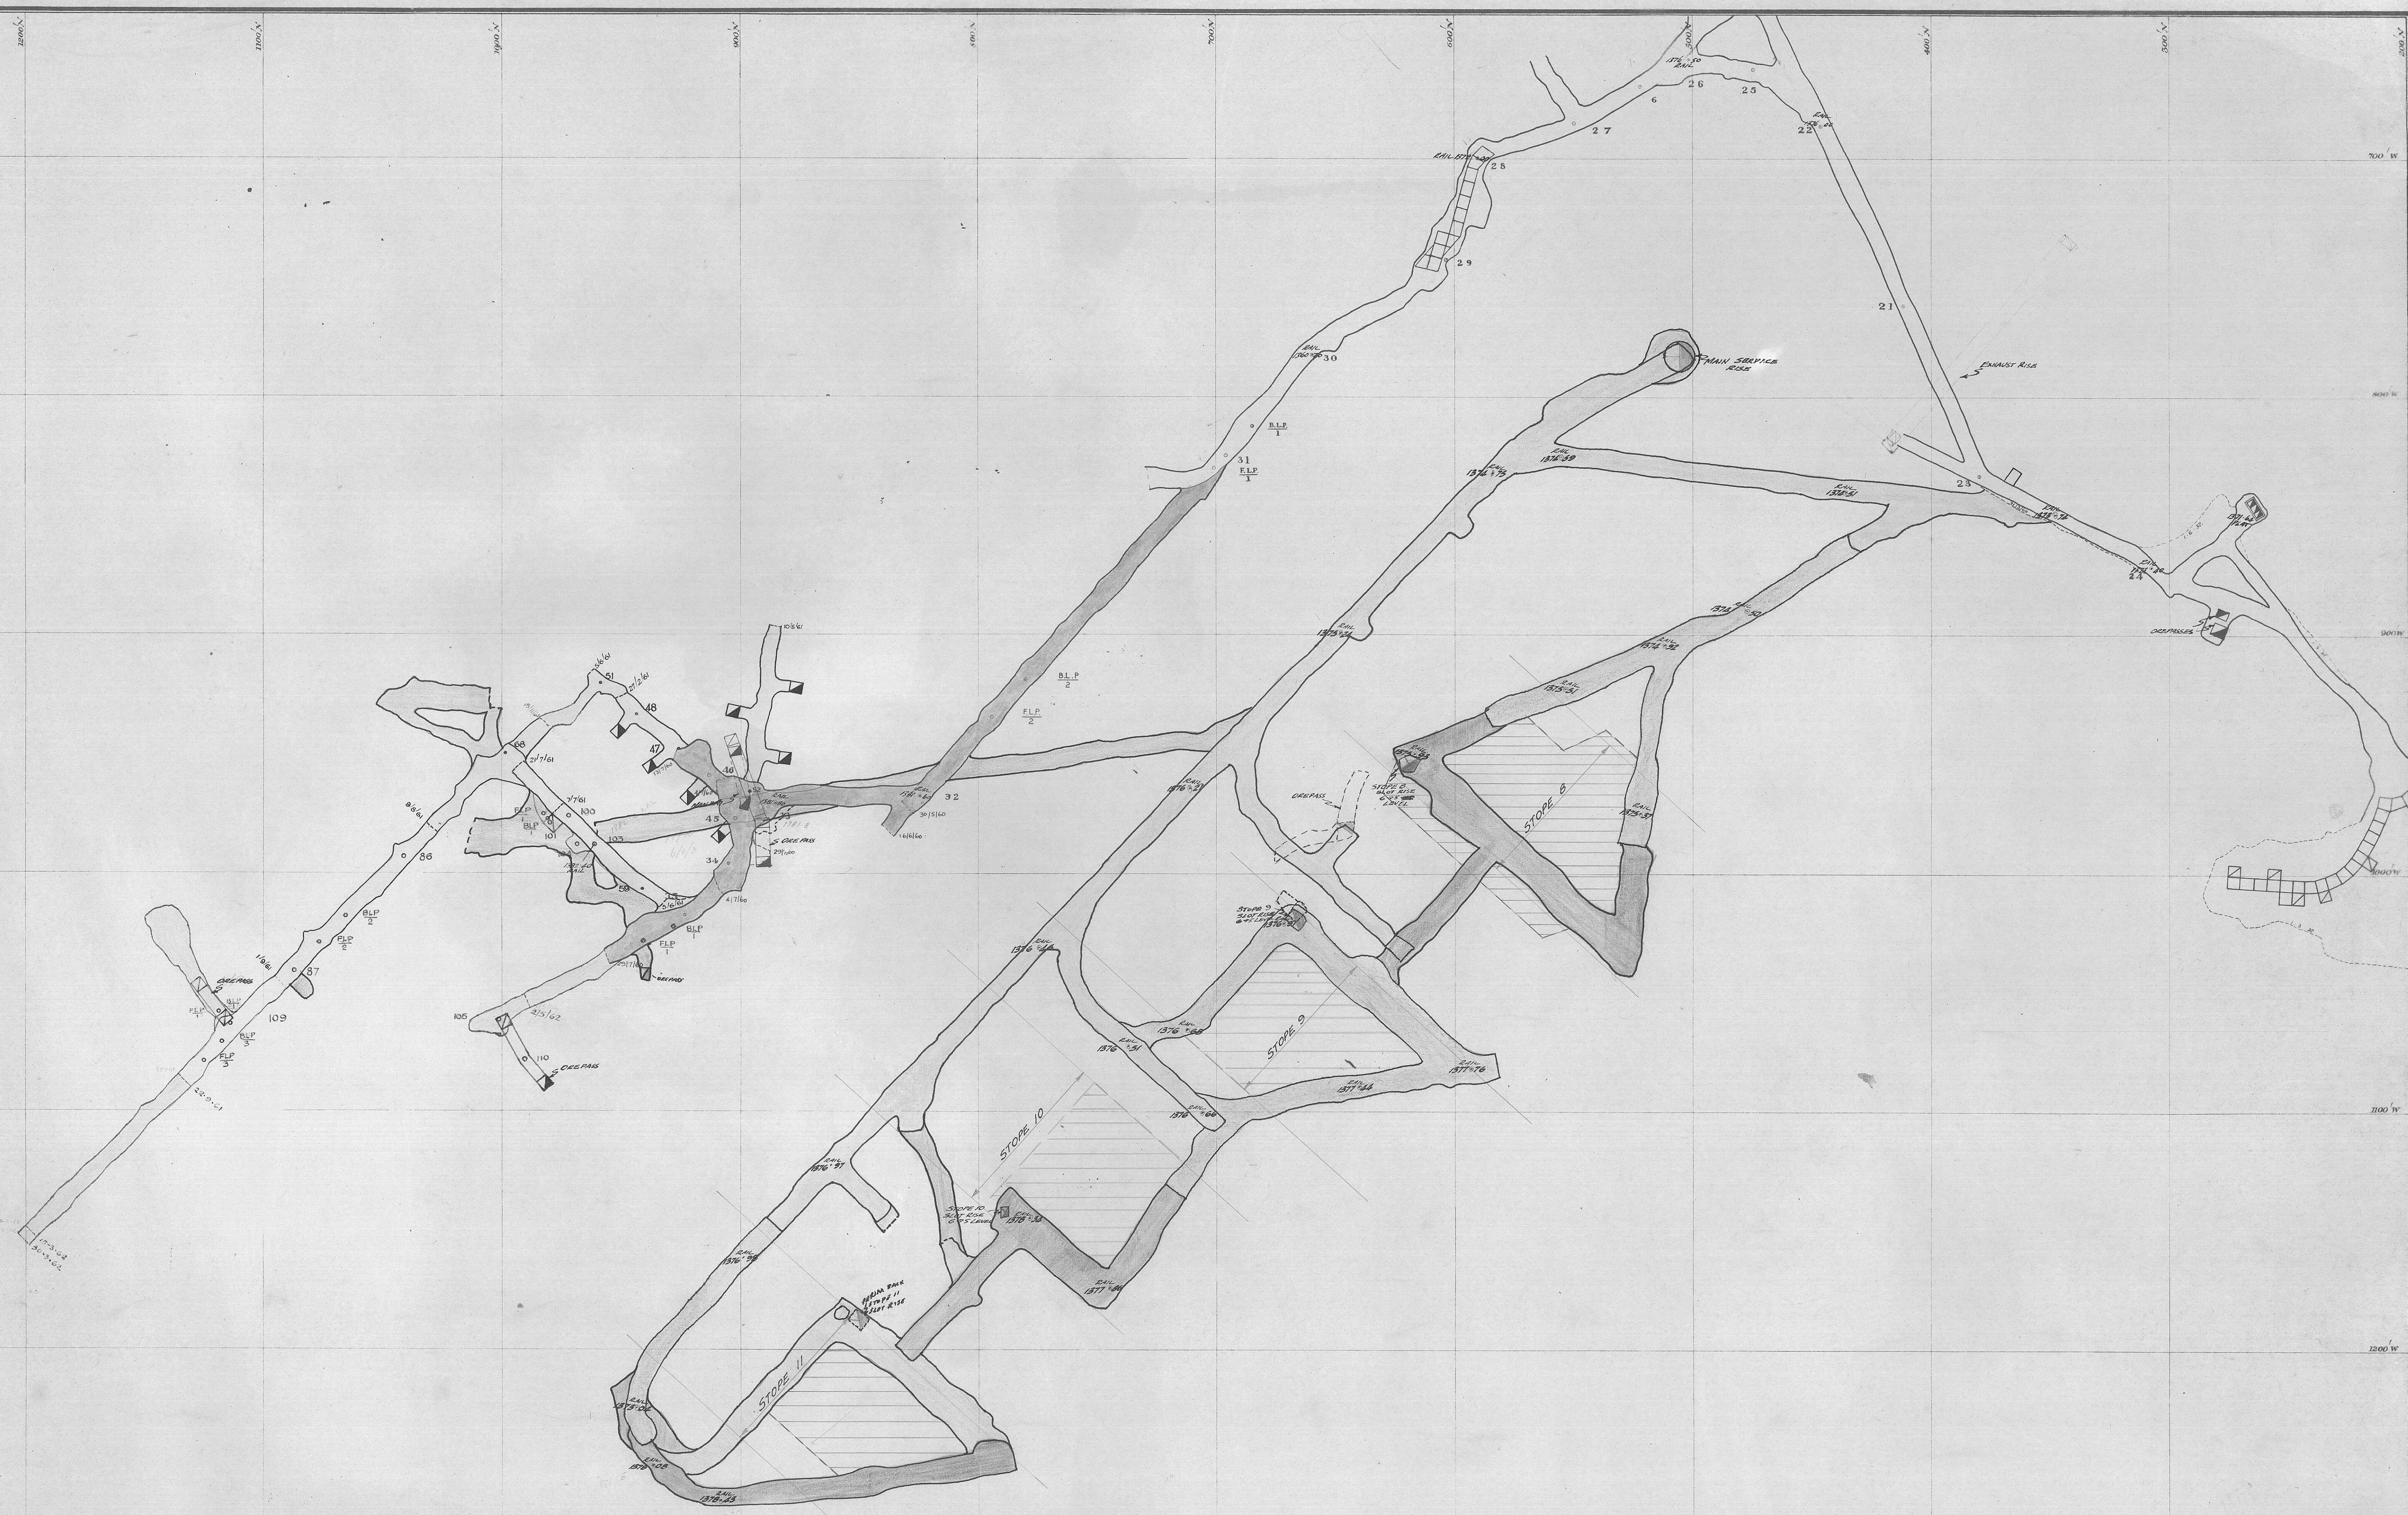

BROUGHT UP TO DATE	MINE MANAGER	CHIEF SURVEYOR		
31/12/60			31-12-72	
31/12/61				
31/12/62				
31/12/63				
31-12-68				
31-12-69				
31-12-70				
31/12/71				

MOUNT LYELL M. & R. COY. LTD.		Drawn by	LSK	APPROVED
MINE DEPARTMENT		Traced by	LSK	Mine Supd.
Survey by	9 Oct. 1959	Scale	1" = 50 ft.	Chief Surv.
CROWN LYELL MINE				DRAWING NO.
No. 5. LEVEL SILL PLAN				BS-1
SHEET 142				