


56-92^b

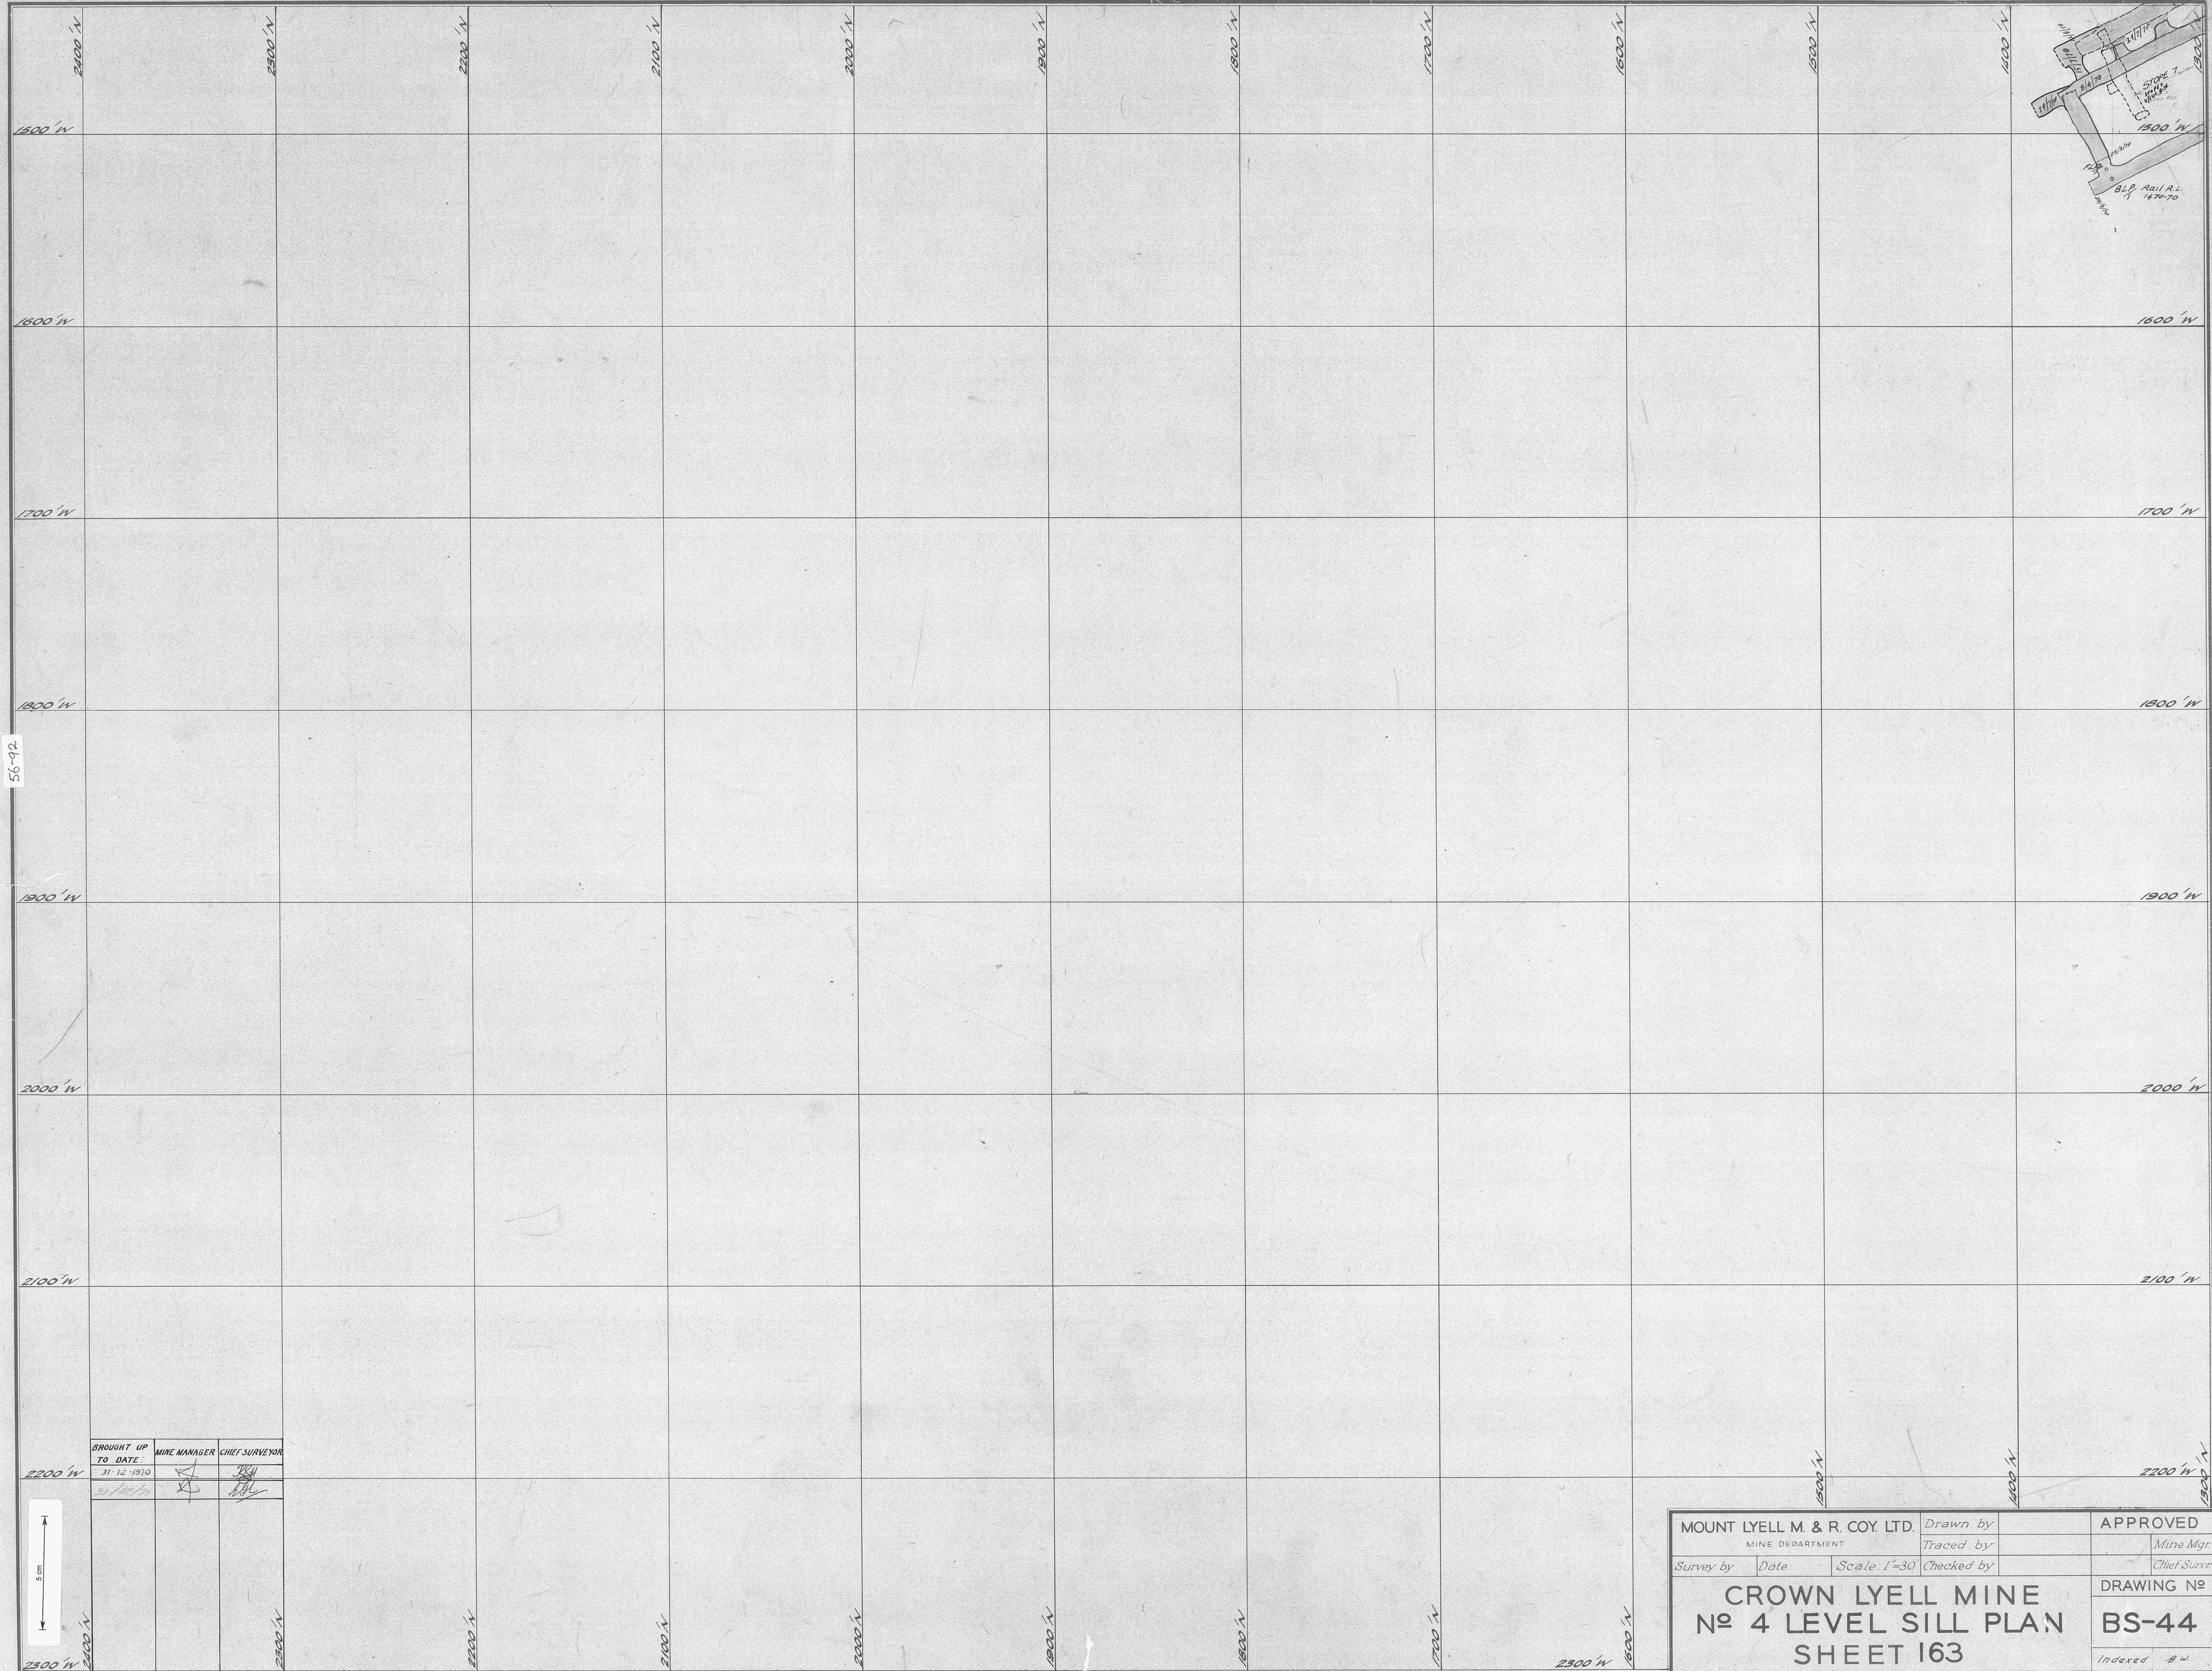

56-92

BROUGHT UP TO DATE:	MINE MANAGER	CHIEF SURVEYOR
31-12-1970	<i>[Signature]</i>	<i>[Signature]</i>
31/12/70	<i>[Signature]</i>	<i>[Signature]</i>

MOUNT LYELL M. & R. COY. LTD.			Drawn by		APPROVED
MINE DEPARTMENT			Traced by		Mine Mgr
Survey by	Date	Scale: 1"=30'	Checked by		Chief Survr
CROWN LYELL MINE No 4 LEVEL SILL PLAN SHEET 163					DRAWING No BS-44
					Indexed g.w.