


44-94

45-94

5 cm

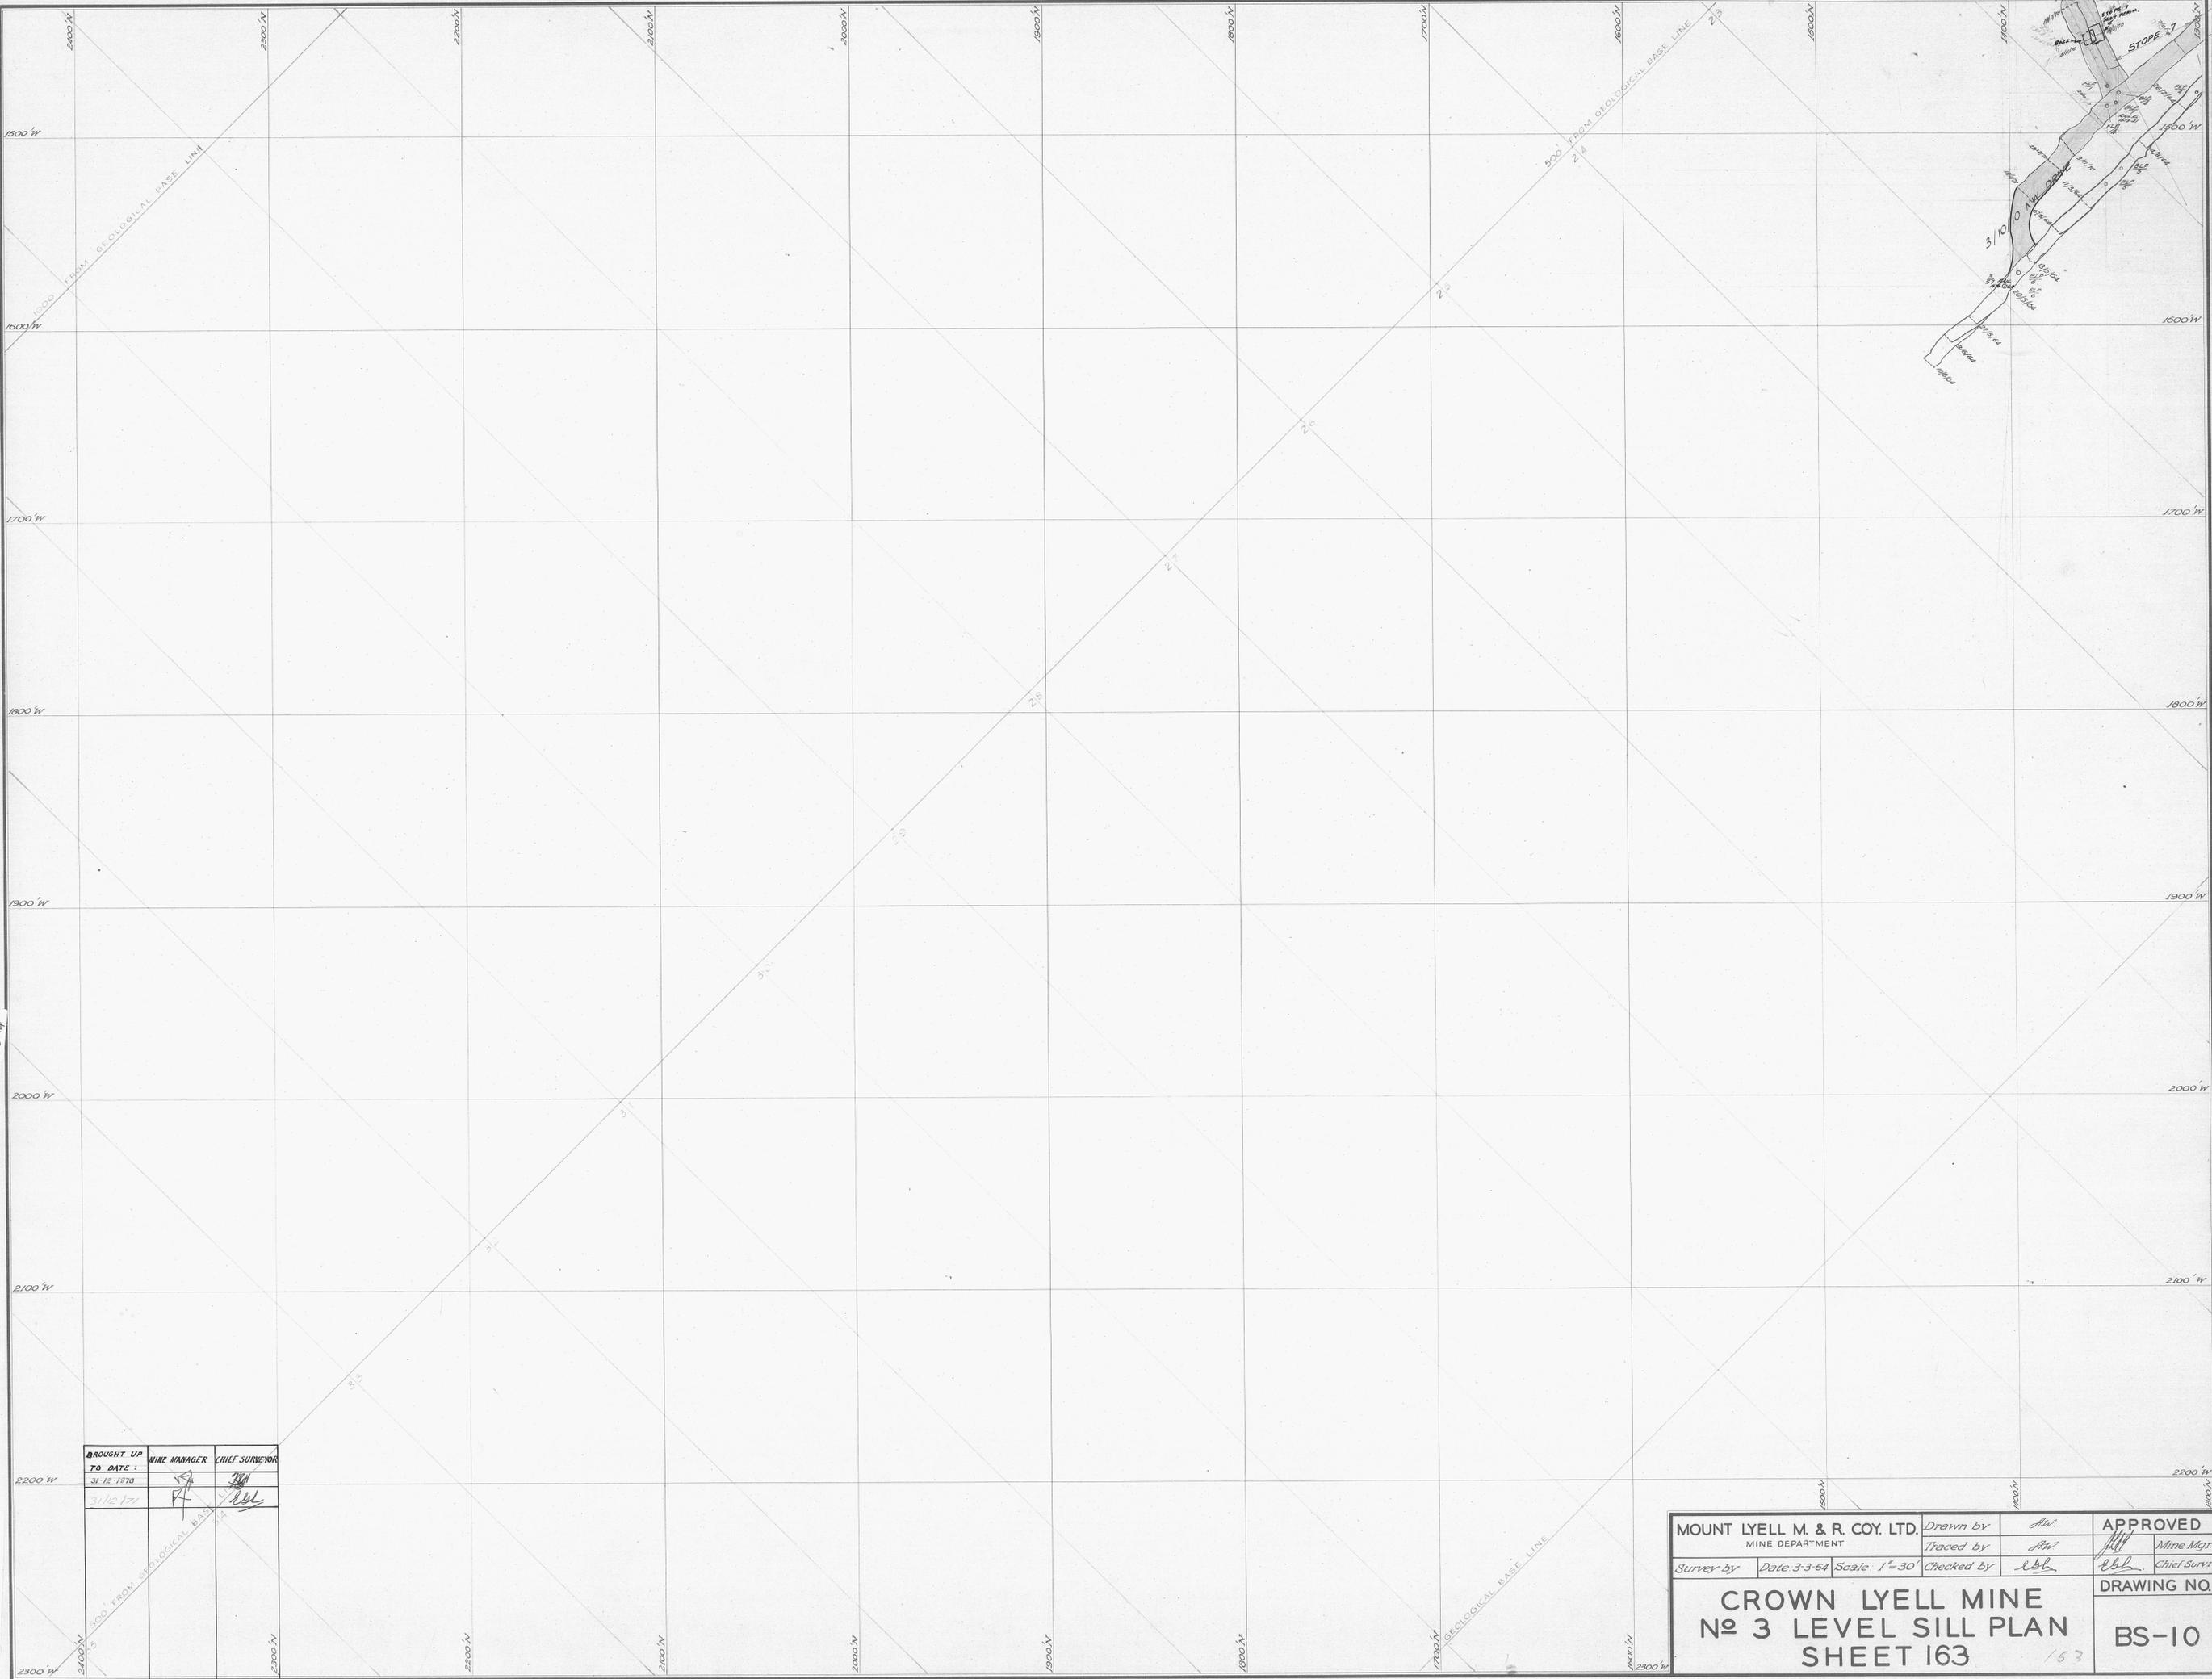

BROUGHT UP TO DATE :	MINE MANAGER	CHIEF SURVEYOR
31-12-1870	<i>[Signature]</i>	<i>[Signature]</i>
31/12/77	<i>[Signature]</i>	<i>[Signature]</i>

MOUNT LYELL M. & R. COY. LTD. MINE DEPARTMENT		Drawn by <i>[Signature]</i>	APPROVED <i>[Signature]</i> Mine Mgr.
Survey by	Date 3-3-64	Scale 1"=30'	Checked by <i>[Signature]</i> Chief Surv.
CROWN LYELL MINE No 3 LEVEL SILL PLAN SHEET 163			DRAWING NO. BS-10