


56-98

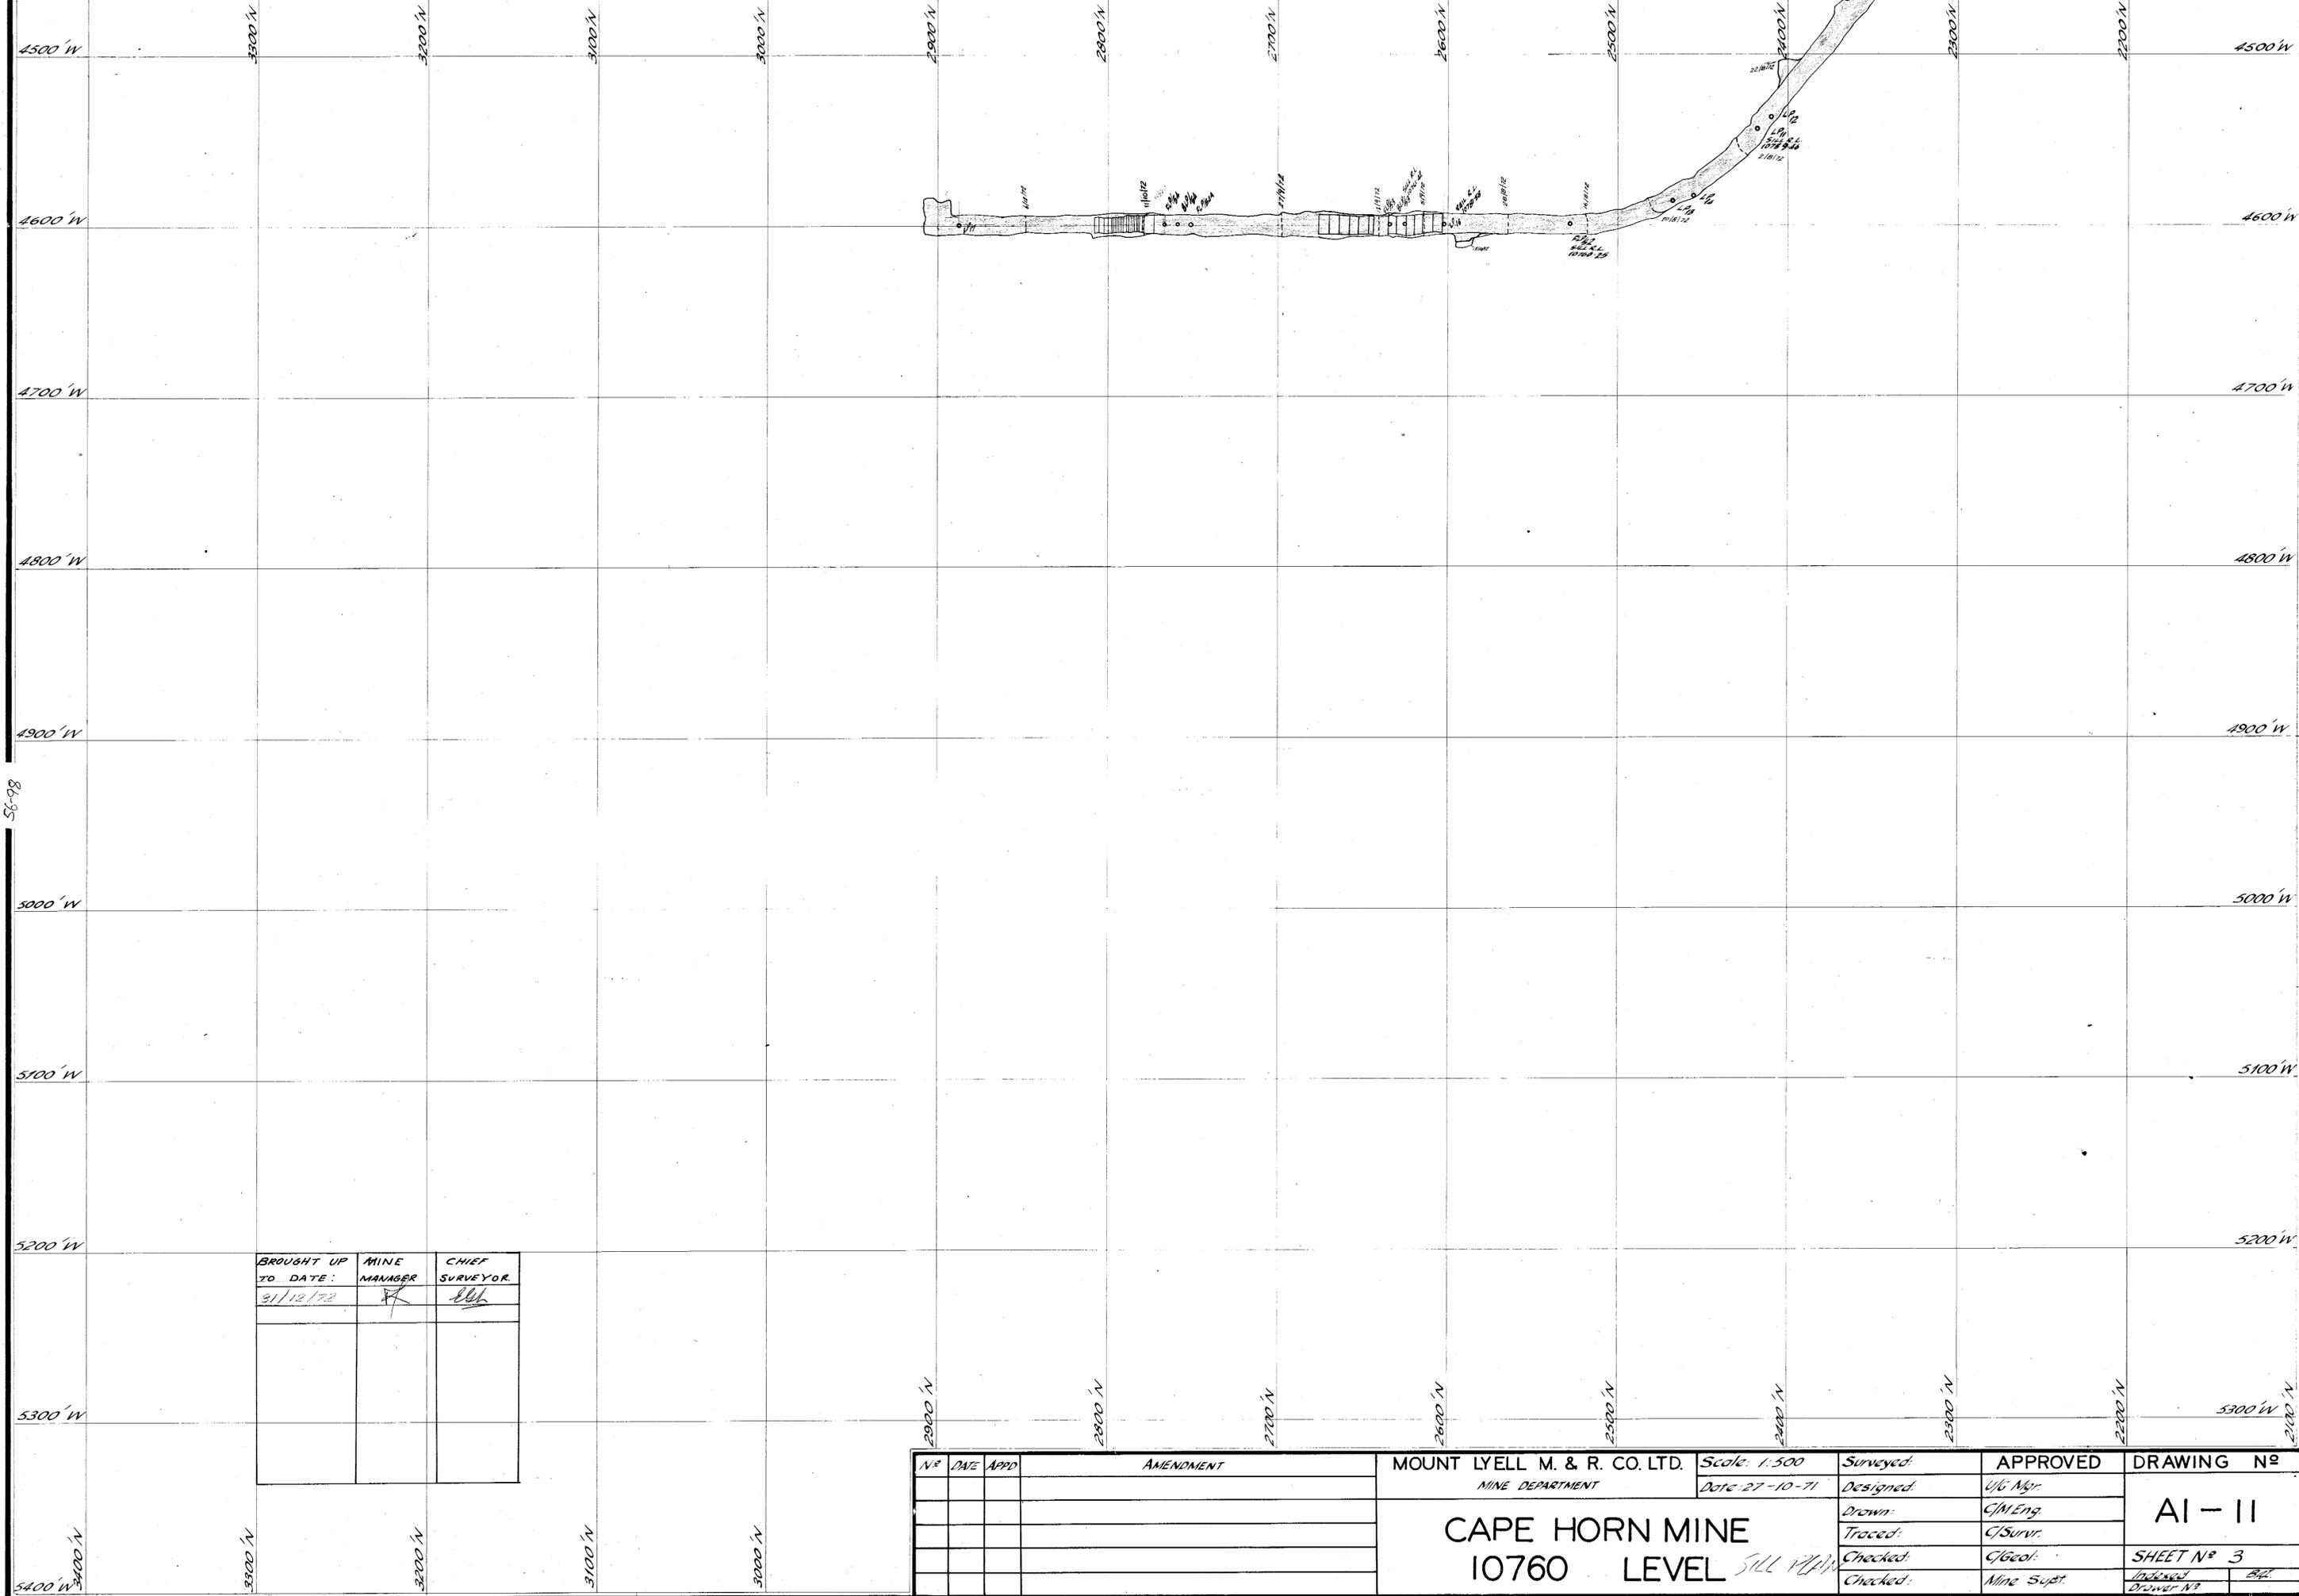

BROUGHT UP TO DATE:	MINE MANAGER	CHIEF SURVEYOR
3/12/72	<i>[Signature]</i>	<i>[Signature]</i>

<table border="1"> <tr><th>Nº</th><th>DATE</th><th>APPD</th></tr> <tr><td> </td><td> </td><td> </td></tr> <tr><td> </td><td> </td><td> </td></tr> <tr><td> </td><td> </td><td> </td></tr> <tr><td> </td><td> </td><td> </td></tr> </table>	Nº	DATE	APPD													AMENDMENT	MOUNT LYELL M. & R. CO. LTD. MINE DEPARTMENT	Scale: 1:500 Date: 27-10-71	Surveyed: Designed: Drawn: Traced: Checked: Checked:	APPROVED <i>[Signature]</i> C/M Eng C/Surv. C/Geol. Mine Supt.	DRAWING Nº <b>AI-11</b> SHEET Nº 3 Indexed Drawer Nº
	Nº	DATE	APPD																		
CAPE HORN MINE	10760 LEVEL SILL PLAN																				

5 cm