


56-99

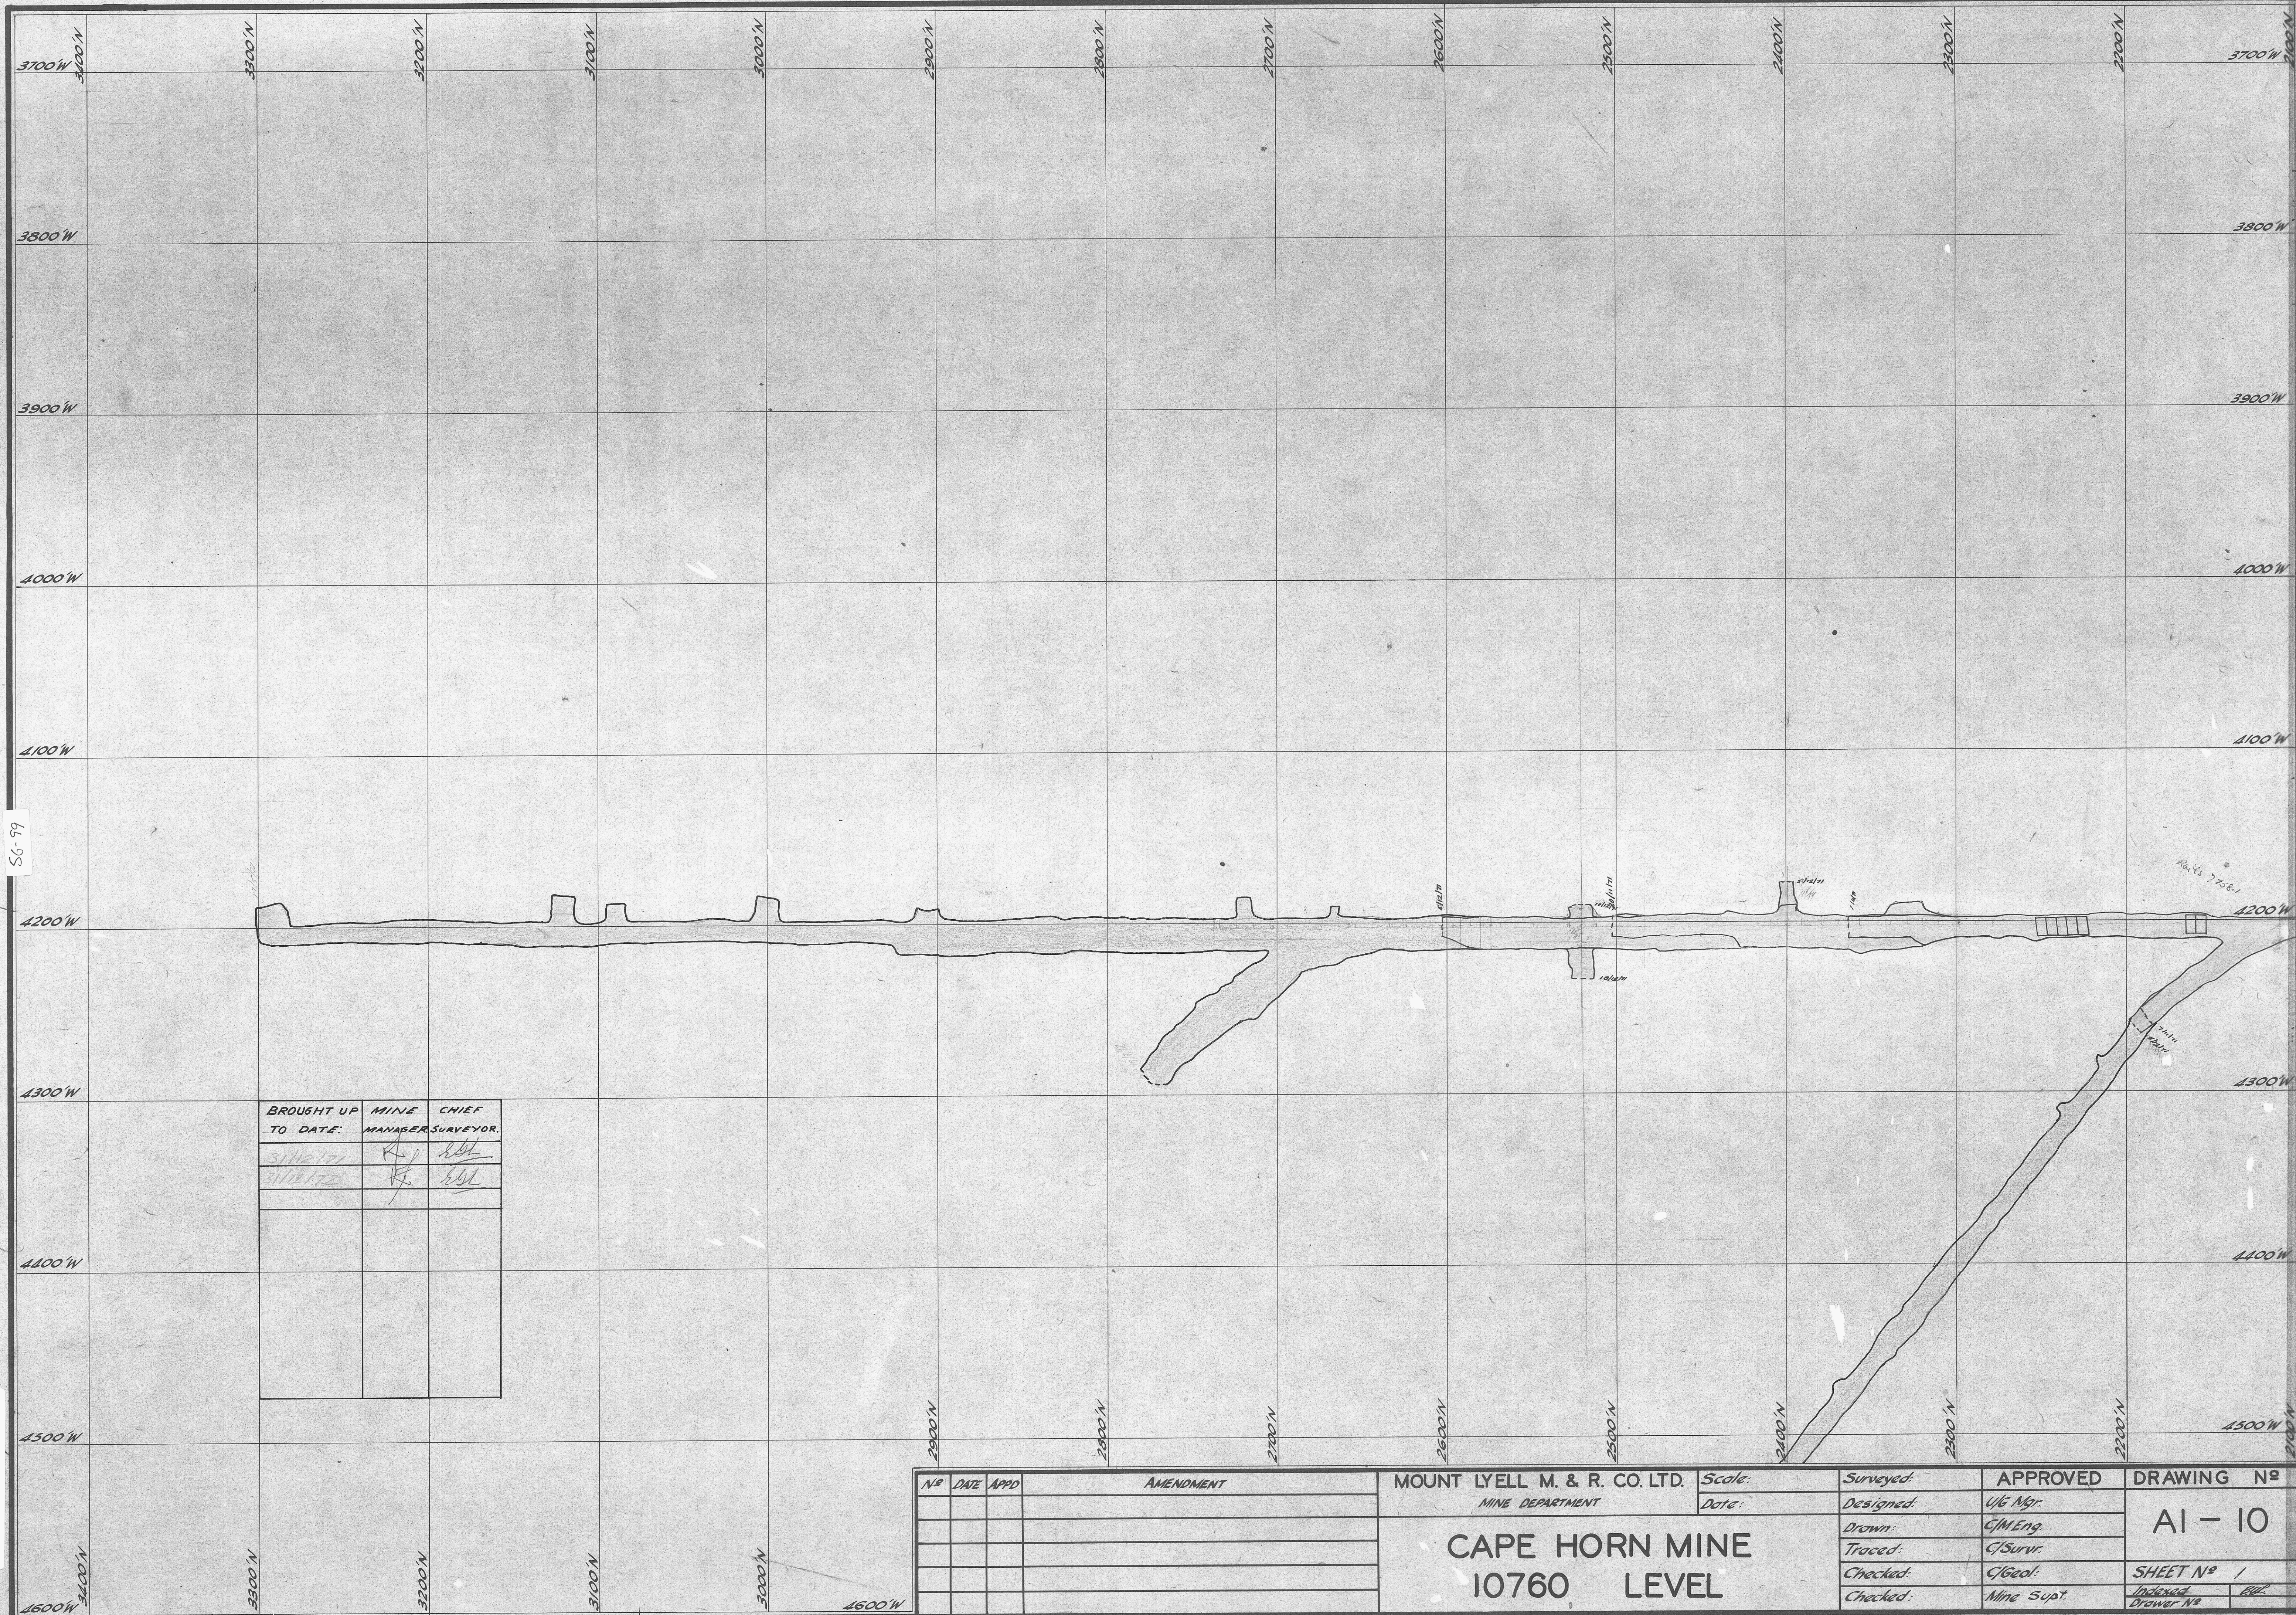

56-99

BROUGHT UP TO DATE:	MINE MANAGER	CHIEF SURVEYOR.
31/12/71	<i>[Signature]</i>	<i>[Signature]</i>
31/12/72	<i>[Signature]</i>	<i>[Signature]</i>

5 cm

Nº	DATE	APPD	AMENDMENT

MOUNT LYELL M. & R. CO. LTD.
MINE DEPARTMENT

CAPE HORN MINE
10760 LEVEL

Scale:
Date:

Surveyed:	APPROVED
Designed:	U/G Mgr.
Drawn:	C/M Eng.
Traced:	C/Surv.
Checked:	C/Geol.
Checked:	Mine Supt.

DRAWING Nº
AI - 10
SHEET Nº
1
Indexed
DRW
Drawn Nº