


56-101

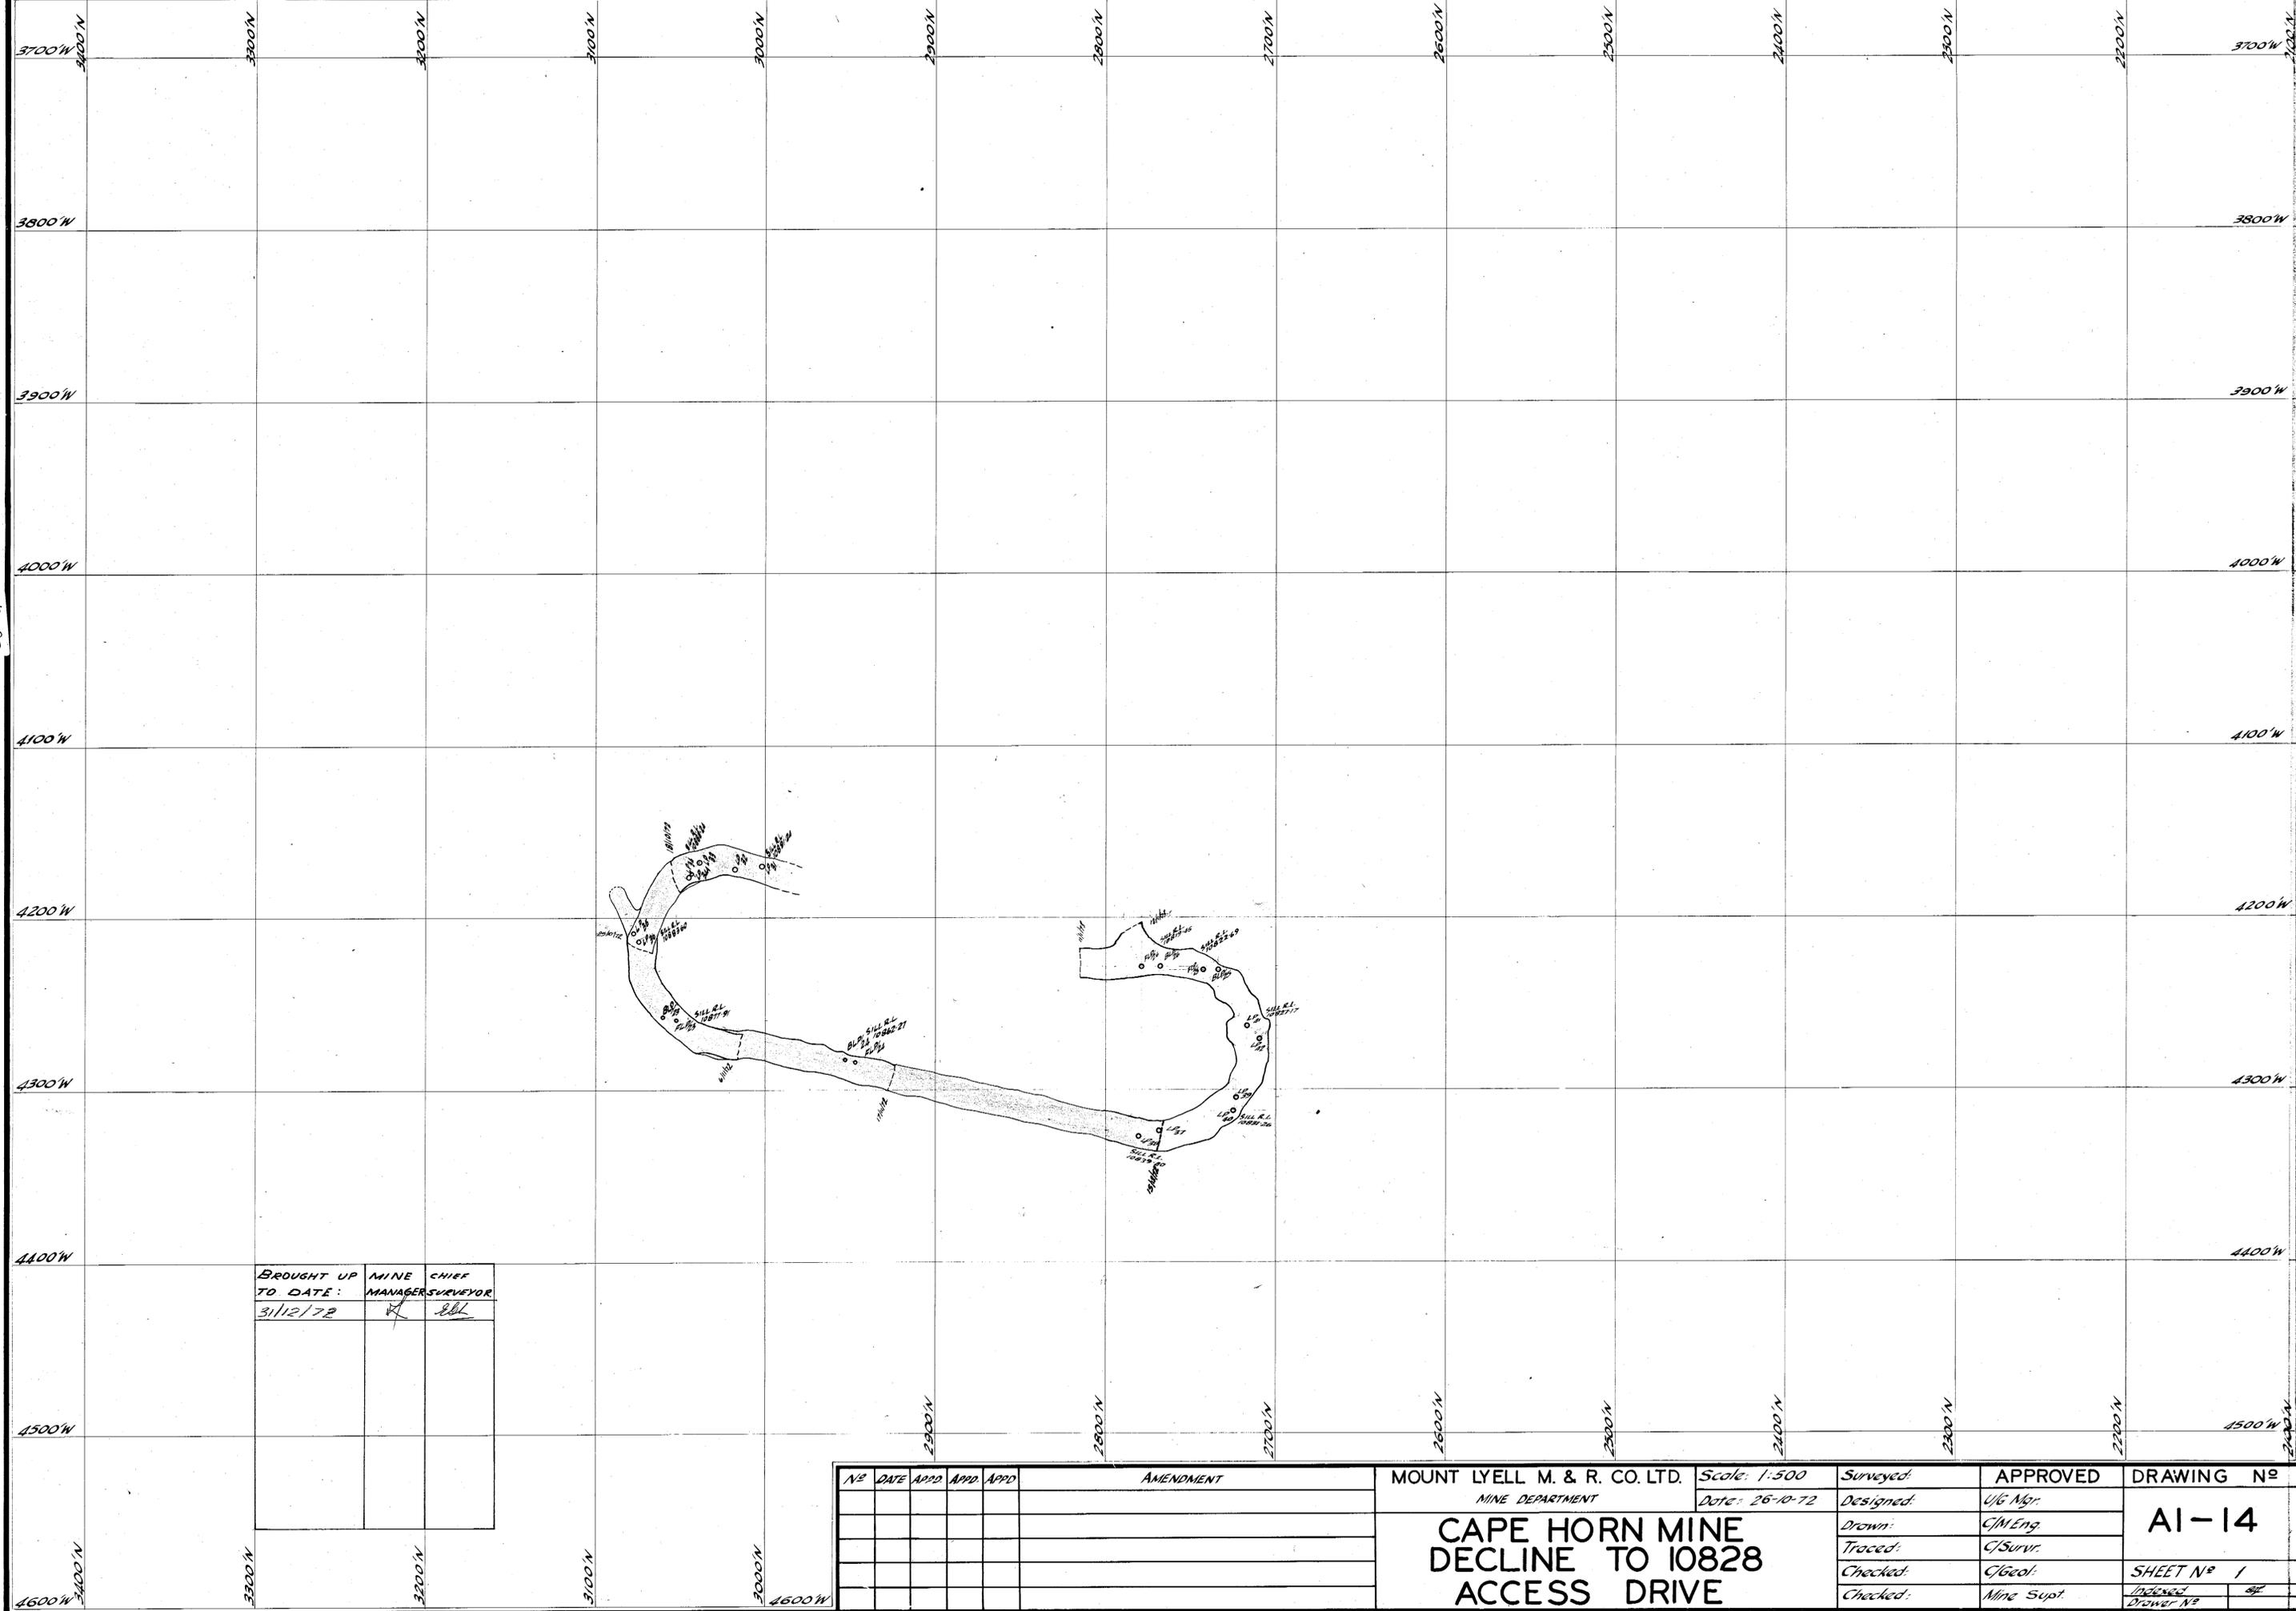

BROUGHT UP TO DATE:	MINE MANAGER	CHIEF SURVEYOR
3/1/72	[Signature]	[Signature]

Nº	DATE	APPD.	APPD.	APPD.	AMENDMENT

MOUNT LYELL M. & R. CO. LTD. MINE DEPARTMENT	Scale: 1:500 Date: 26-10-72	Surveyed: Designed: Drawn: Traced: Checked: Checked:	APPROVED U/G Mgr. C/M. Eng. C/Surv. C/Geol. Mine Supt.	DRAWING Nº AI-14 SHEET Nº 1 Indexed Drawn Nº
---	--------------------------------	---	---	---

5 cm