


56-103

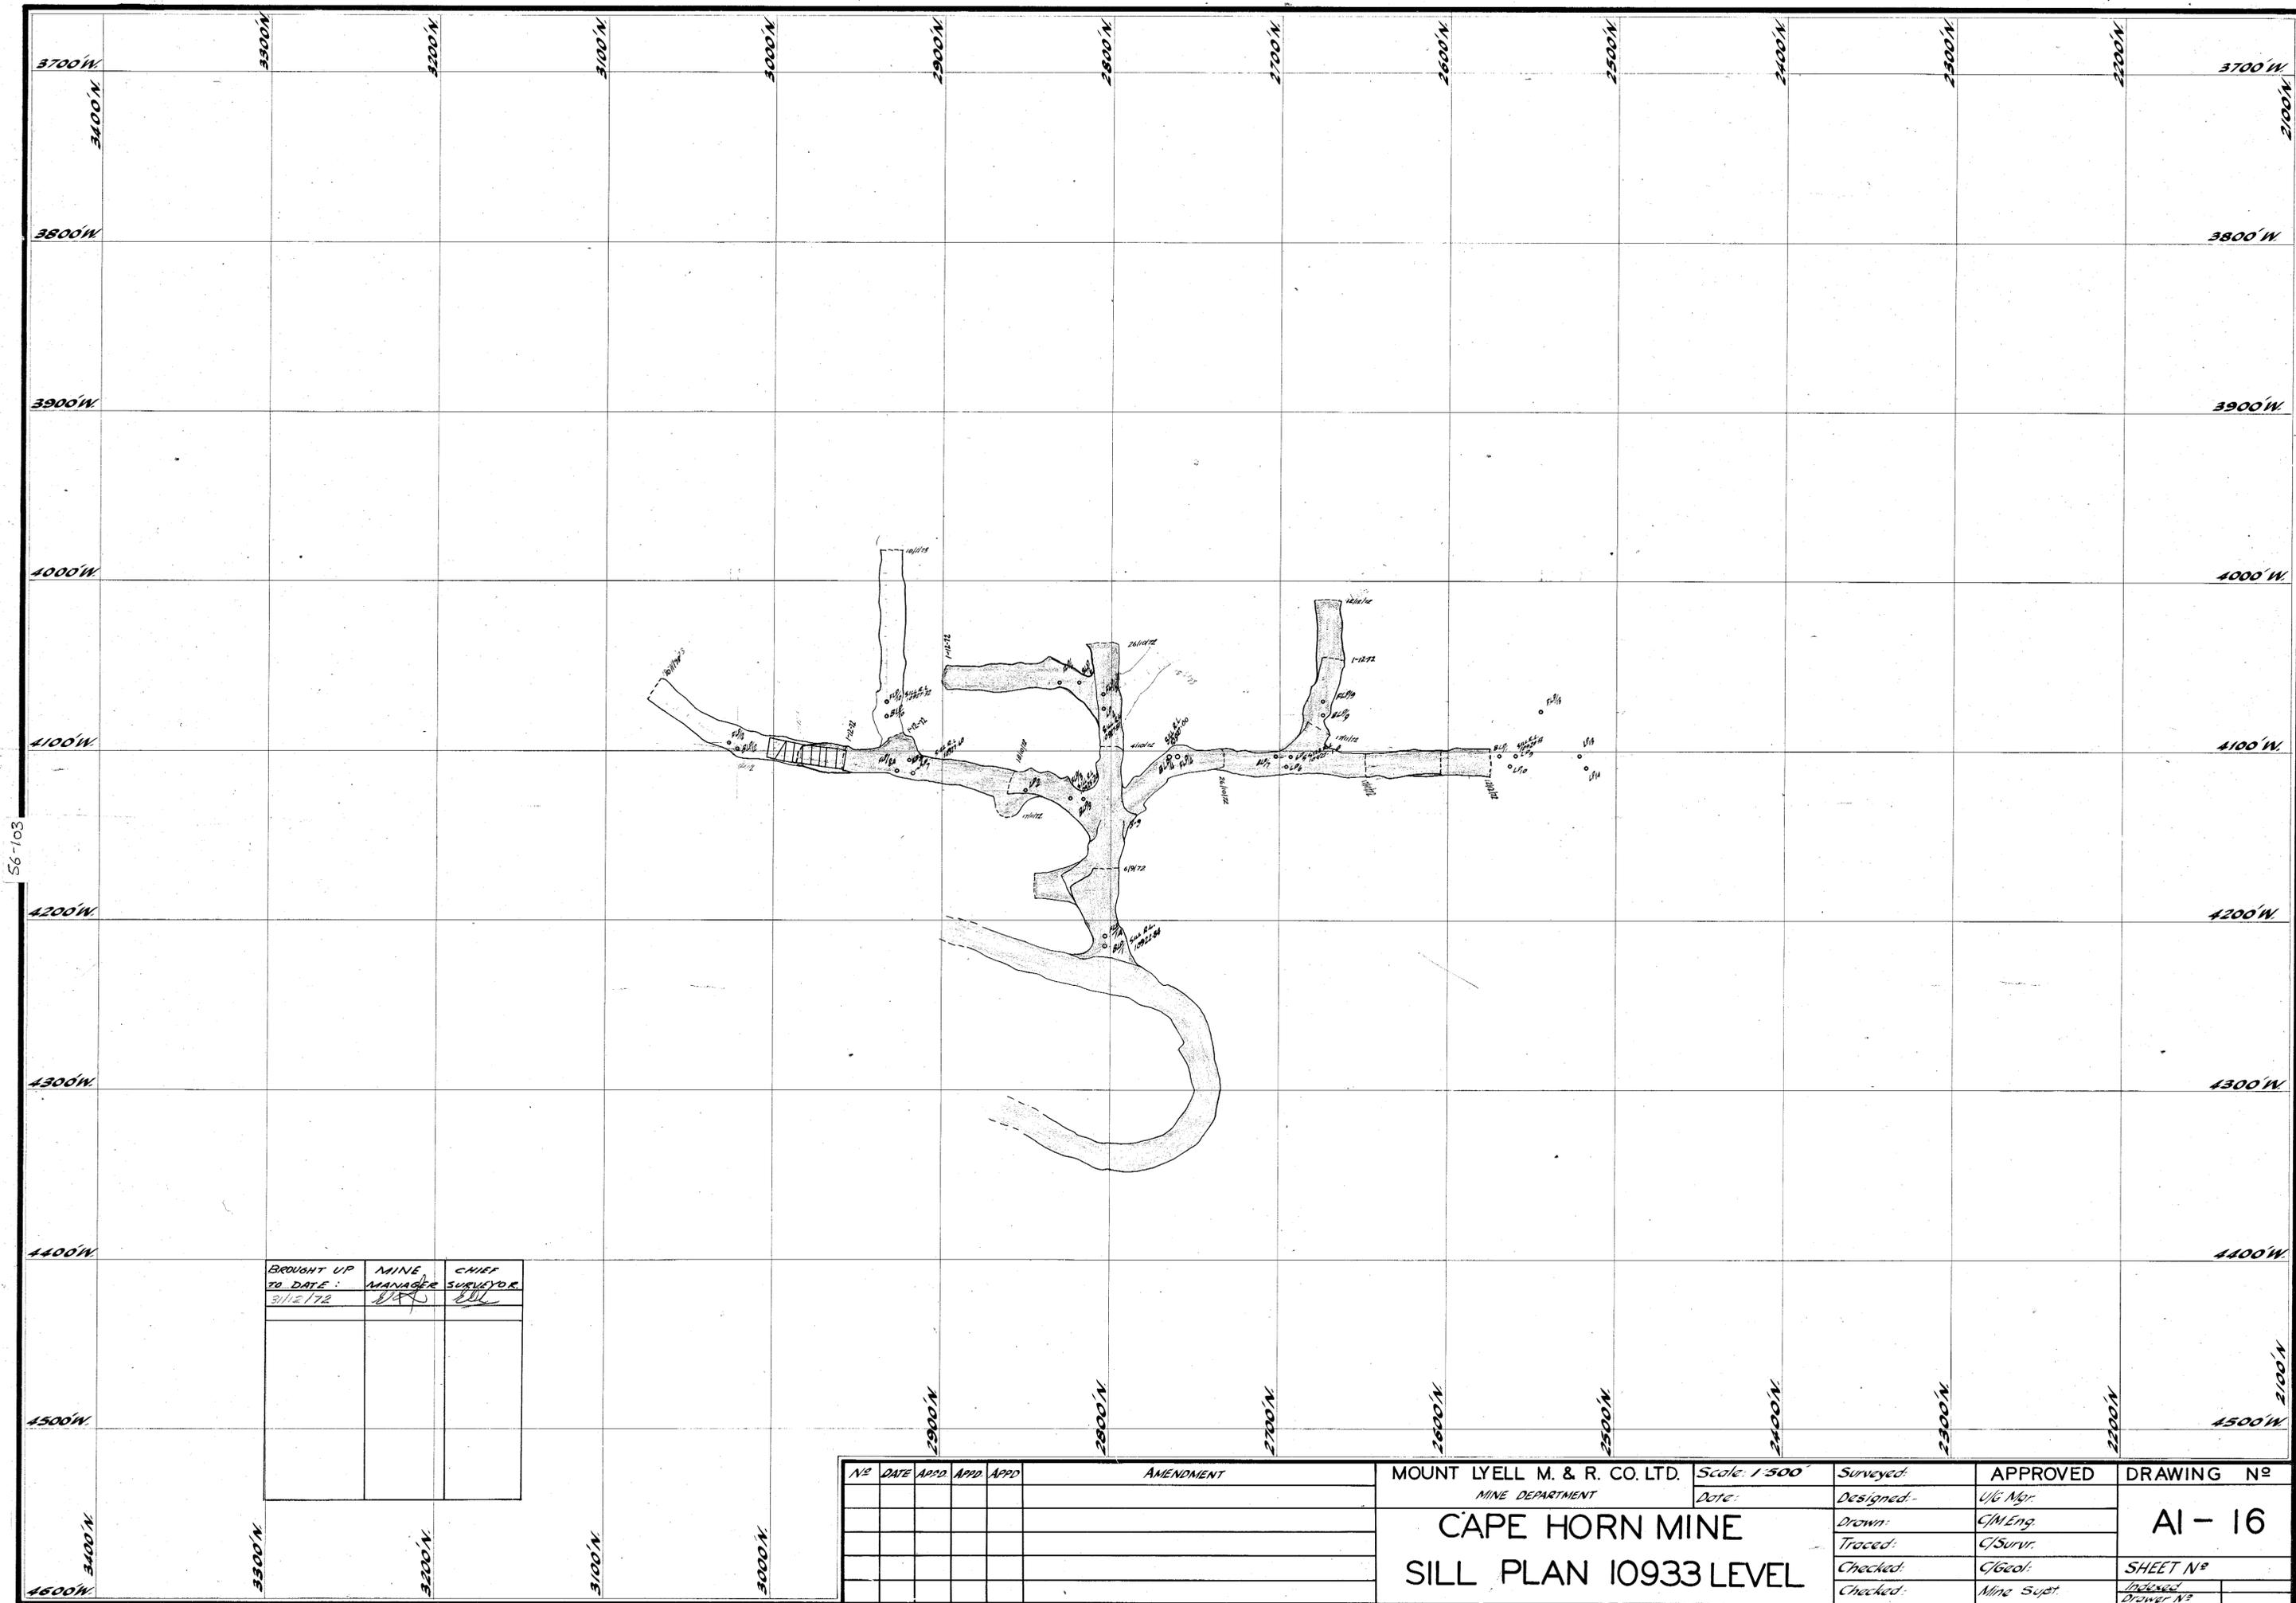

56-103

BROUGHT UP TO DATE:	MINE MANAGER	CHIEF SURVEYOR
3/11/72	<i>[Signature]</i>	<i>[Signature]</i>

№	DATE	APPD.	APPD.	APPD.	AMENDMENT

MOUNT LYELL M. & R. CO. LTD.
MINE DEPARTMENT

**CAPE HORN MINE
SILL PLAN 10933 LEVEL**

Scale: 1/500
Date:

Surveyed:	APPROVED
Designed:	U/G Mgr.
Drawn:	C/M Eng.
Traced:	C/Surv.
Checked:	C/Geol.
Checked:	Mine Supt.

DRAWING №	AI-16
SHEET №	
Indexed	
Drawn №	

5 cm