


56-104

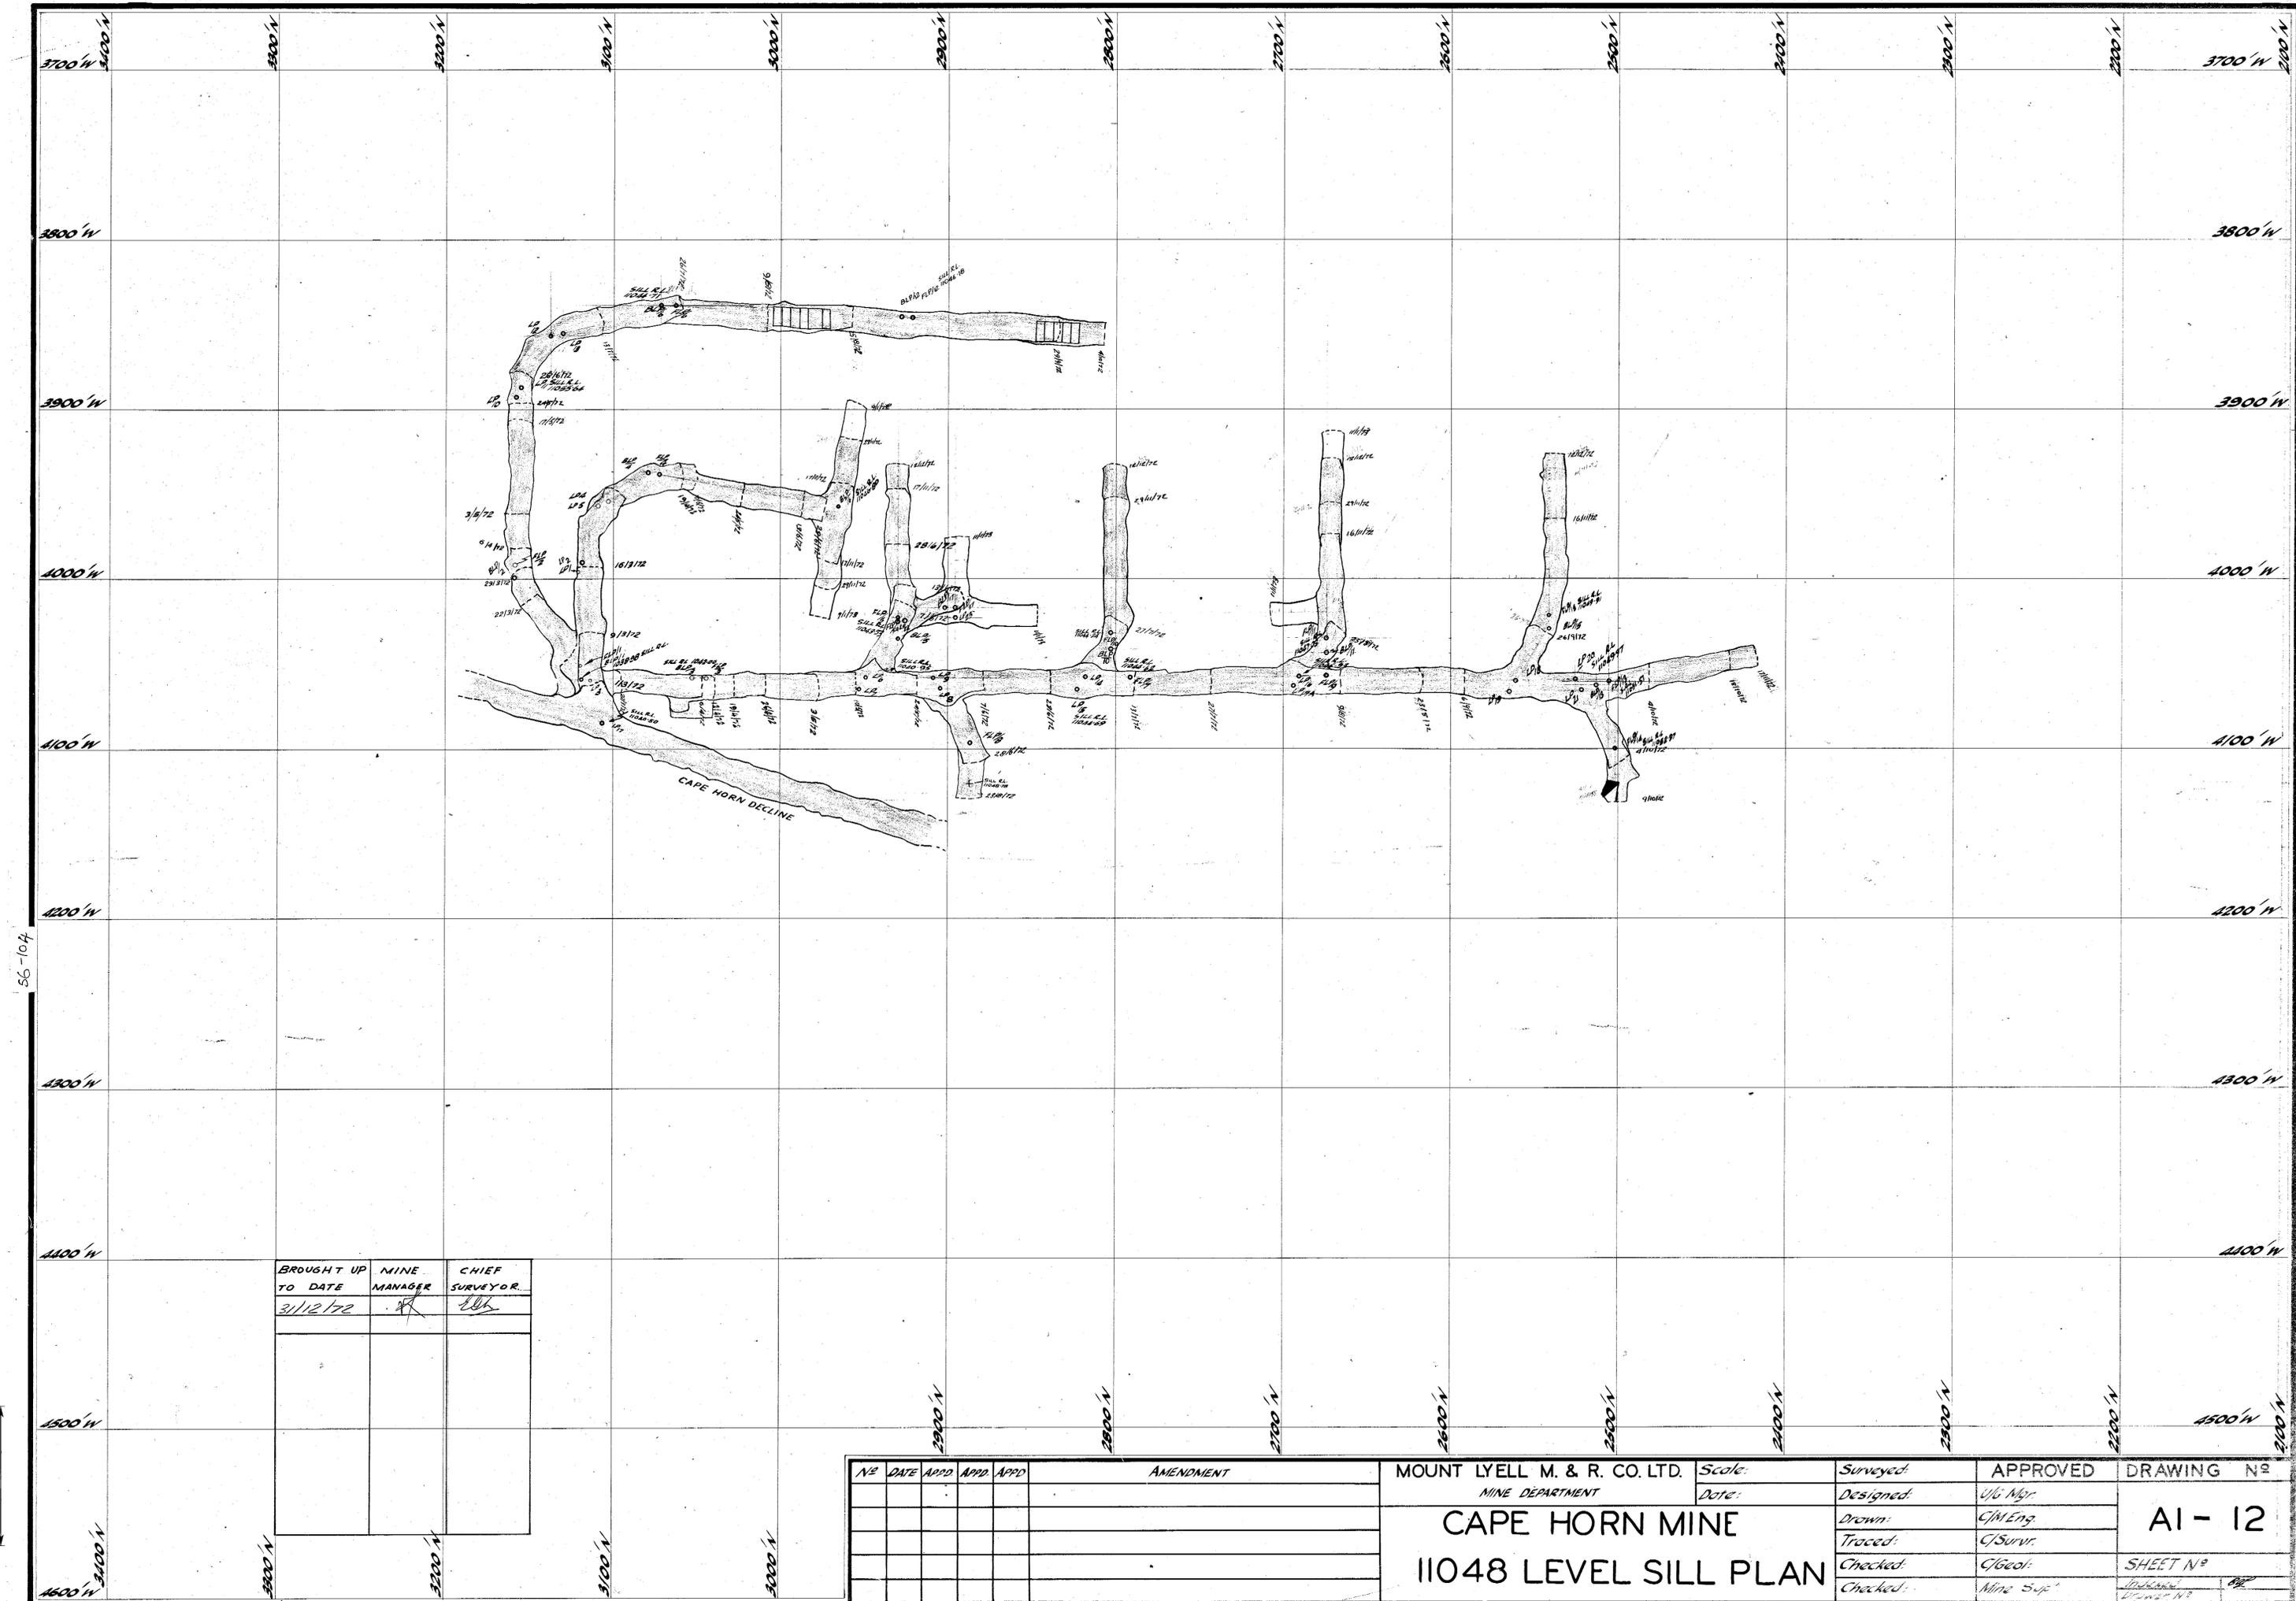

BROUGHT UP TO DATE	MINE MANAGER	CHIEF SURVEYOR
3/1/12/72	[Signature]	[Signature]

NO	DATE	APPD	APPD	APPD	AMENDMENT

MOUNT LYELL M. & R. CO. LTD. MINE DEPARTMENT		Scale:	Surveyed:	APPROVED	DRAWING N ^o
CAPE HORN MINE 11048 LEVEL SILL PLAN		Date:	Designed:	U/Li Mgr.	A1-12
			Drawn:	C/M Eng.	
			Traced:	C/Surv.	SHEET N ^o
			Checked:	C/Geo.	[Signature]
			Checked:	Mine Sup.	[Signature]

5 cm