


56-105

56-105

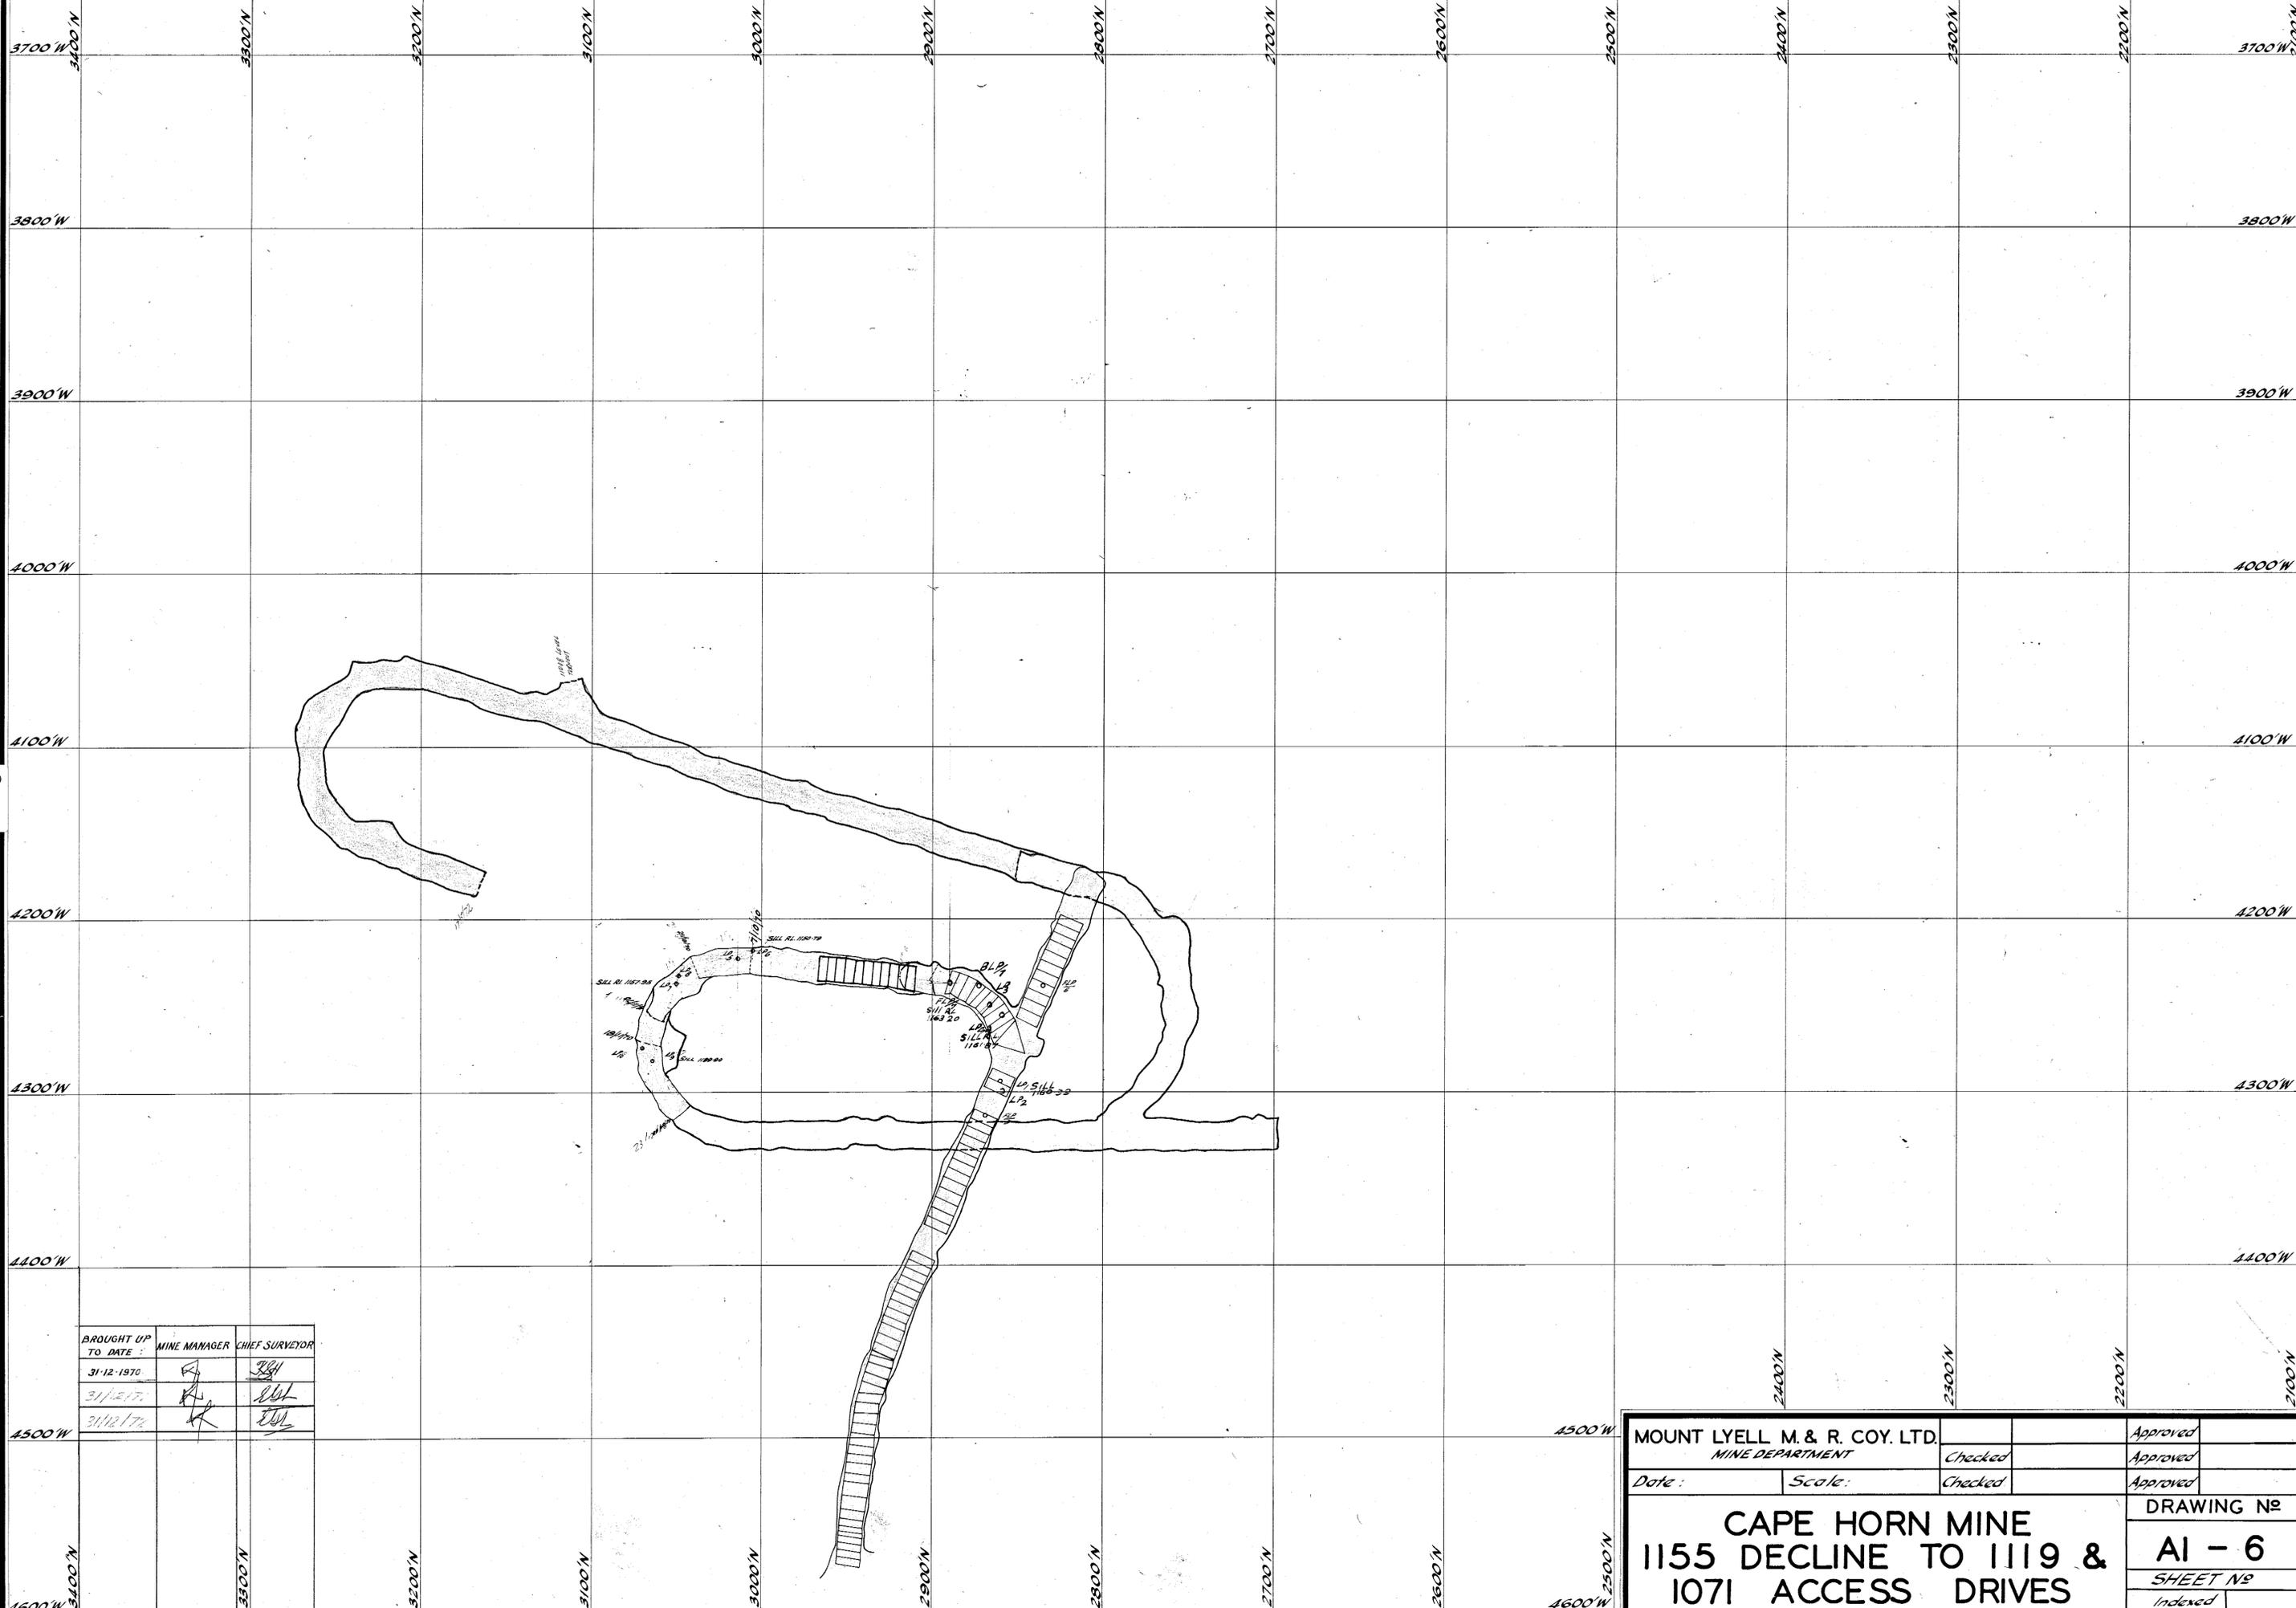

BROUGHT UP TO DATE :	MINE MANAGER	CHIEF SURVEYOR
31-12-1970	[Signature]	[Signature]
31/12/71	[Signature]	[Signature]
31/12/72	[Signature]	[Signature]

MOUNT LYELL M. & R. COY. LTD.		Approved
MINE DEPARTMENT		Checked
Date:	Scale:	Checked
<b>CAPE HORN MINE</b> <b>1155 DECLINE TO 1119 &amp;</b> <b>1071 ACCESS DRIVES</b>		DRAWING No
		<b>AI - 6</b>
		SHEET No
		Indexed