


56-106

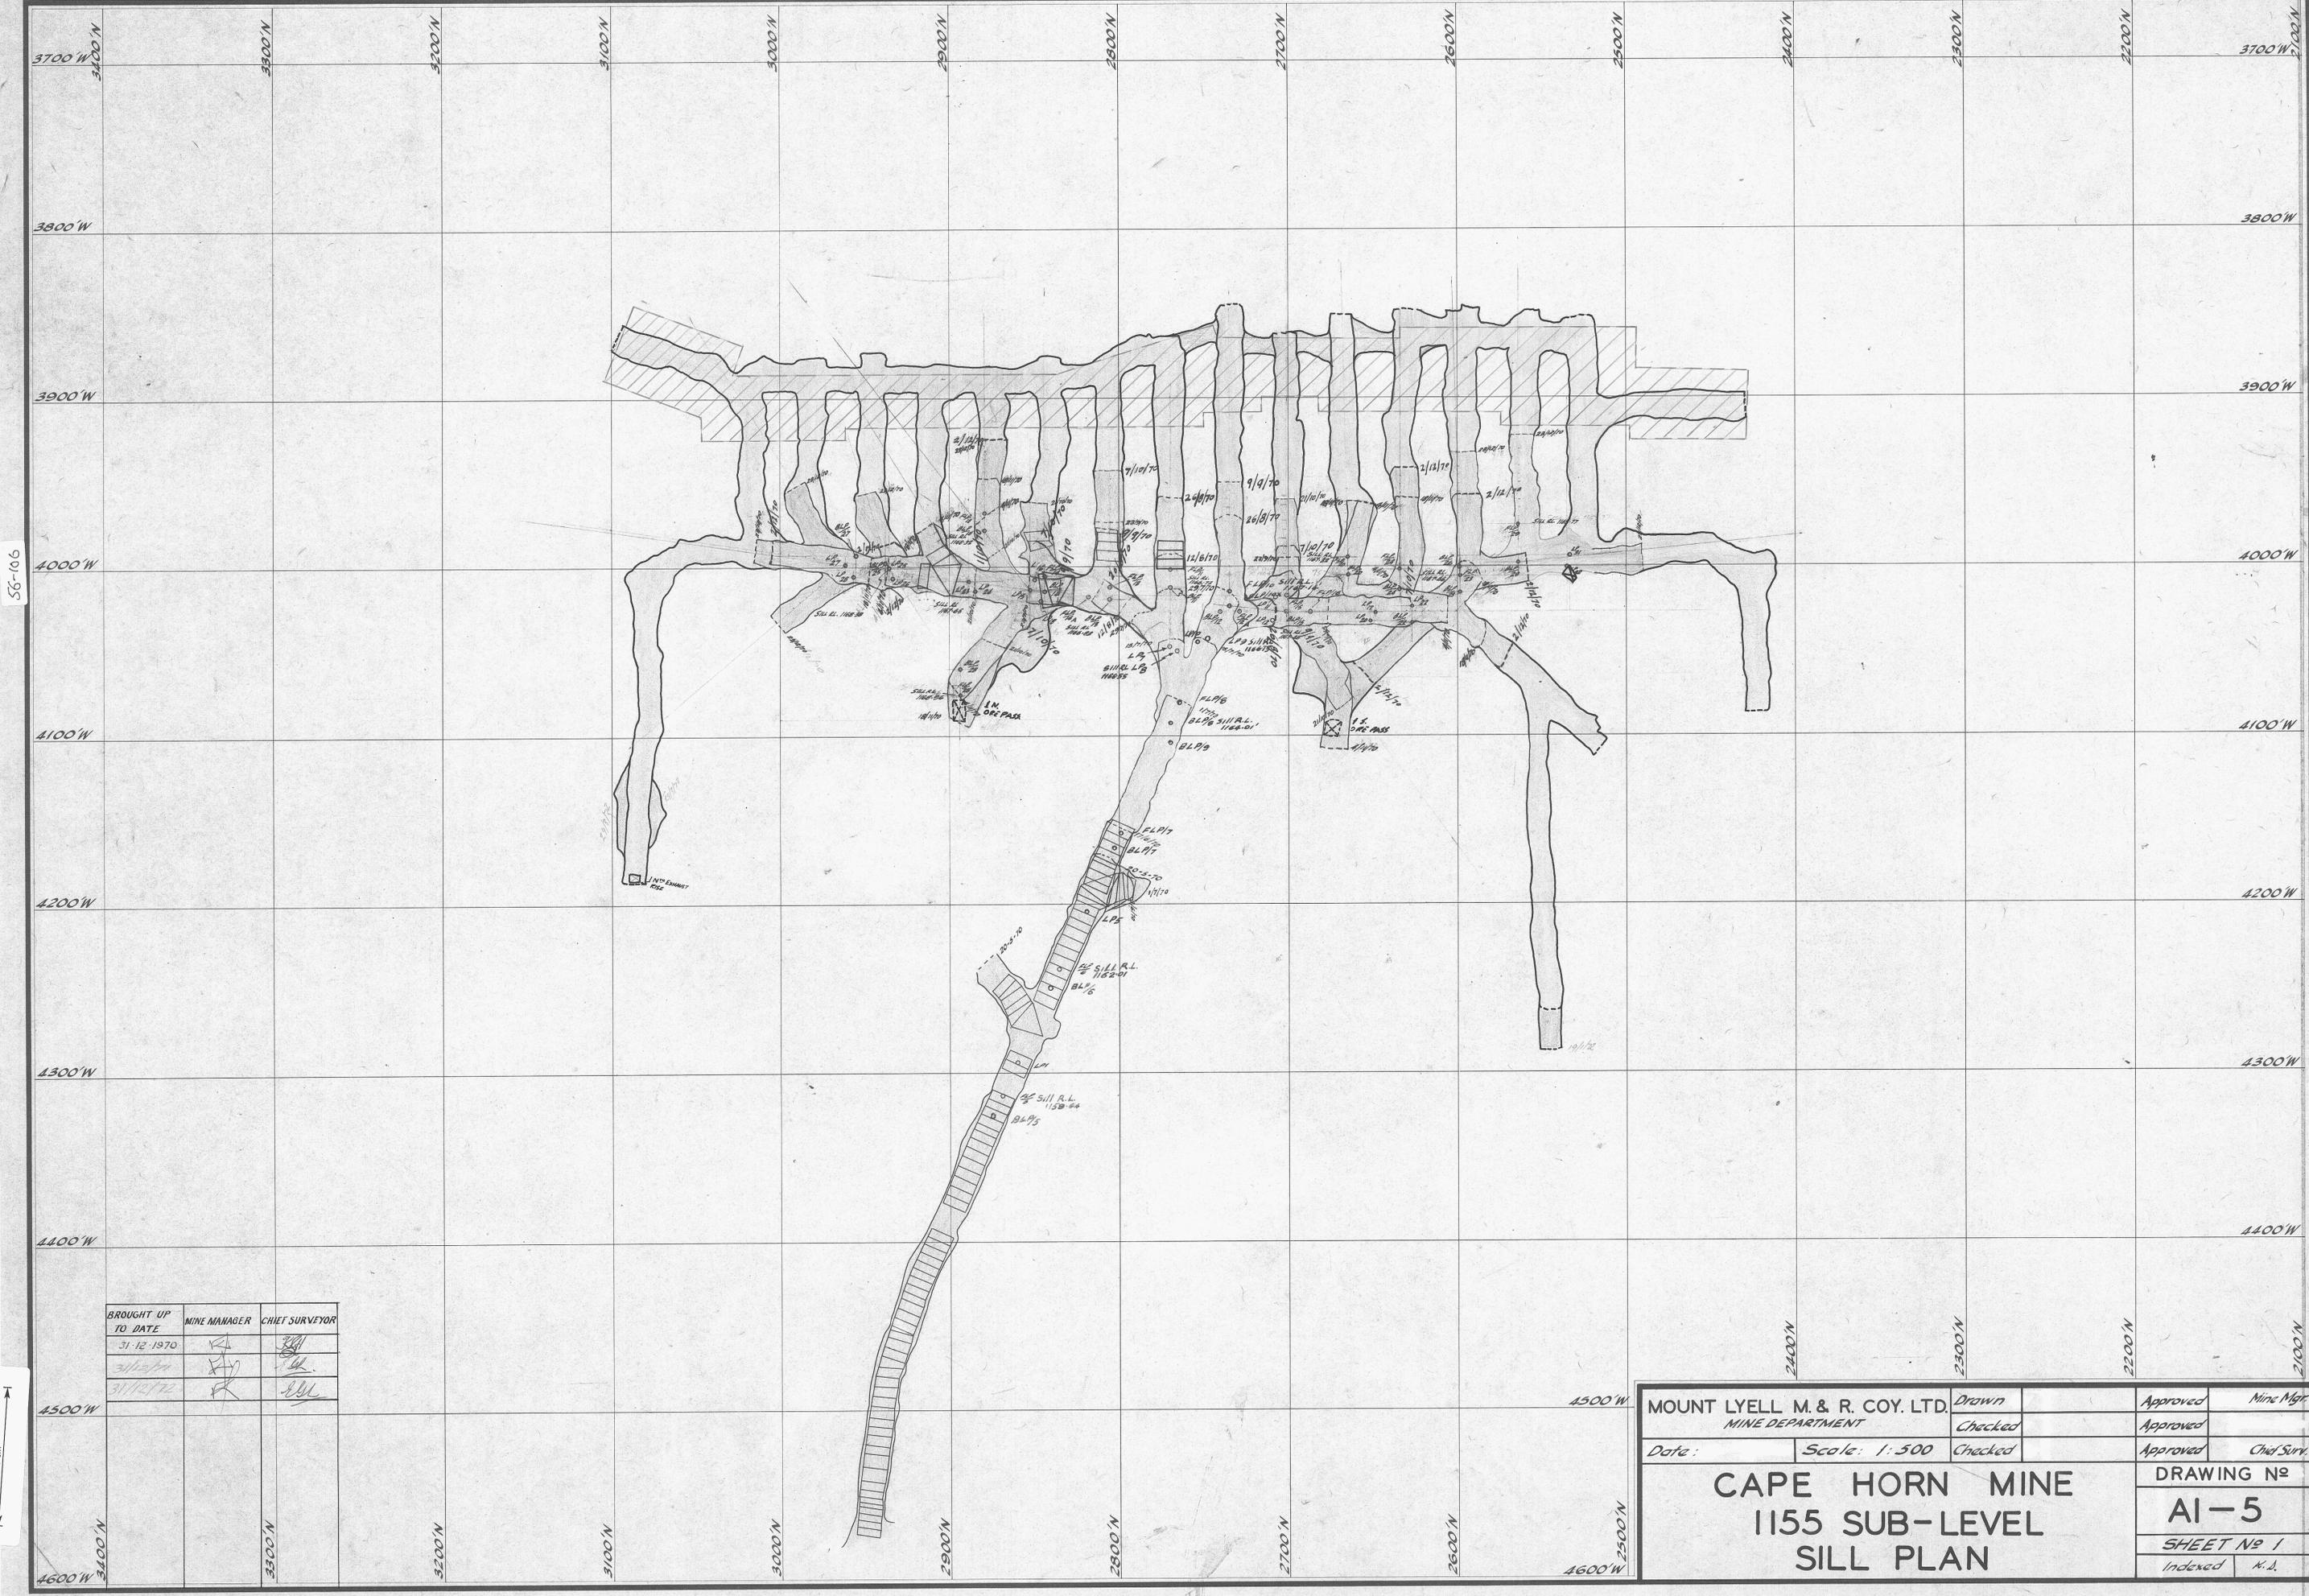

BROUGHT UP TO DATE	MINE MANAGER	CHIEF SURVEYOR
31-12-1970	[Signature]	[Signature]
3/11/71	[Signature]	[Signature]
31/12/72	[Signature]	[Signature]

MOUNT LYELL M. & R. COY. LTD. MINE DEPARTMENT	Drawn	Approved	Mine Mgr
Date:	Checked	Approved	
Scale: 1:500	Checked	Approved	Chief Surv.
CAPE HORN MINE 1155 SUB-LEVEL SILL PLAN			DRAWING N ^o
			AI-5
			SHEET N ^o 1
		Indexed	N.S.