


56-108

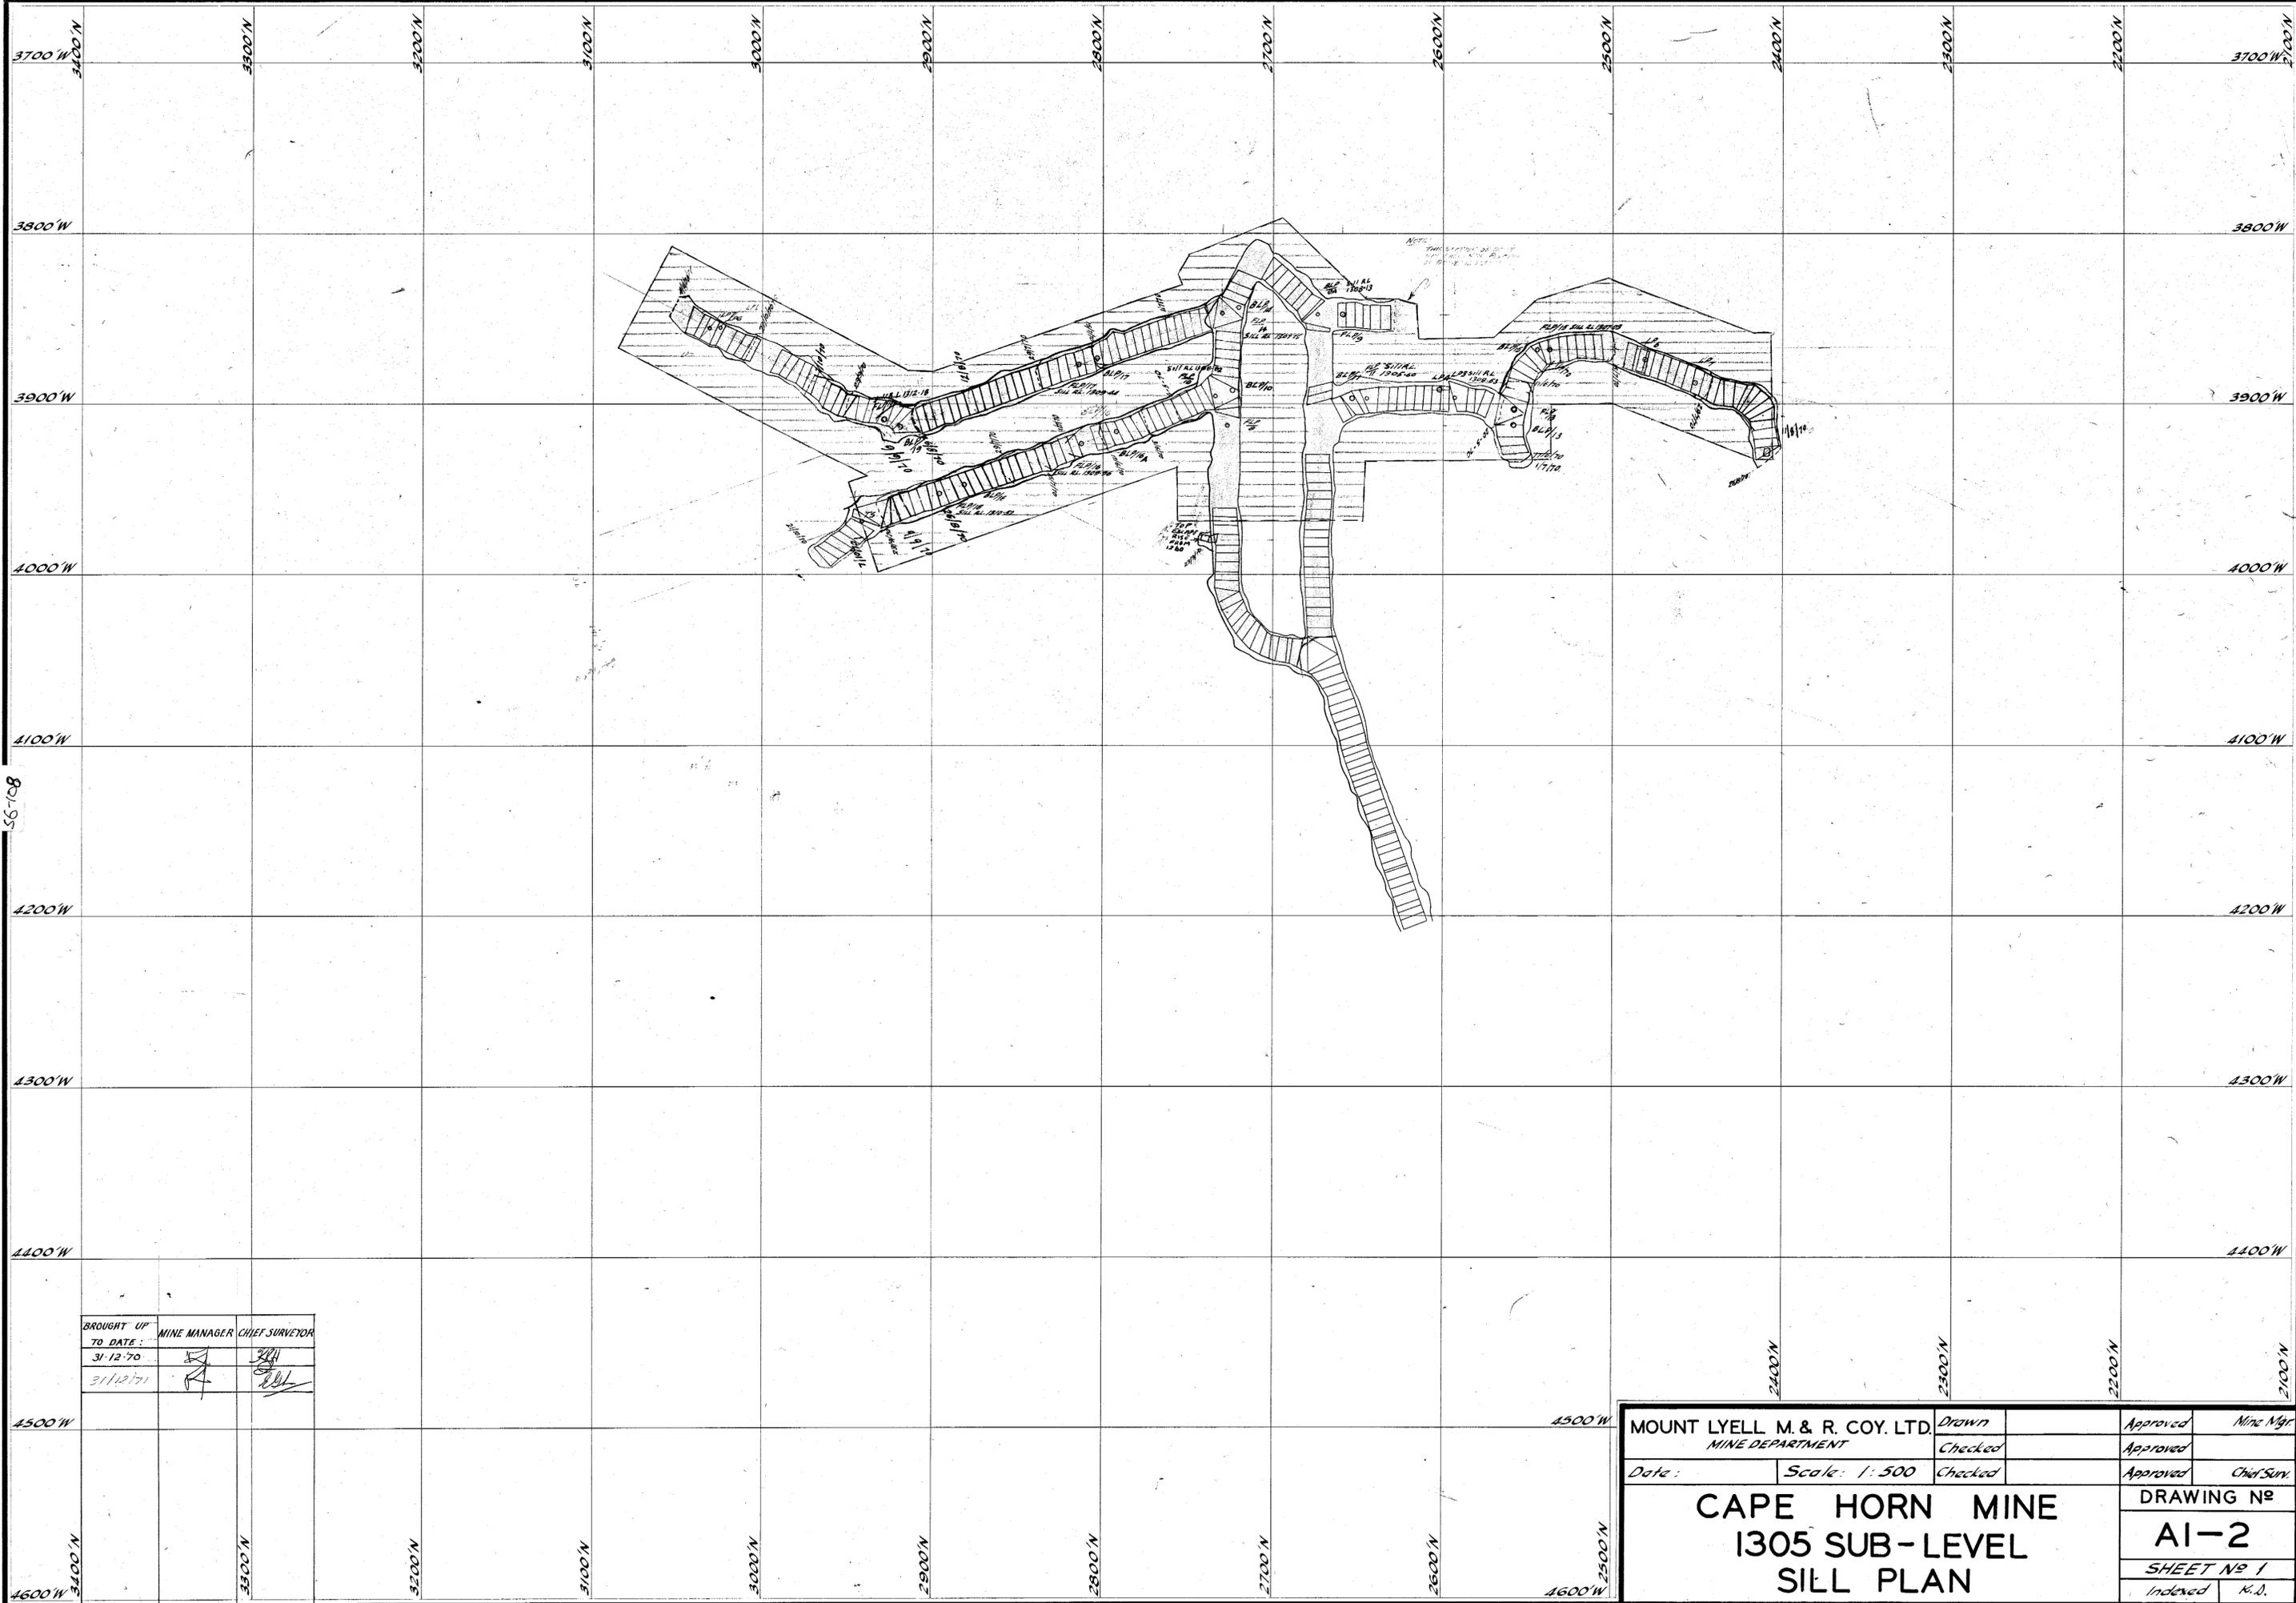

56-108

BROUGHT UP TO DATE:	MINE MANAGER	CHIEF SURVEYOR
31-12-70	<i>[Signature]</i>	<i>[Signature]</i>
31/12/71	<i>[Signature]</i>	<i>[Signature]</i>

5 cm

MOUNT LYELL M. & R. COY. LTD.		Drawn	Approved	Mine Mgr.
MINE DEPARTMENT		Checked	Approved	
Date:	Scale: 1:500	Checked	Approved	Chief Surv.
CAPE HORN MINE 1305 SUB-LEVEL SILL PLAN				DRAWING No
AI-2				SHEET No 1
Indexed				K.D.