


56-10

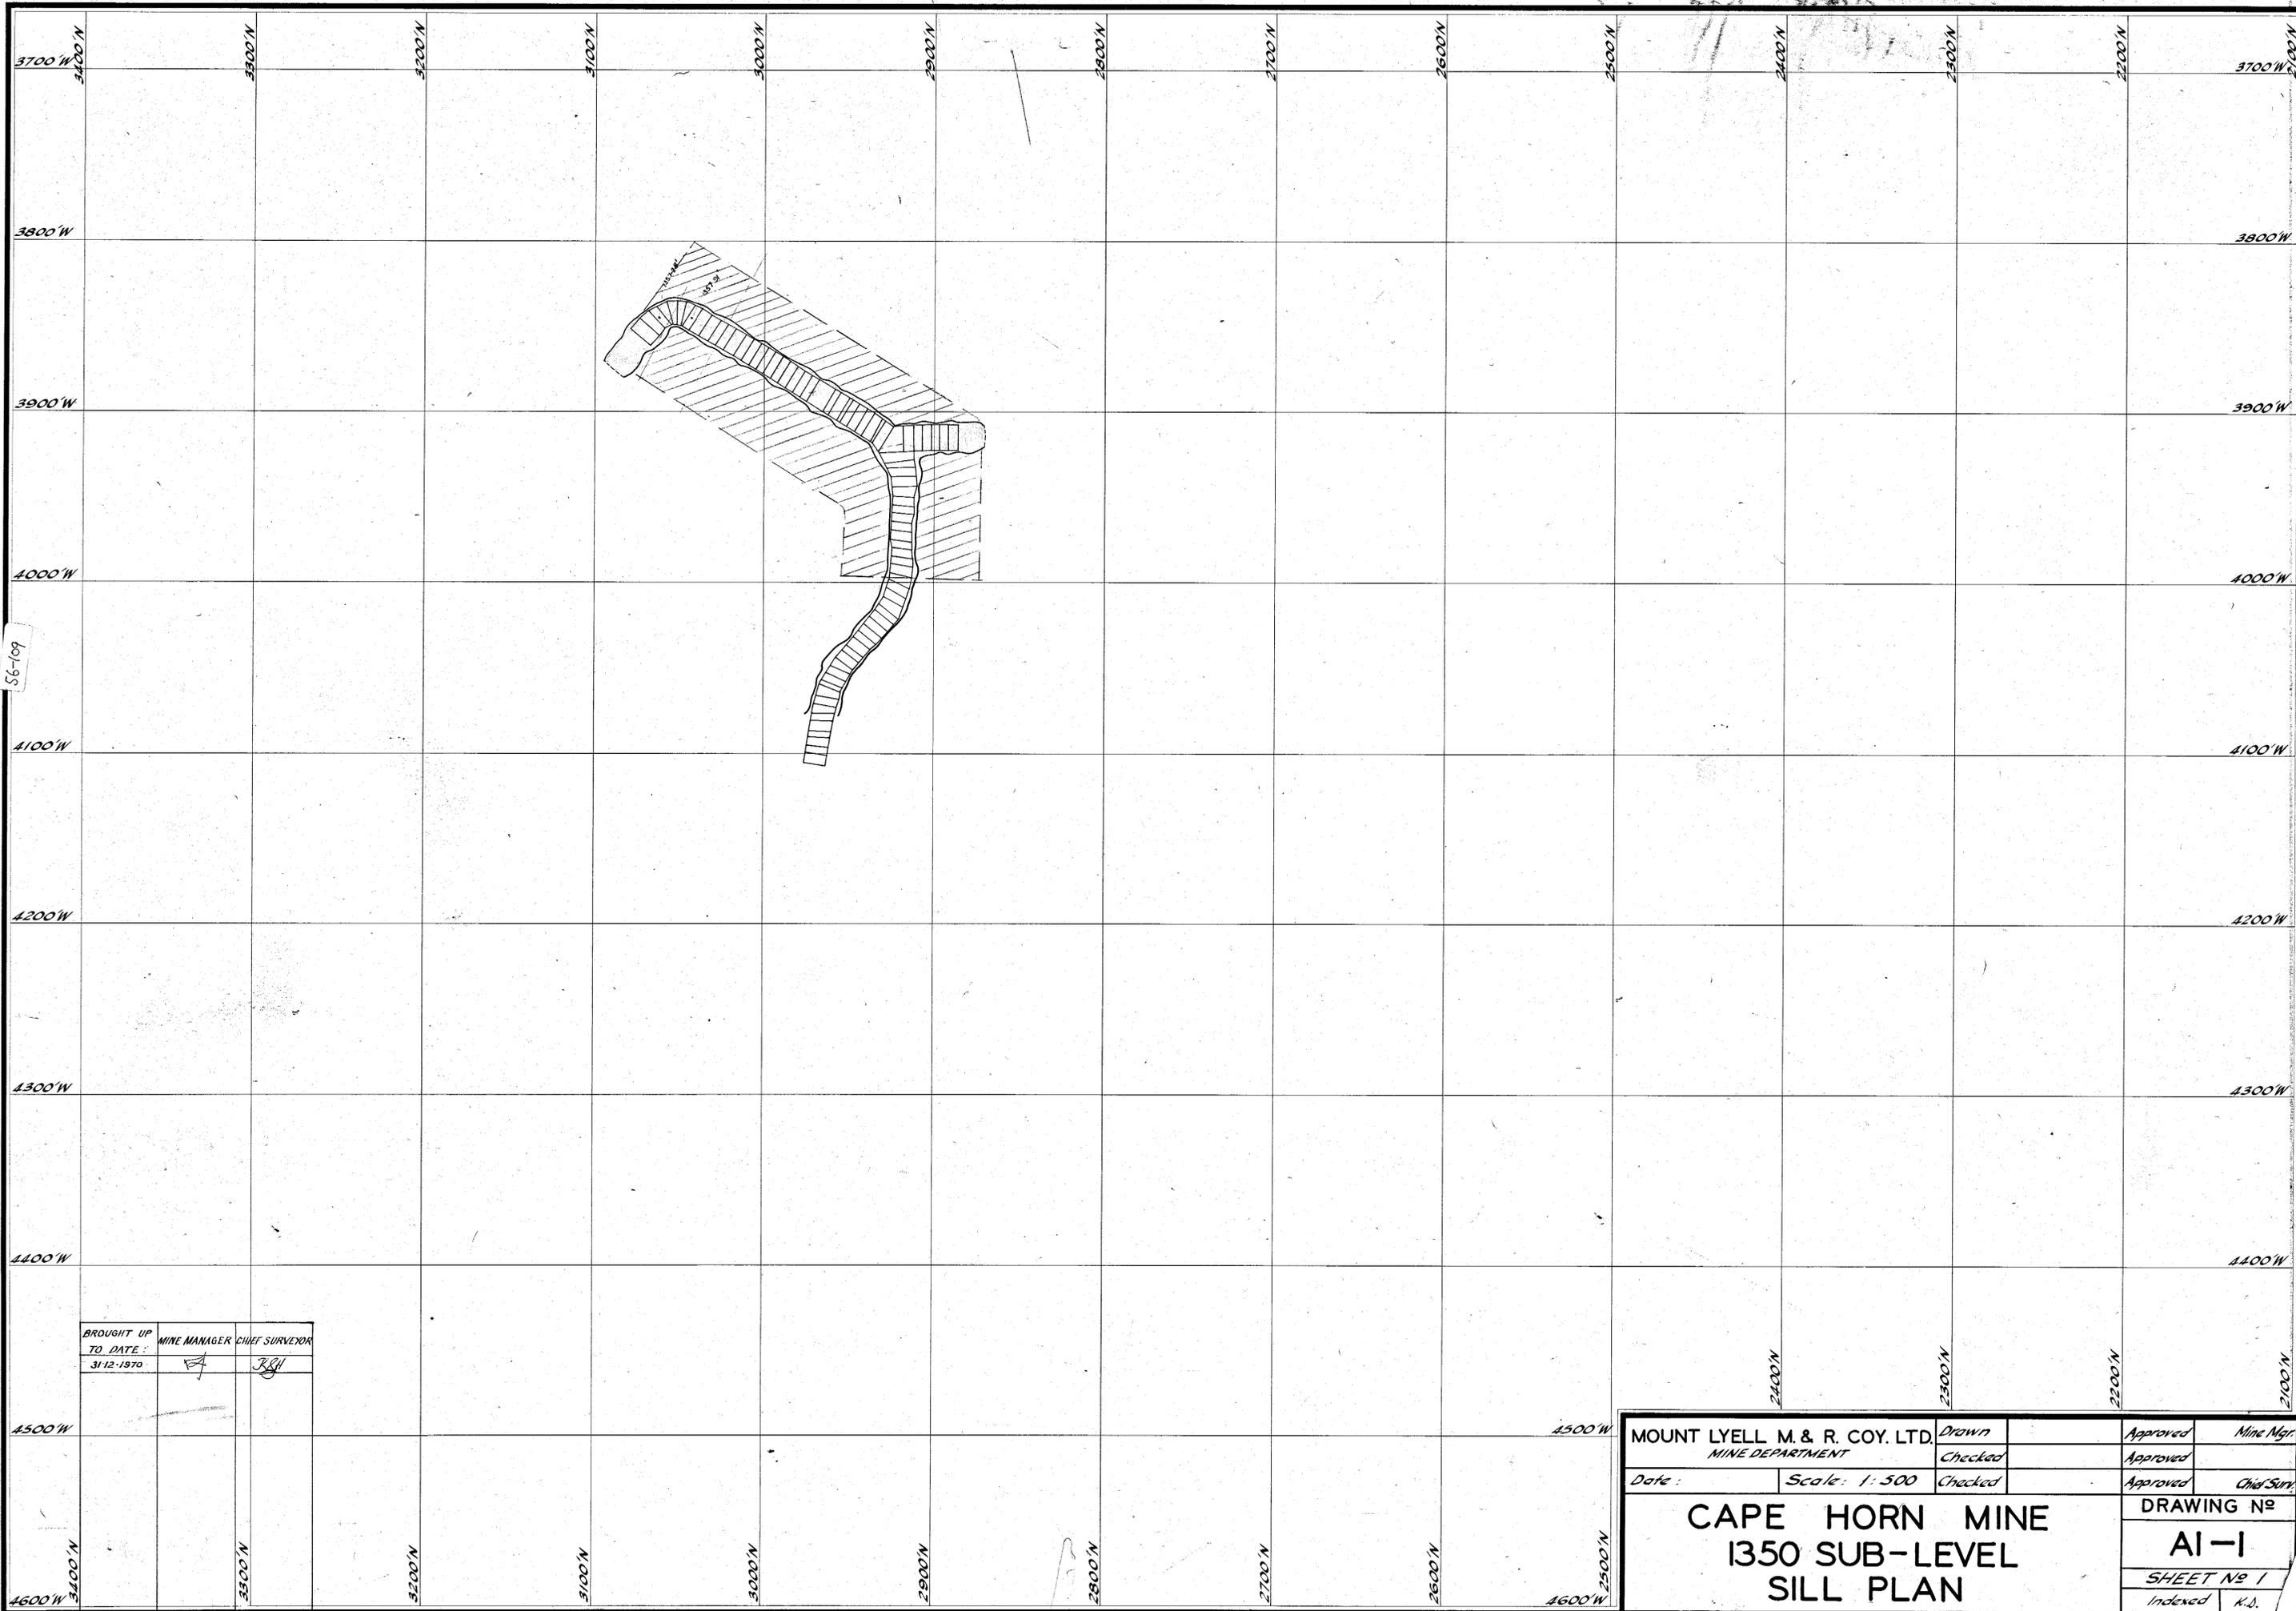

BROUGHT UP TO DATE :	MINE MANAGER	CHIEF SURVEYOR
31/12-1970	[Signature]	[Signature]

5 cm

MOUNT LYELL M & R. COY. LTD.	Drawn	Approved	Mine Mgr.
MINE DEPARTMENT	Checked	Approved	
Date :	Scale: 1:500	Checked	Approved
CAPE HORN MINE			DRAWING NO
1350 SUB-LEVEL			AI-1
SILL PLAN			SHEET NO 1
			Indexed
			K.D.