


56-114

56-114

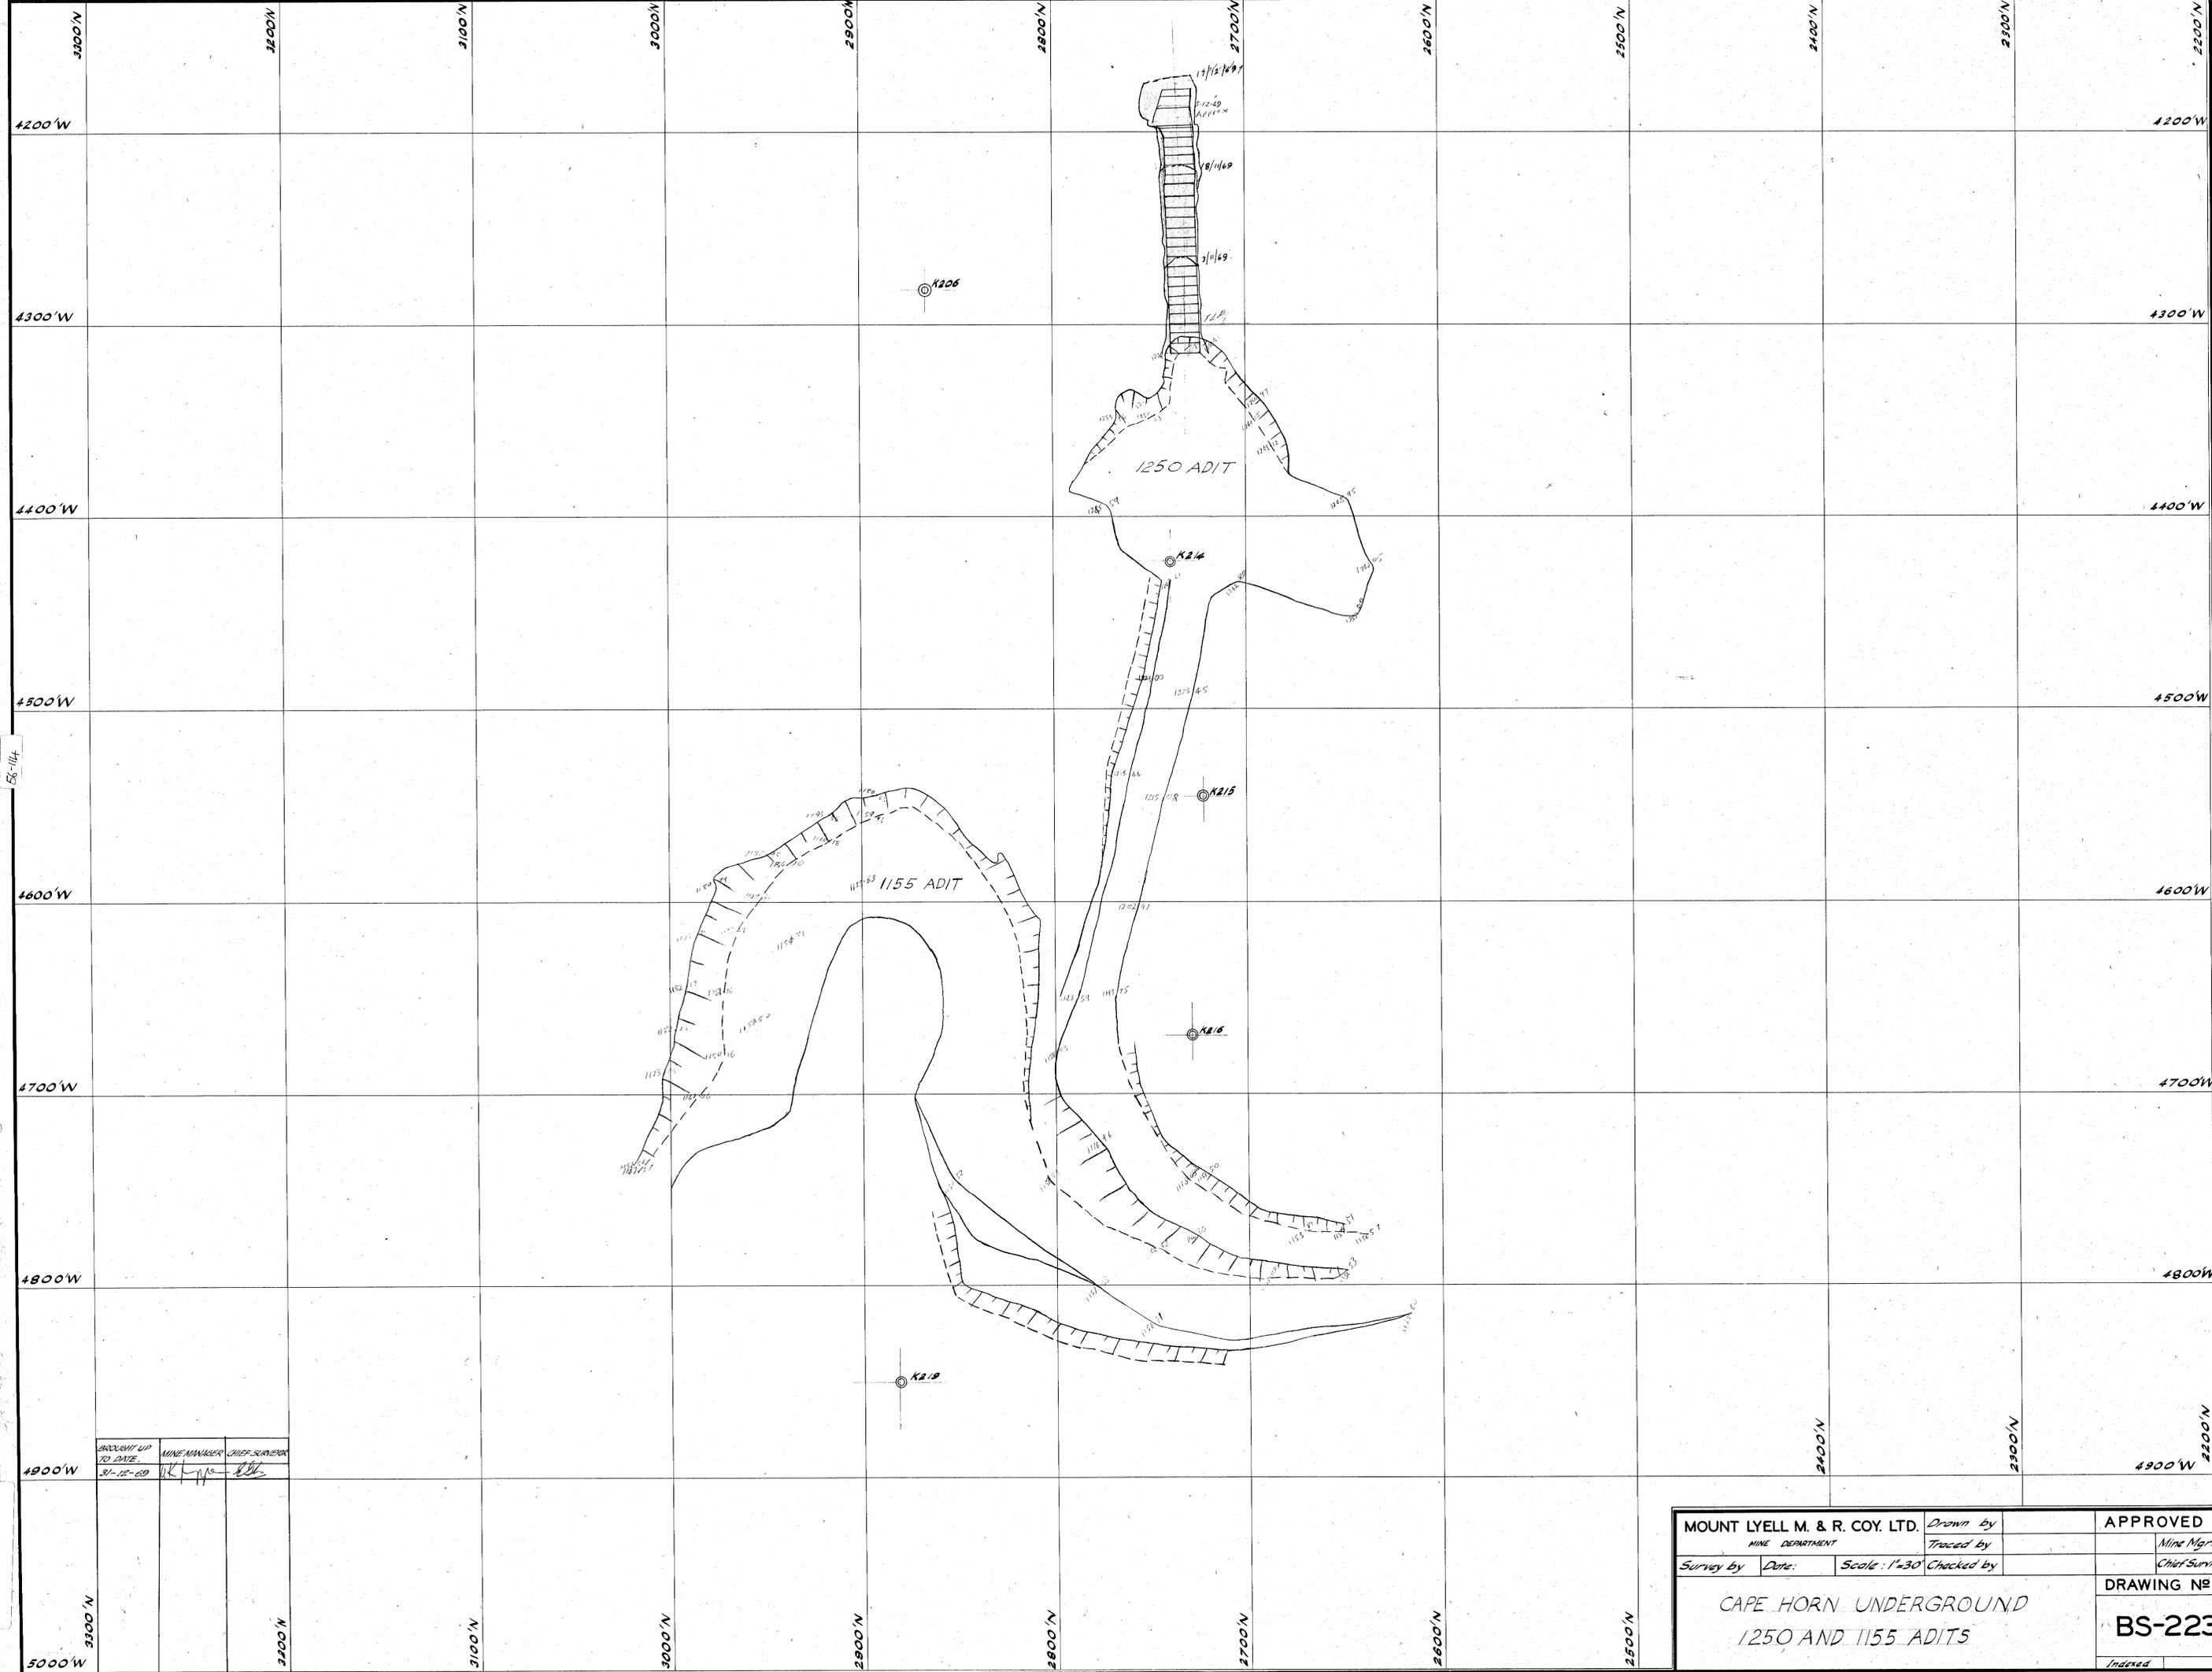

APPROVED UP TO DATE	MINER MANAGER	CHIEF SURVEYOR
3/1-15-69	[Signature]	[Signature]

MOUNT LYELL M. & R. COY. LTD.			Drawn by		APPROVED
MINE DEPARTMENT			Traced by		Mine Mgr
Survey by	Date:	Scale: 1"=30'	Checked by		Chief Surv
CAPE HORN UNDERGROUND					DRAWING No
1250 AND 1155 ADITS					BS-223
					Indexed