


56-116

56-116

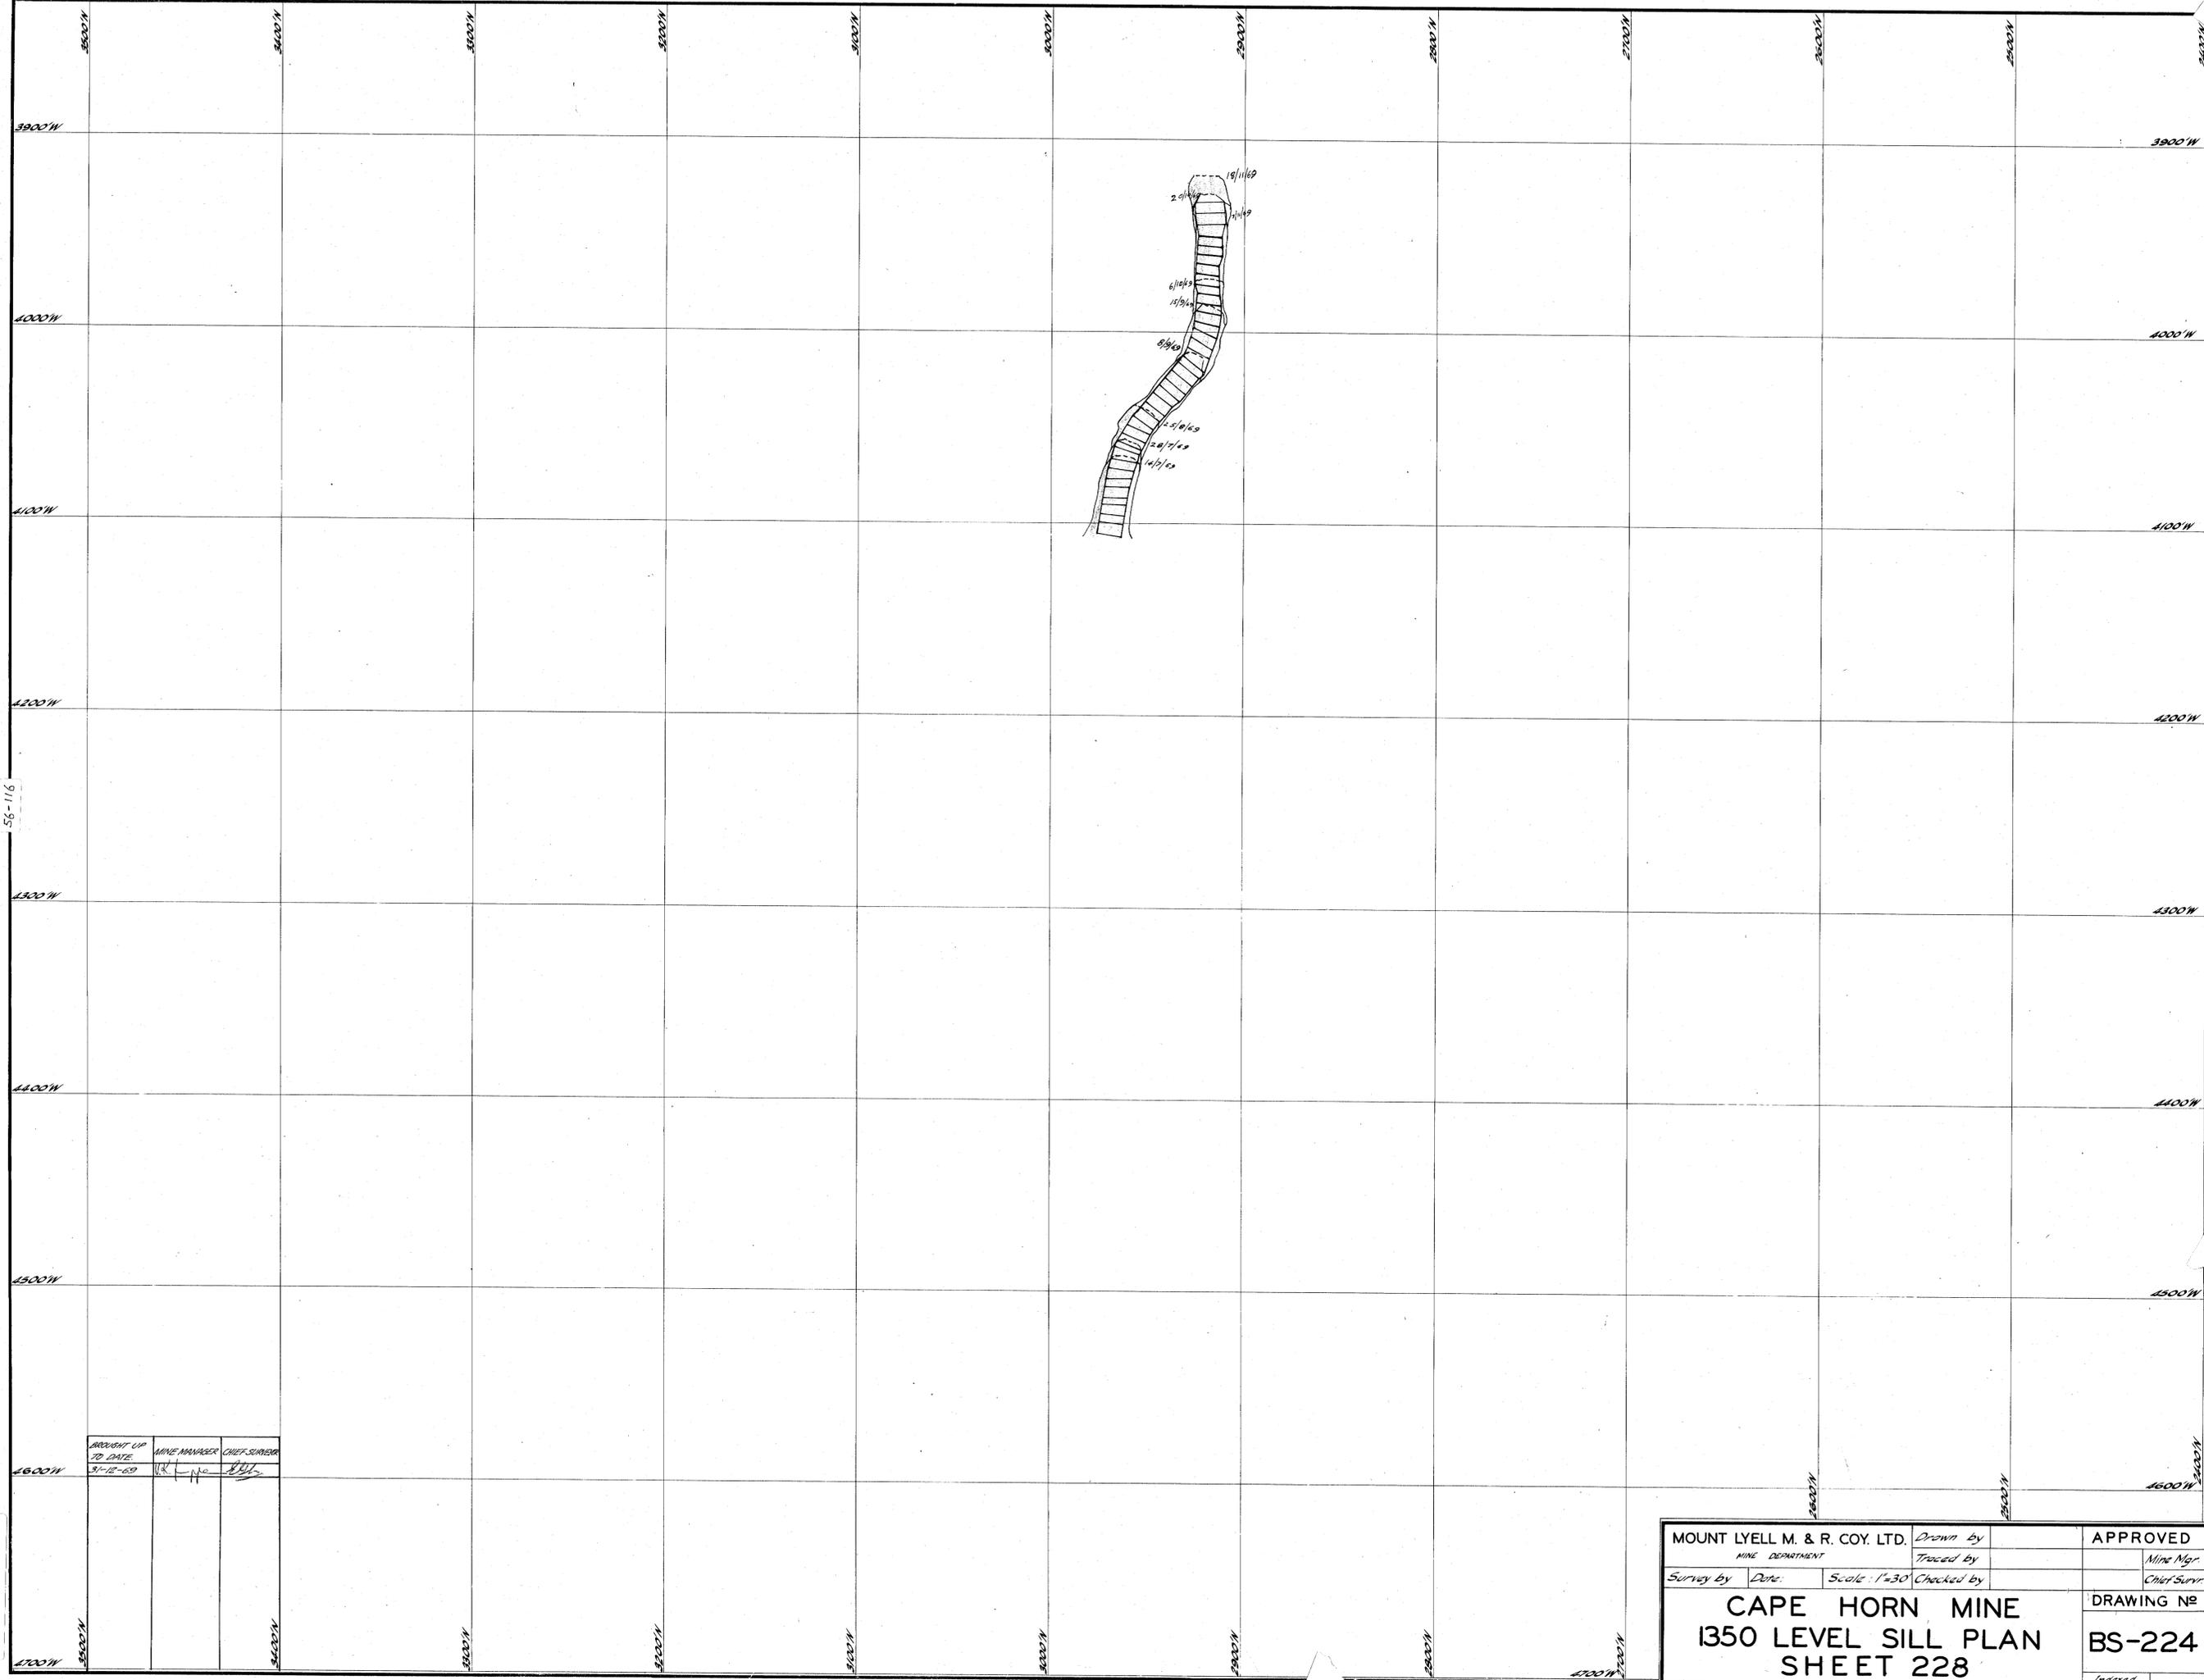

BROUGHT UP TO DATE	MINER MANAGER	CHIEF SURVEYOR
31-12-60	W. L. No.	[Signature]

MOUNT LYELL M. & R. COY. LTD.		Drawn by	APPROVED
MINE DEPARTMENT		Traced by	Mine Mgr
Survey by	Date	Scale: 1"=30'	Checked by
			Chief Surveyor
CAPE HORN MINE			DRAWING NO
1350 LEVEL SILL PLAN			BS-224
SHEET 228			Traced

5 cm