



55-118

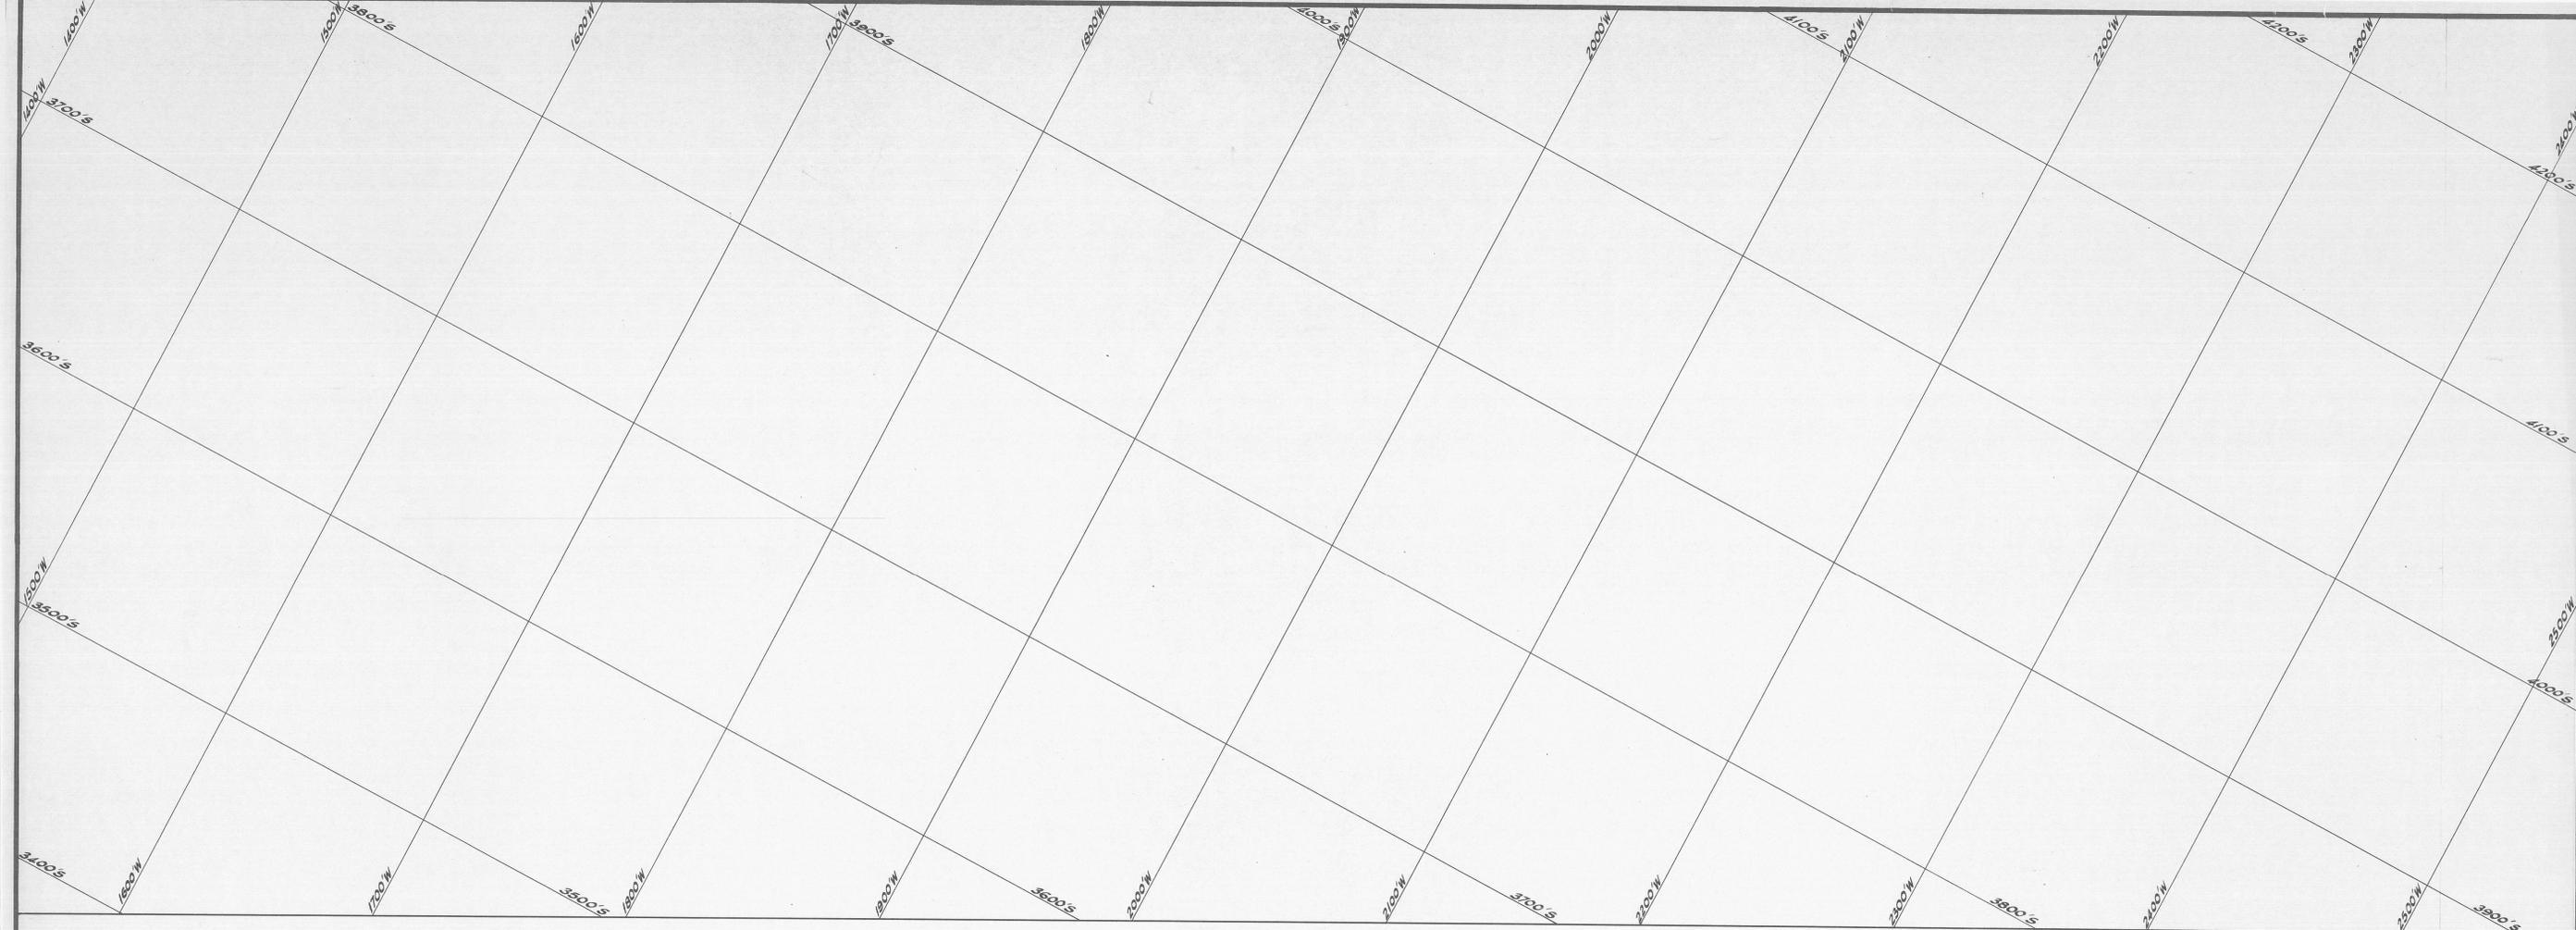

BROUGHT UP TO DATE	MINE MANAGER	CHIEF SURVEYOR
3-15-69	<i>[Signature]</i>	<i>[Signature]</i>

MOUNT LYELL M. & R. COY. LTD.		Drawn by	APPROVED
MINE DEPARTMENT		Traced by	Mine Mgr.
Survey by:	Date: 18-12-68	Scale: 1" = 30'	Checked by
PRINCE LYELL 45/33 DECLINE			DRAWING NO BS-107
			Indexed

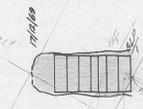

5 cm