


55-119

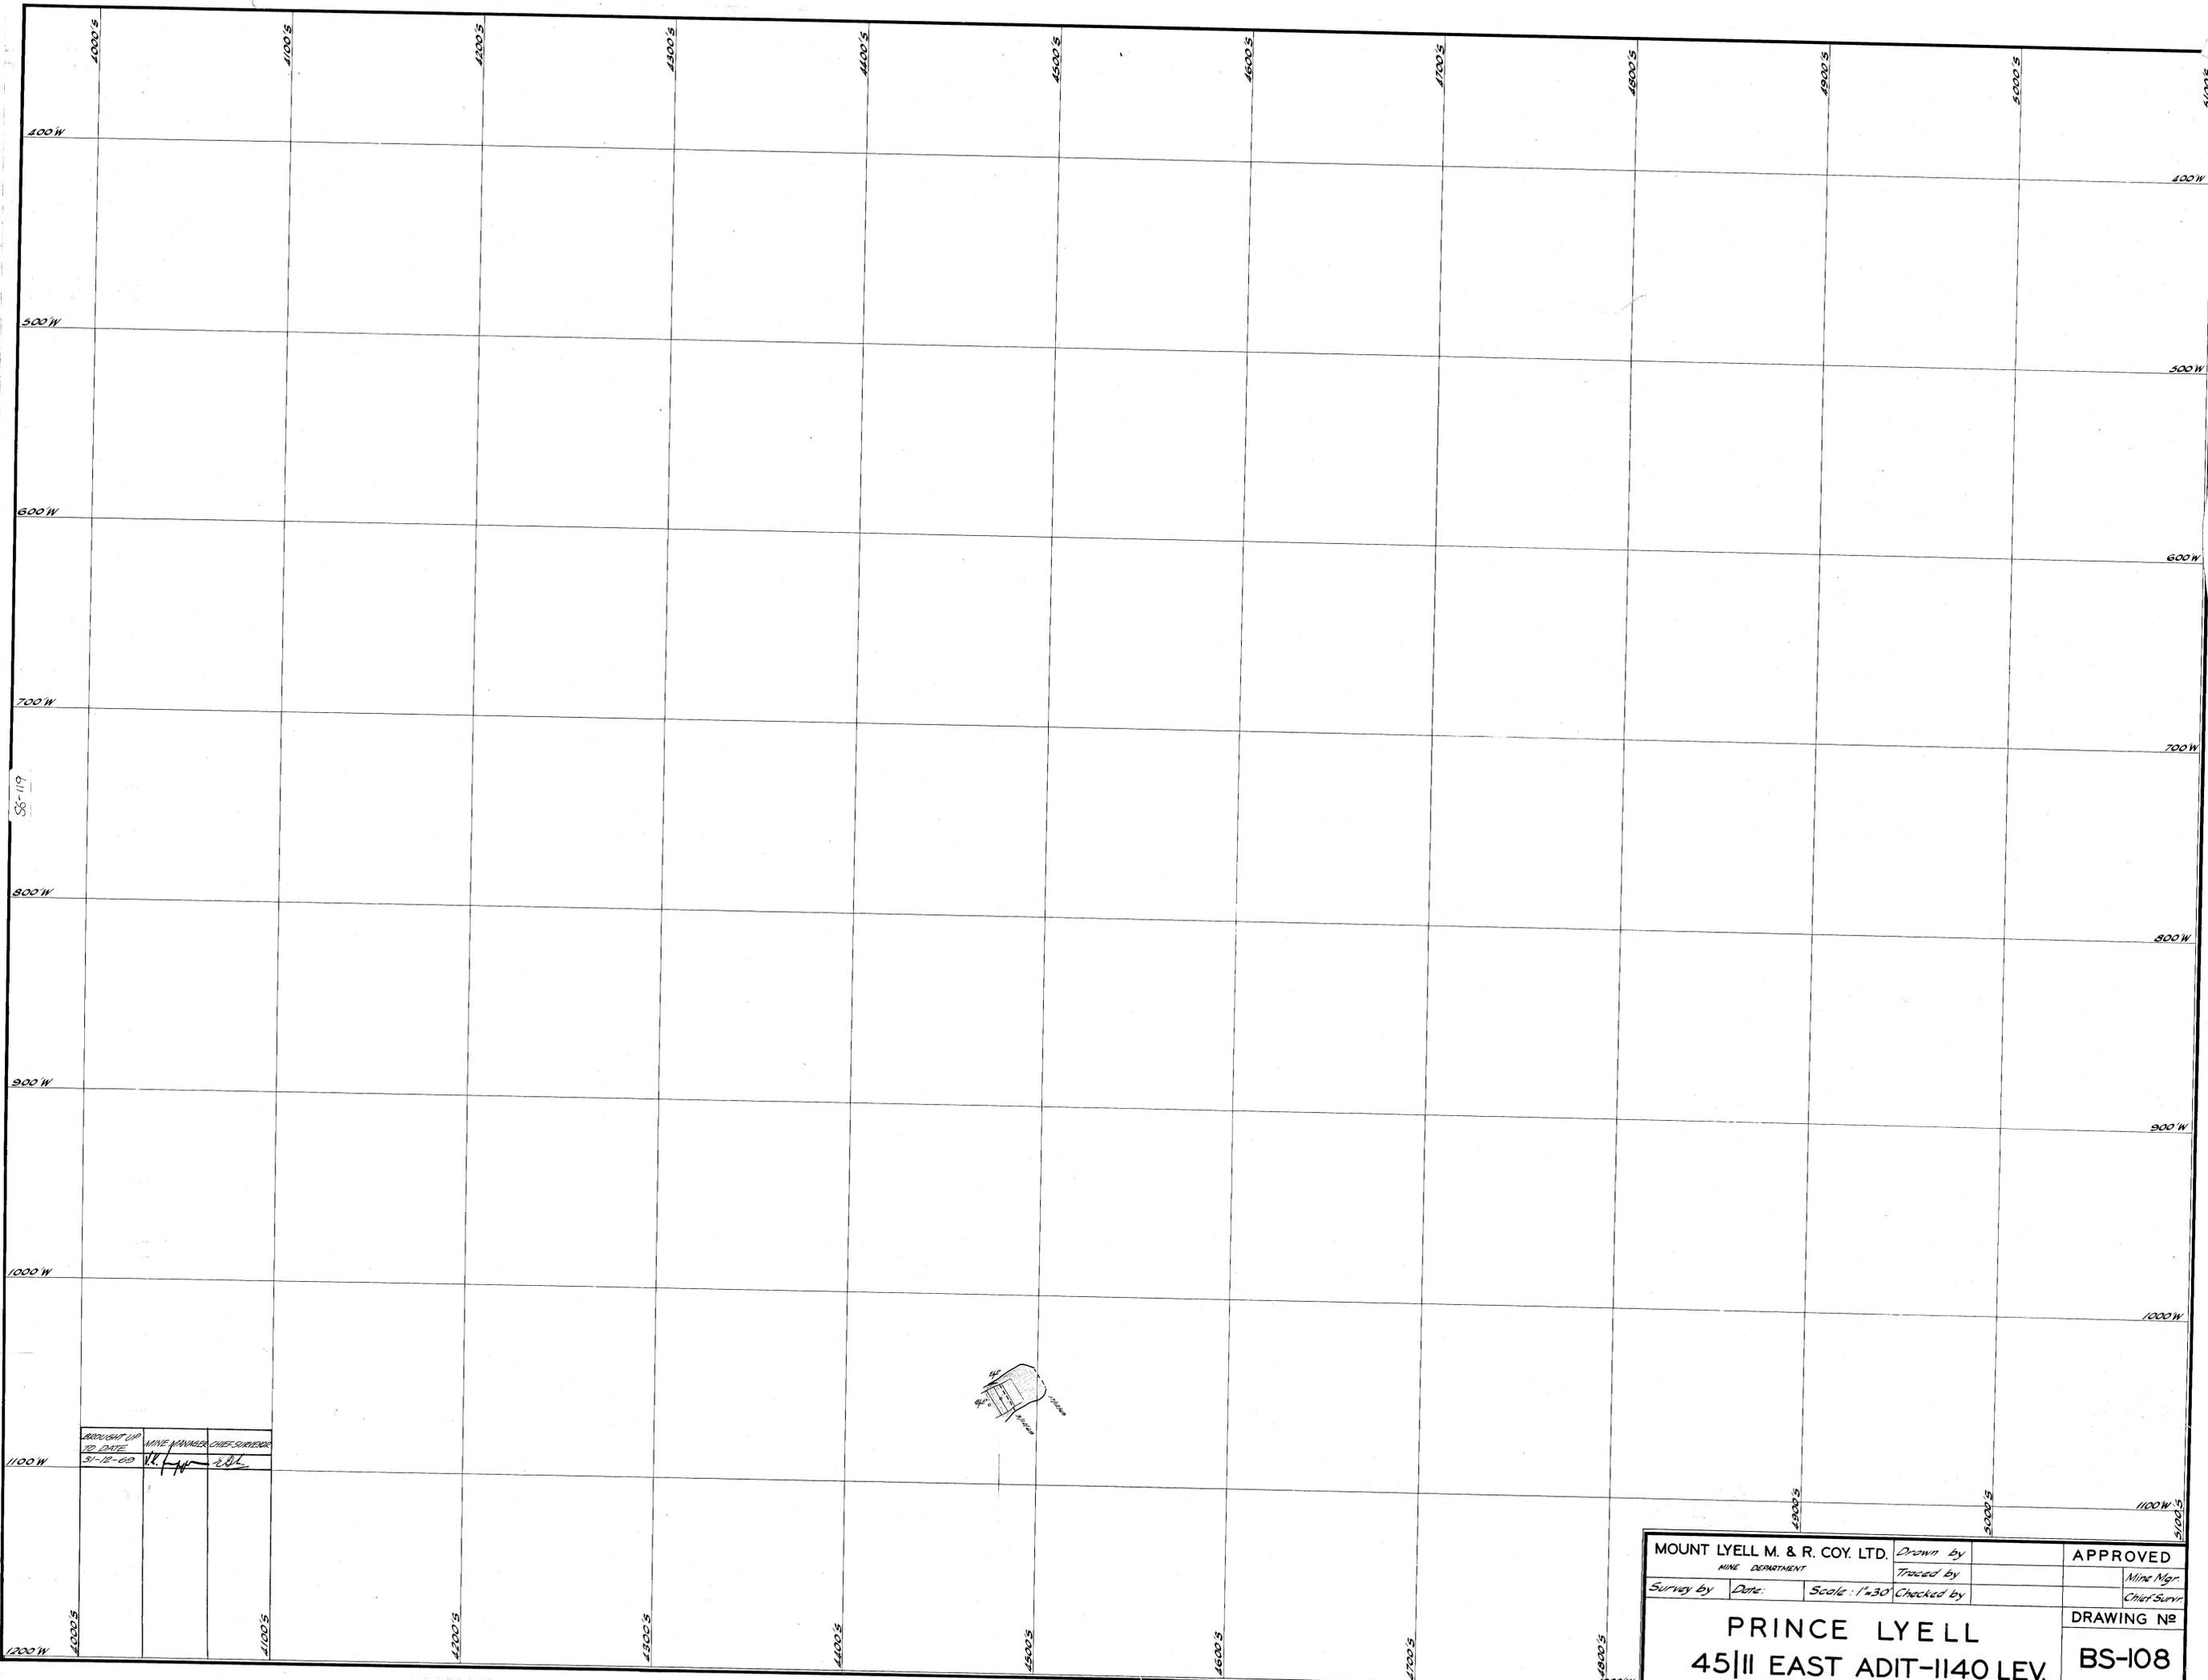

BROUGHT UP TO DATE	MINER MANAGER	CHIEF SURVEYOR
51-12-20	<i>[Signature]</i>	<i>[Signature]</i>

MOUNT LYELL M. & R. COY. LTD.			Drawn by		APPROVED
MINE DEPARTMENT			Traced by		Mine Mgr
Survey by	Date:	Scale: 1"=30'	Checked by		Chief Survr
PRINCE LYELL					DRAWING No
45 EAST ADIT-1140 LEV.					BS-108
Induced					#

5 cm