


56-121

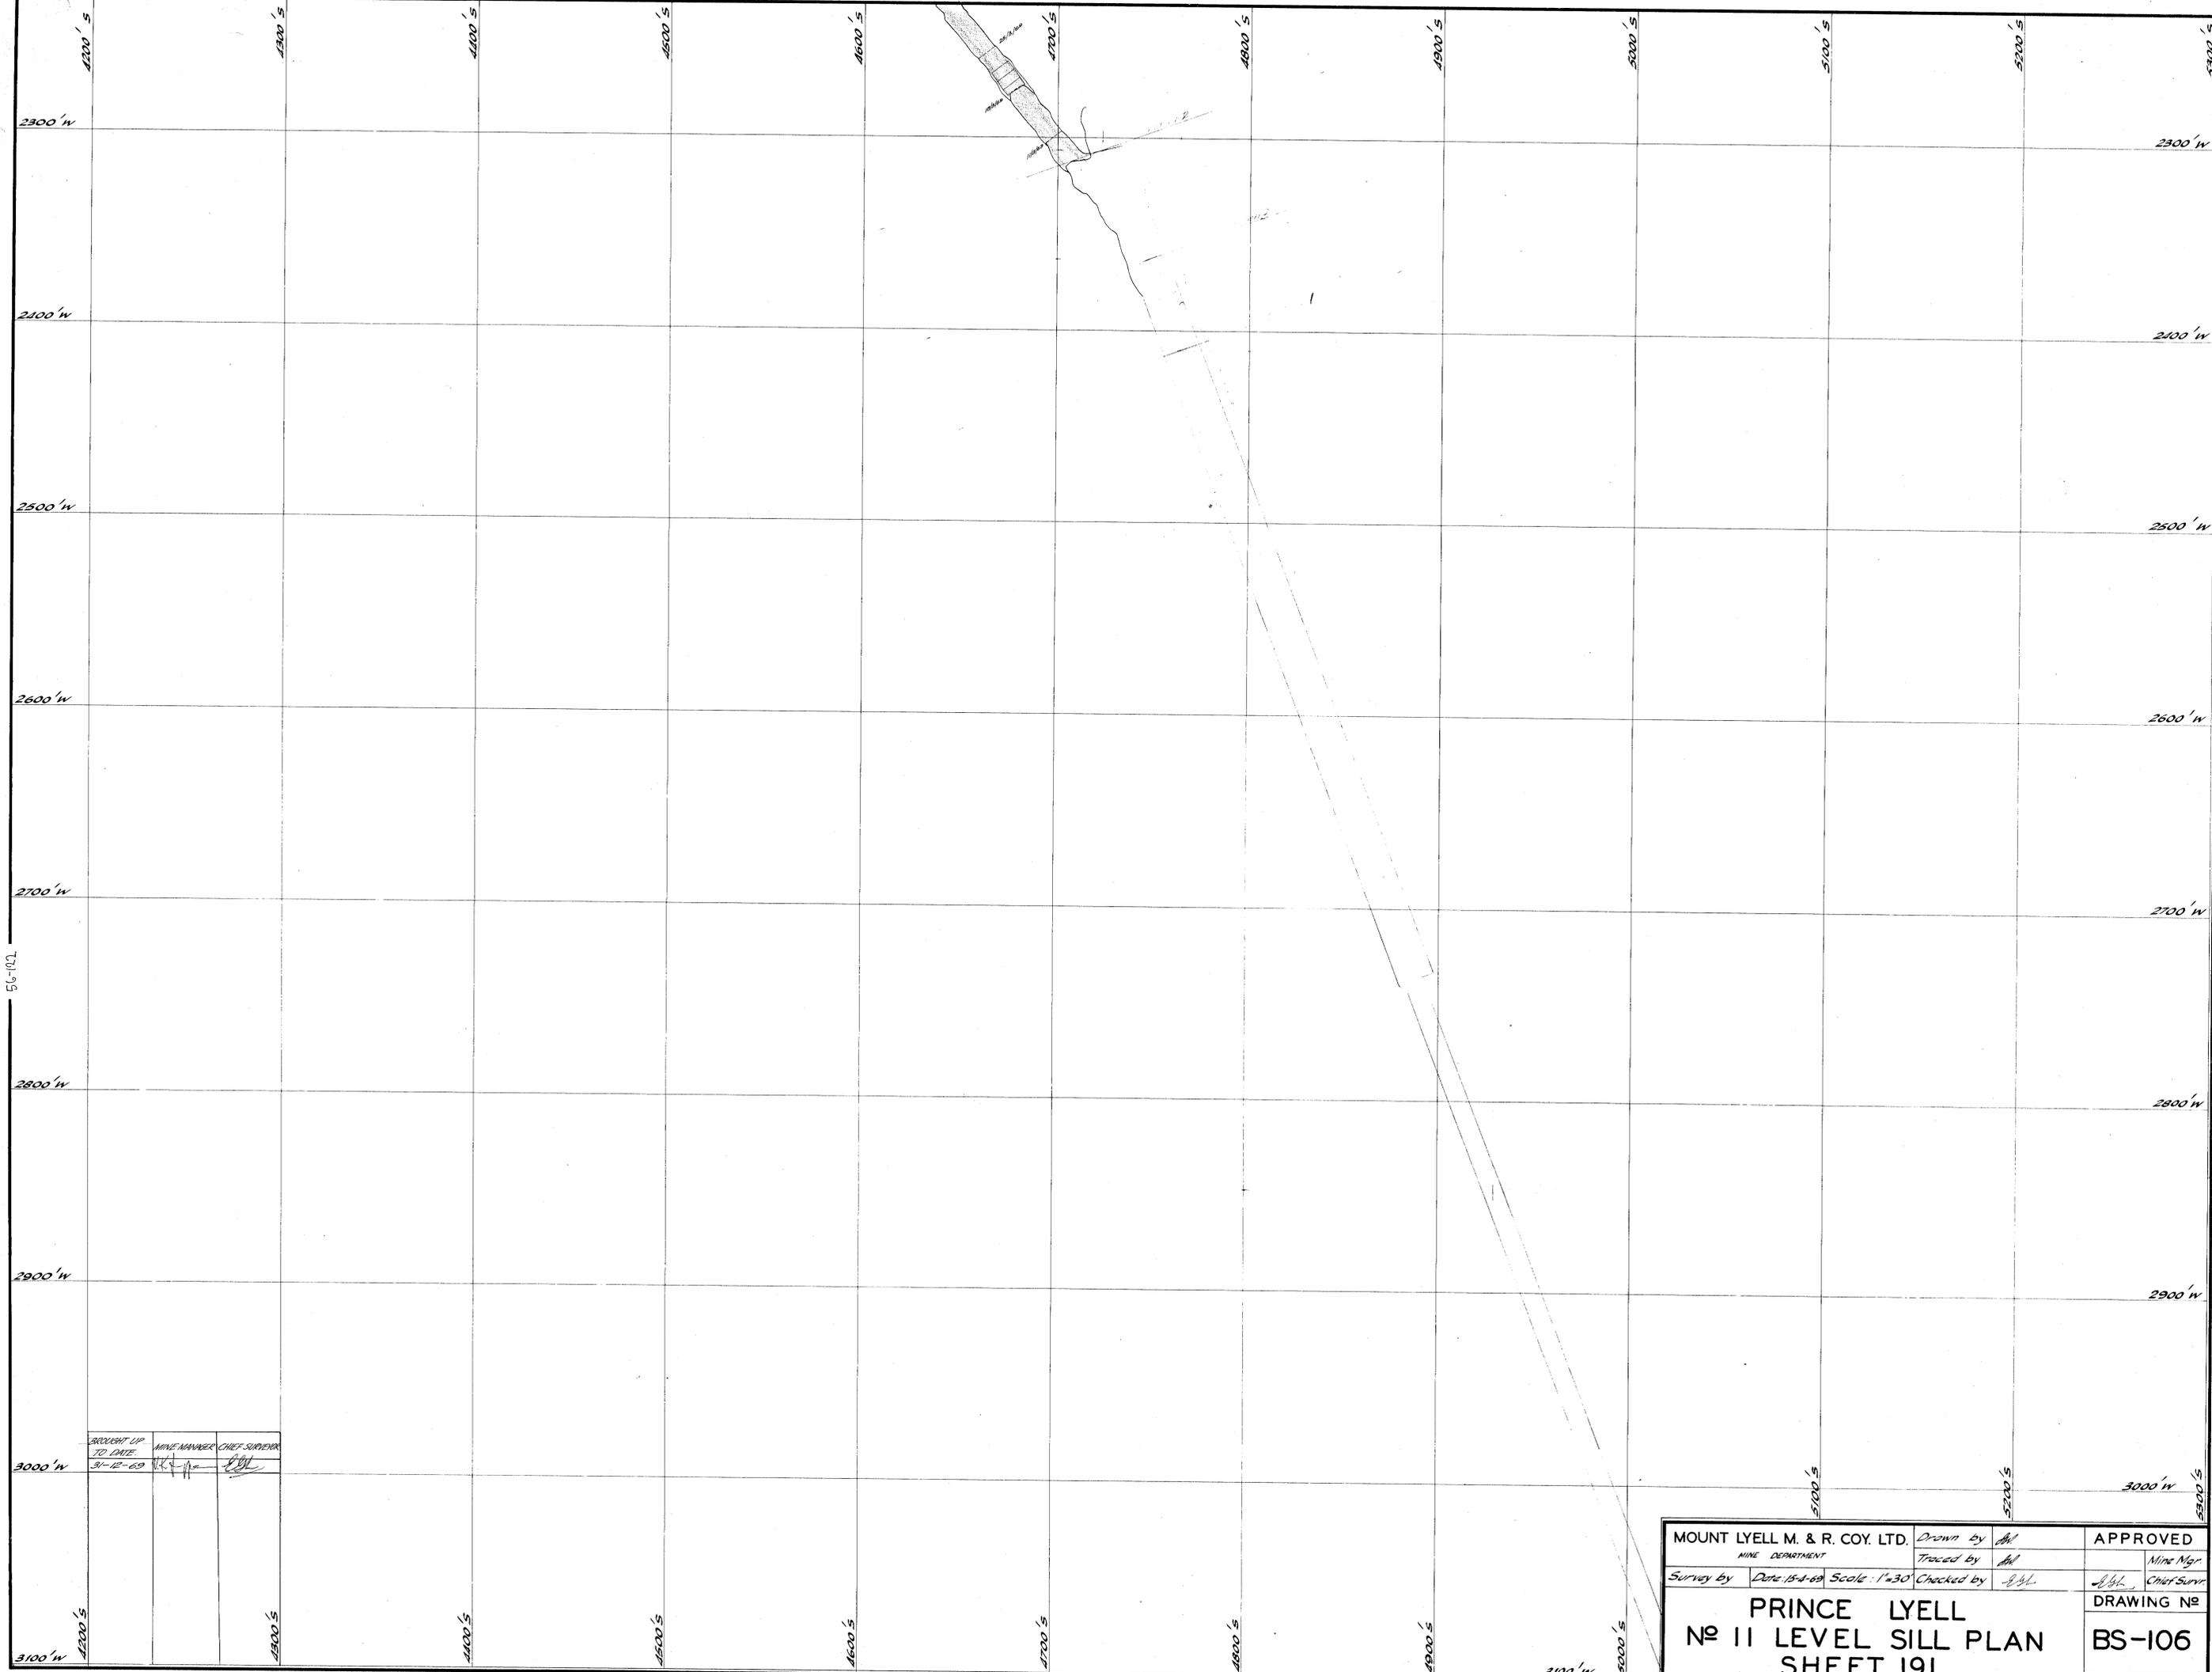

BROUGHT UP TO DATE	MINER MANAGER	CHIEF SURVEYOR
3-12-69	<i>[Signature]</i>	<i>[Signature]</i>

MOUNT LYELL M. & R. COY. LTD.		Drawn by <i>[Signature]</i>	APPROVED
MINE DEPARTMENT		Traced by <i>[Signature]</i>	Mine Mgr.
Survey by	Date: 12-4-69	Scale: 1"=30'	Checked by <i>[Signature]</i>
PRINCE LYELL			DRAWING No
No 11 LEVEL SILL PLAN			BS-106
SHEET 191			Indexed J.L.J.