


55-28

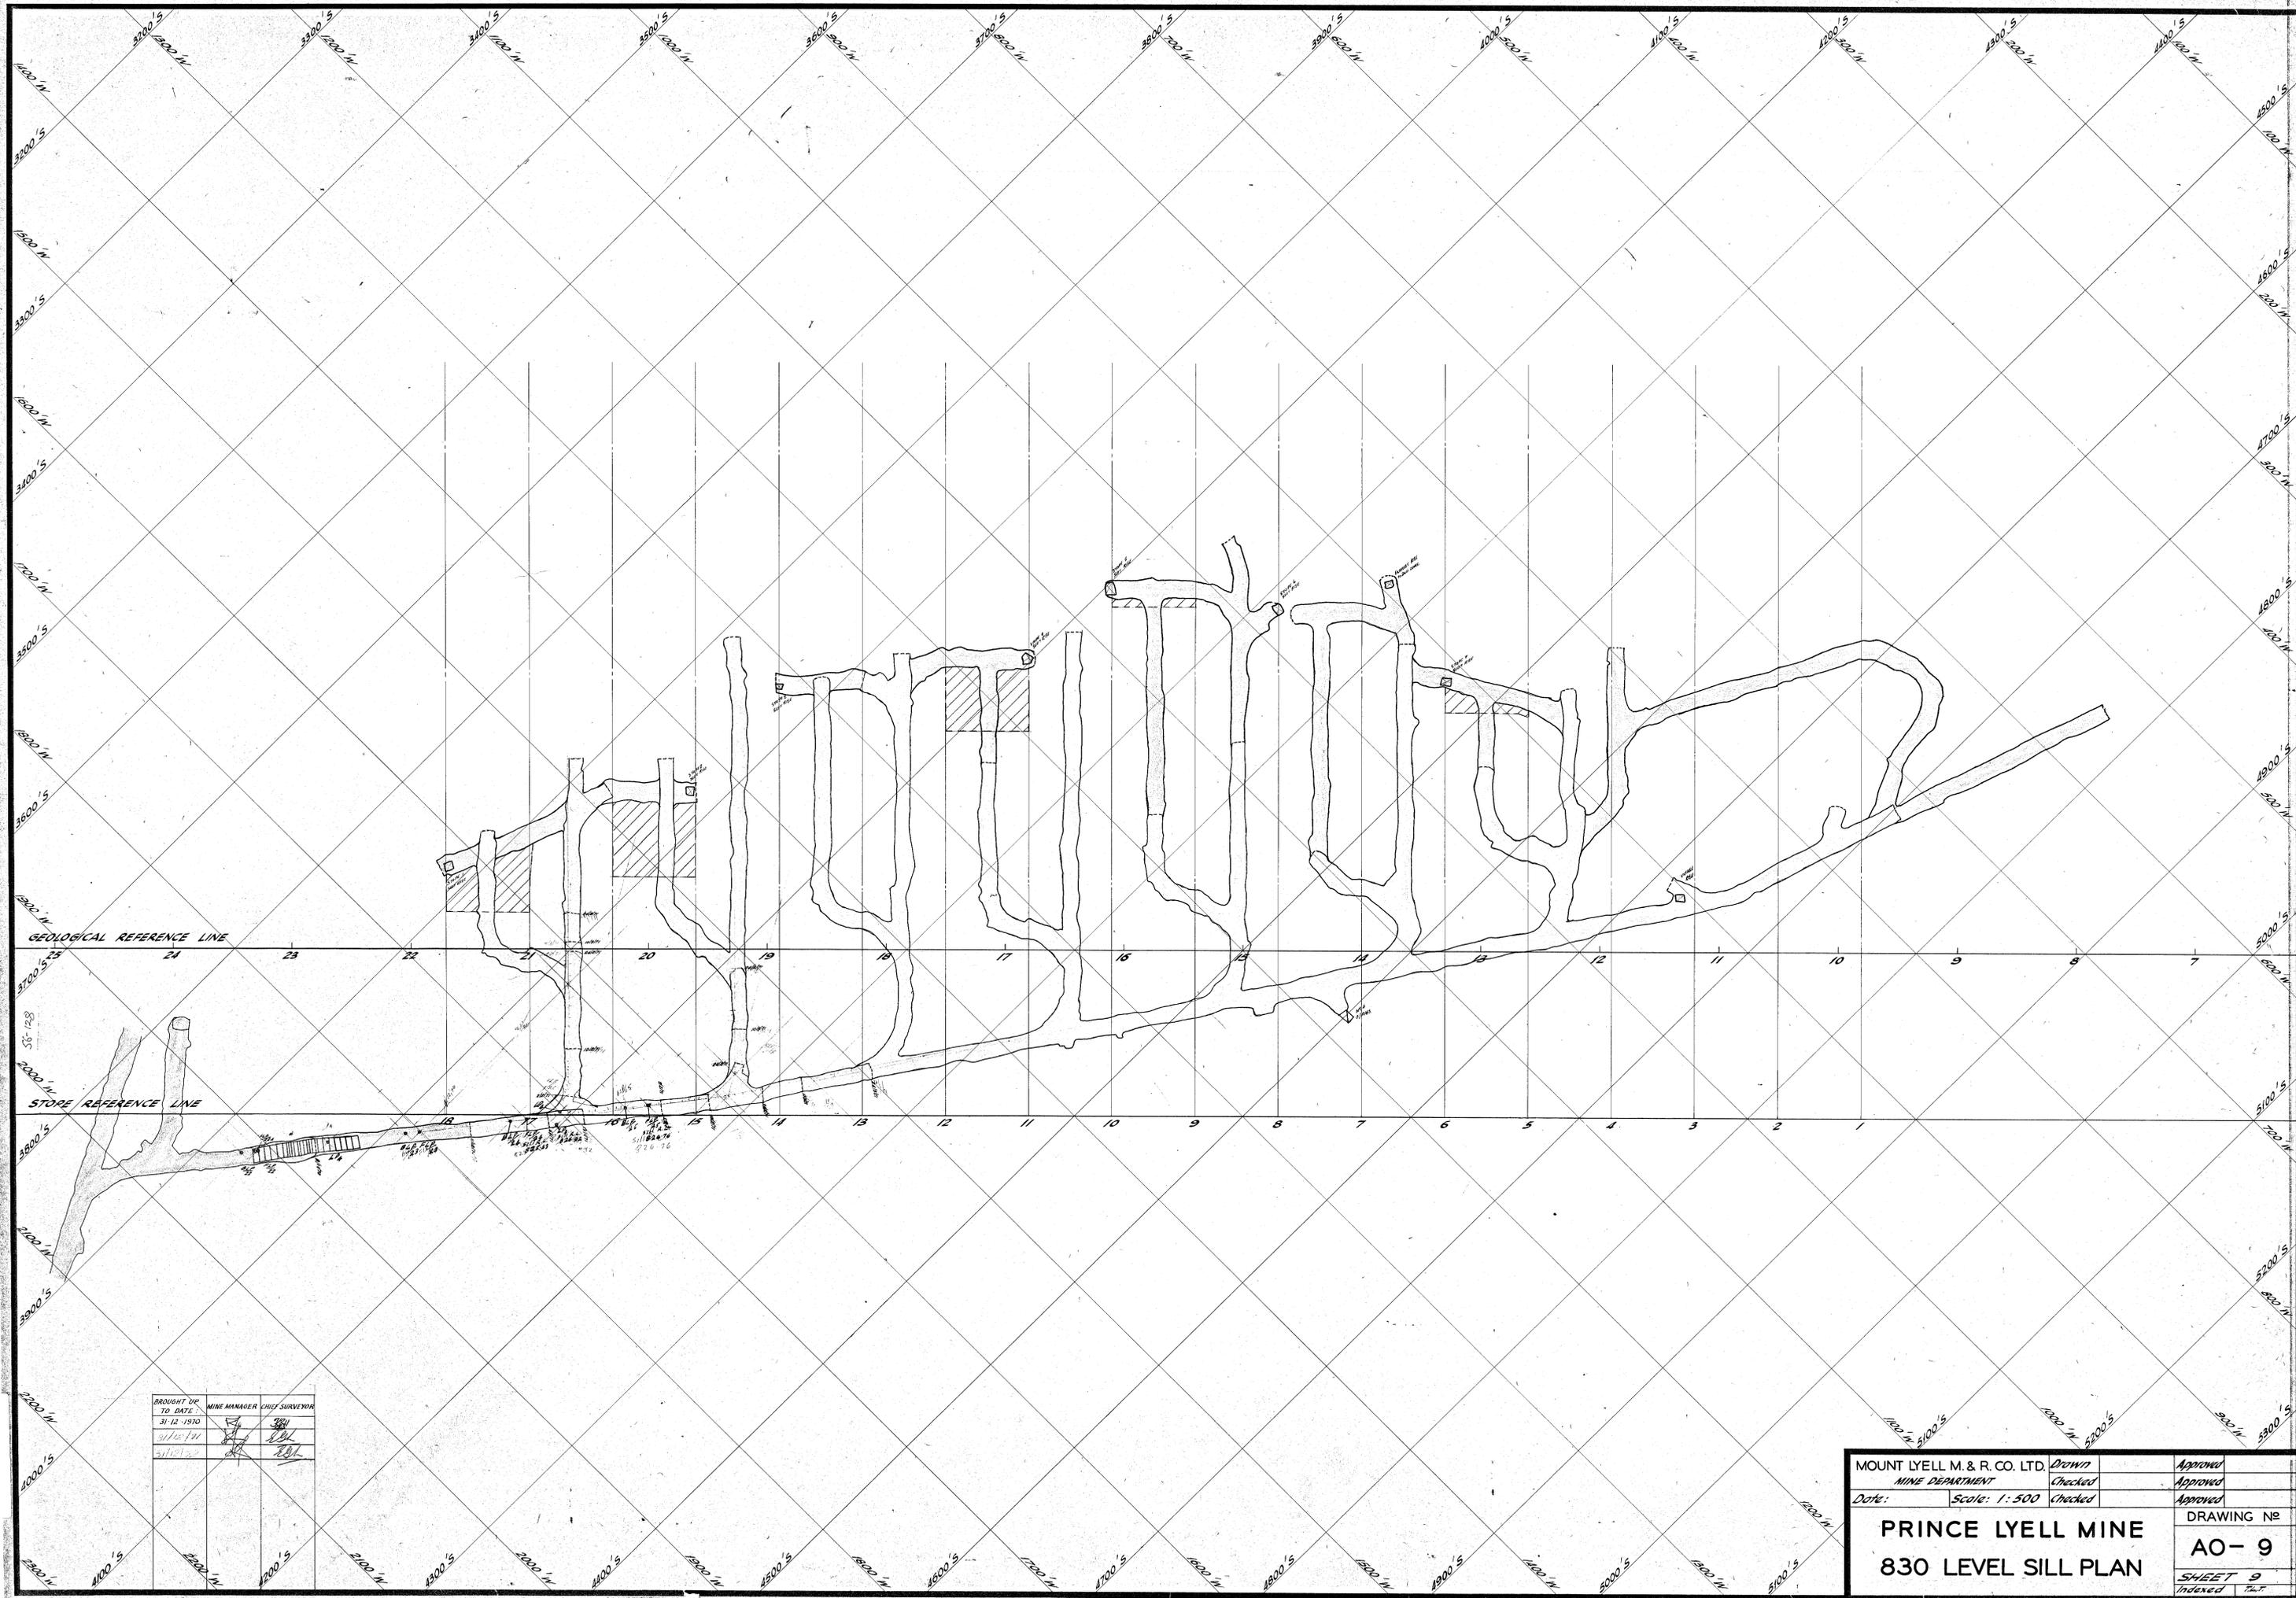

BROUGHT UP TO DATE	MINE MANAGER	CHIEF SURVEYOR
31-12-1970	[Signature]	[Signature]
31/12/71	[Signature]	[Signature]
31/12/72	[Signature]	[Signature]

MOUNT LYELL M. & R. CO. LTD.	Drawn	Approved
MINE DEPARTMENT	Checked	Approved
Date:	Scale: 1:500	Checked
PRINCE LYELL MINE 830 LEVEL SILL PLAN		DRAWING NO AO-9 SHEET 9 INDEXED