


5 cm

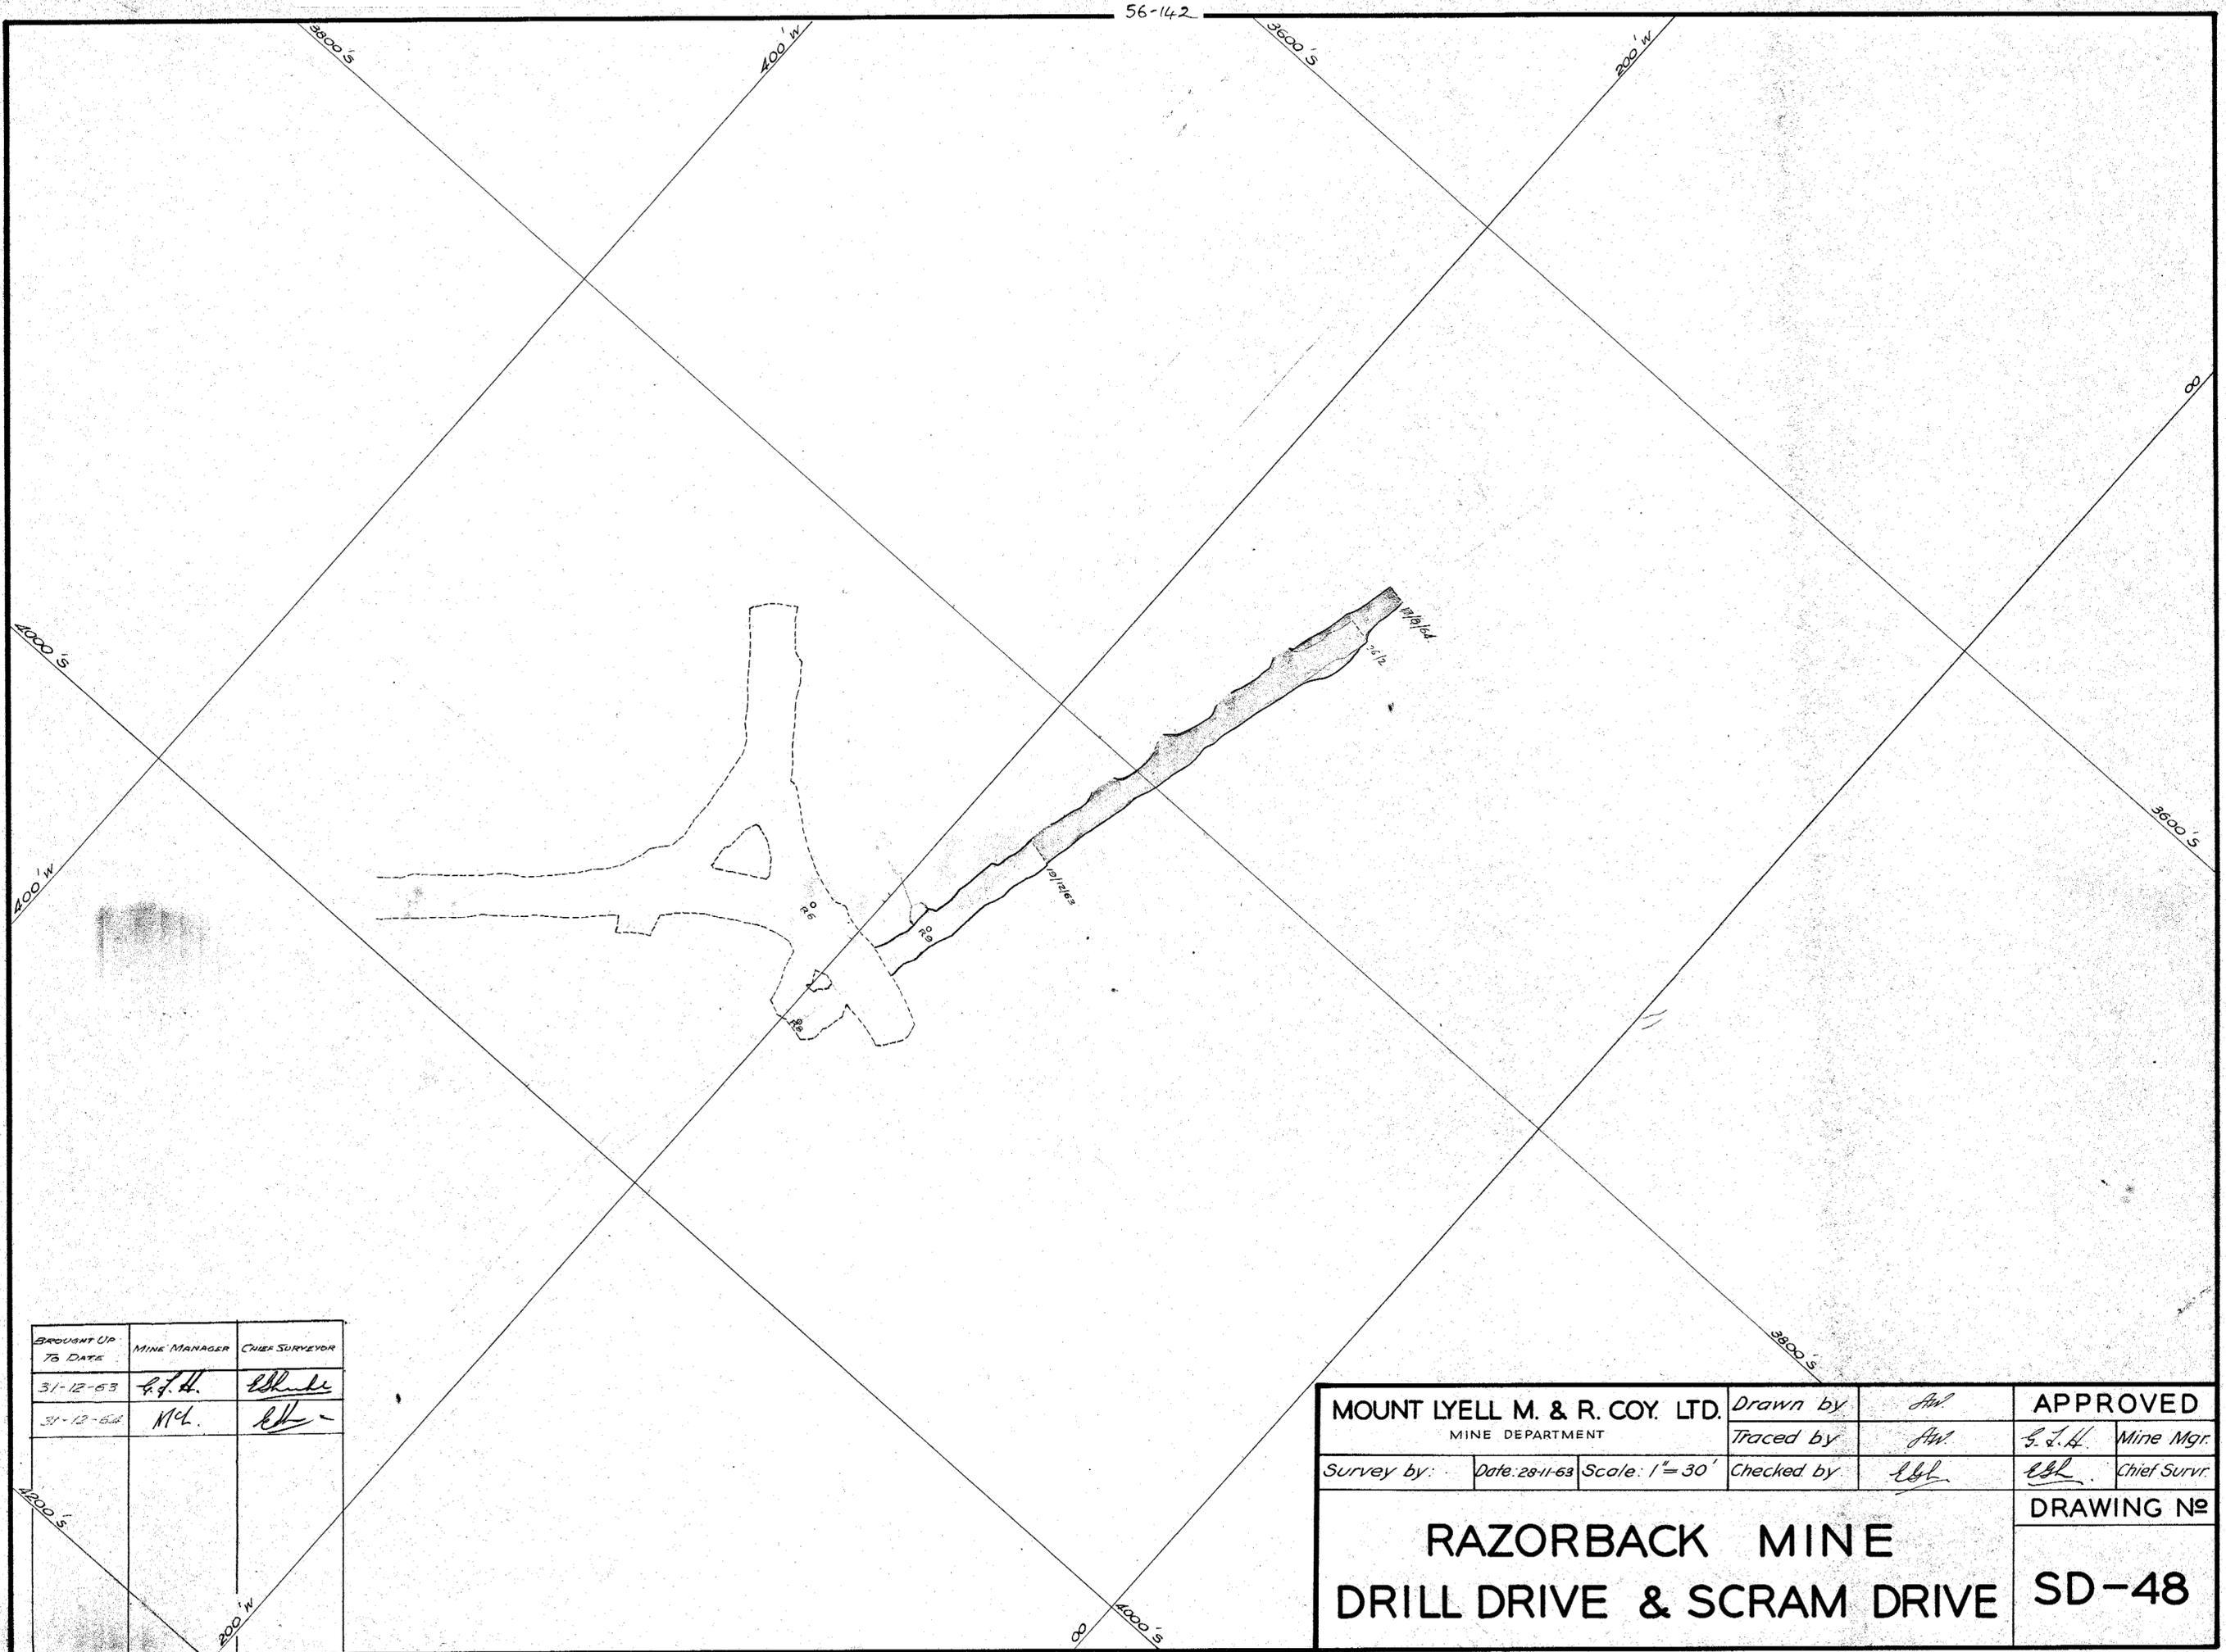

BROUGHT UP TO DATE	MINE MANAGER	CHIEF SURVEYOR
31-12-53	<i>G. F. H.</i>	<i>Edwards</i>
31-12-52	<i>M.C.</i>	<i>Edwards</i>

MOUNT LYELL M. & R. COY. LTD. MINE DEPARTMENT		Drawn by <i>AW</i>	APPROVED	
Survey by: <i>Date: 28-11-53</i> Scale: 1"=30'		Traced by <i>AW</i>	<i>S. J. H.</i>	Mine Mgr.
		Checked by <i>Edwards</i>	<i>Edwards</i>	Chief Survr.
RAZORBACK MINE DRILL DRIVE & SCRAM DRIVE				DRAWING No SD-48