


5 cm

S6-143

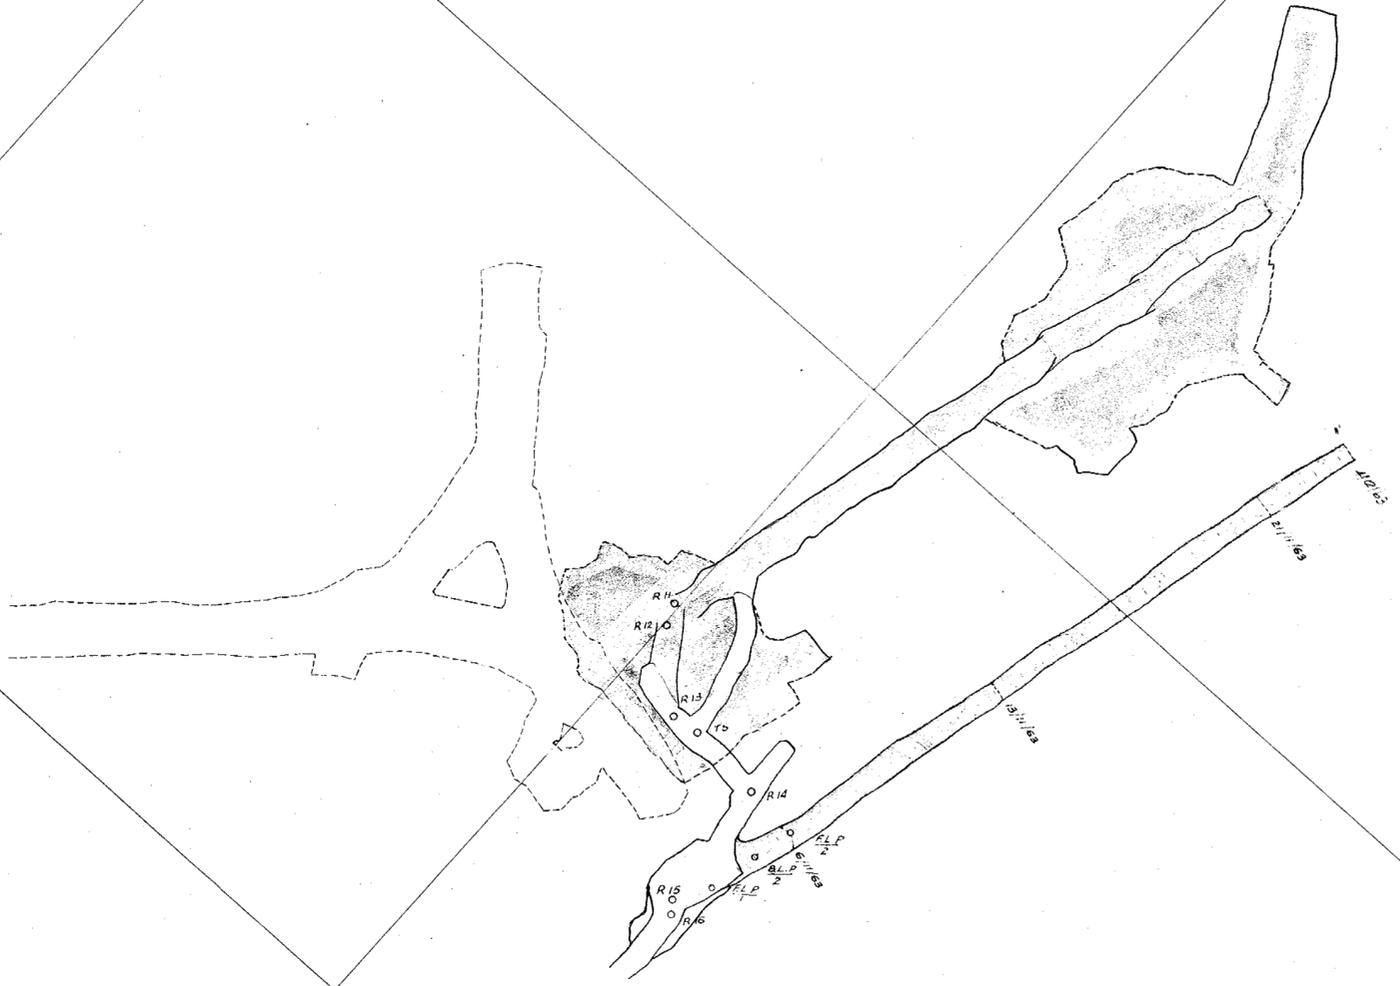

BROUGHT UP TO DATE	MINE MANAGER	CHIEF SUPERVISOR
31-12-63	<i>E.J.H.</i>	<i>E.H.L.</i>
31-12-64	<i>M.L.</i>	<i>E.H.L.</i>

MOUNT LYELL M. & R. COY. LTD. MINE DEPARTMENT		Drawn by <i>J.H.</i>	APPROVED	
		Traced by <i>A.W.</i>	<i>E.J.H.</i>	Mine Mgr.
Survey by <i>E.H.L.</i>	Date: 28-11-63	Scale: 1"=30'	Checked by <i>E.H.L.</i>	Chief Survr.
RAZORBACK MINE				DRAWING No
BENCH DRIVE & VENTN. DRIVE				SD-47