


56-144

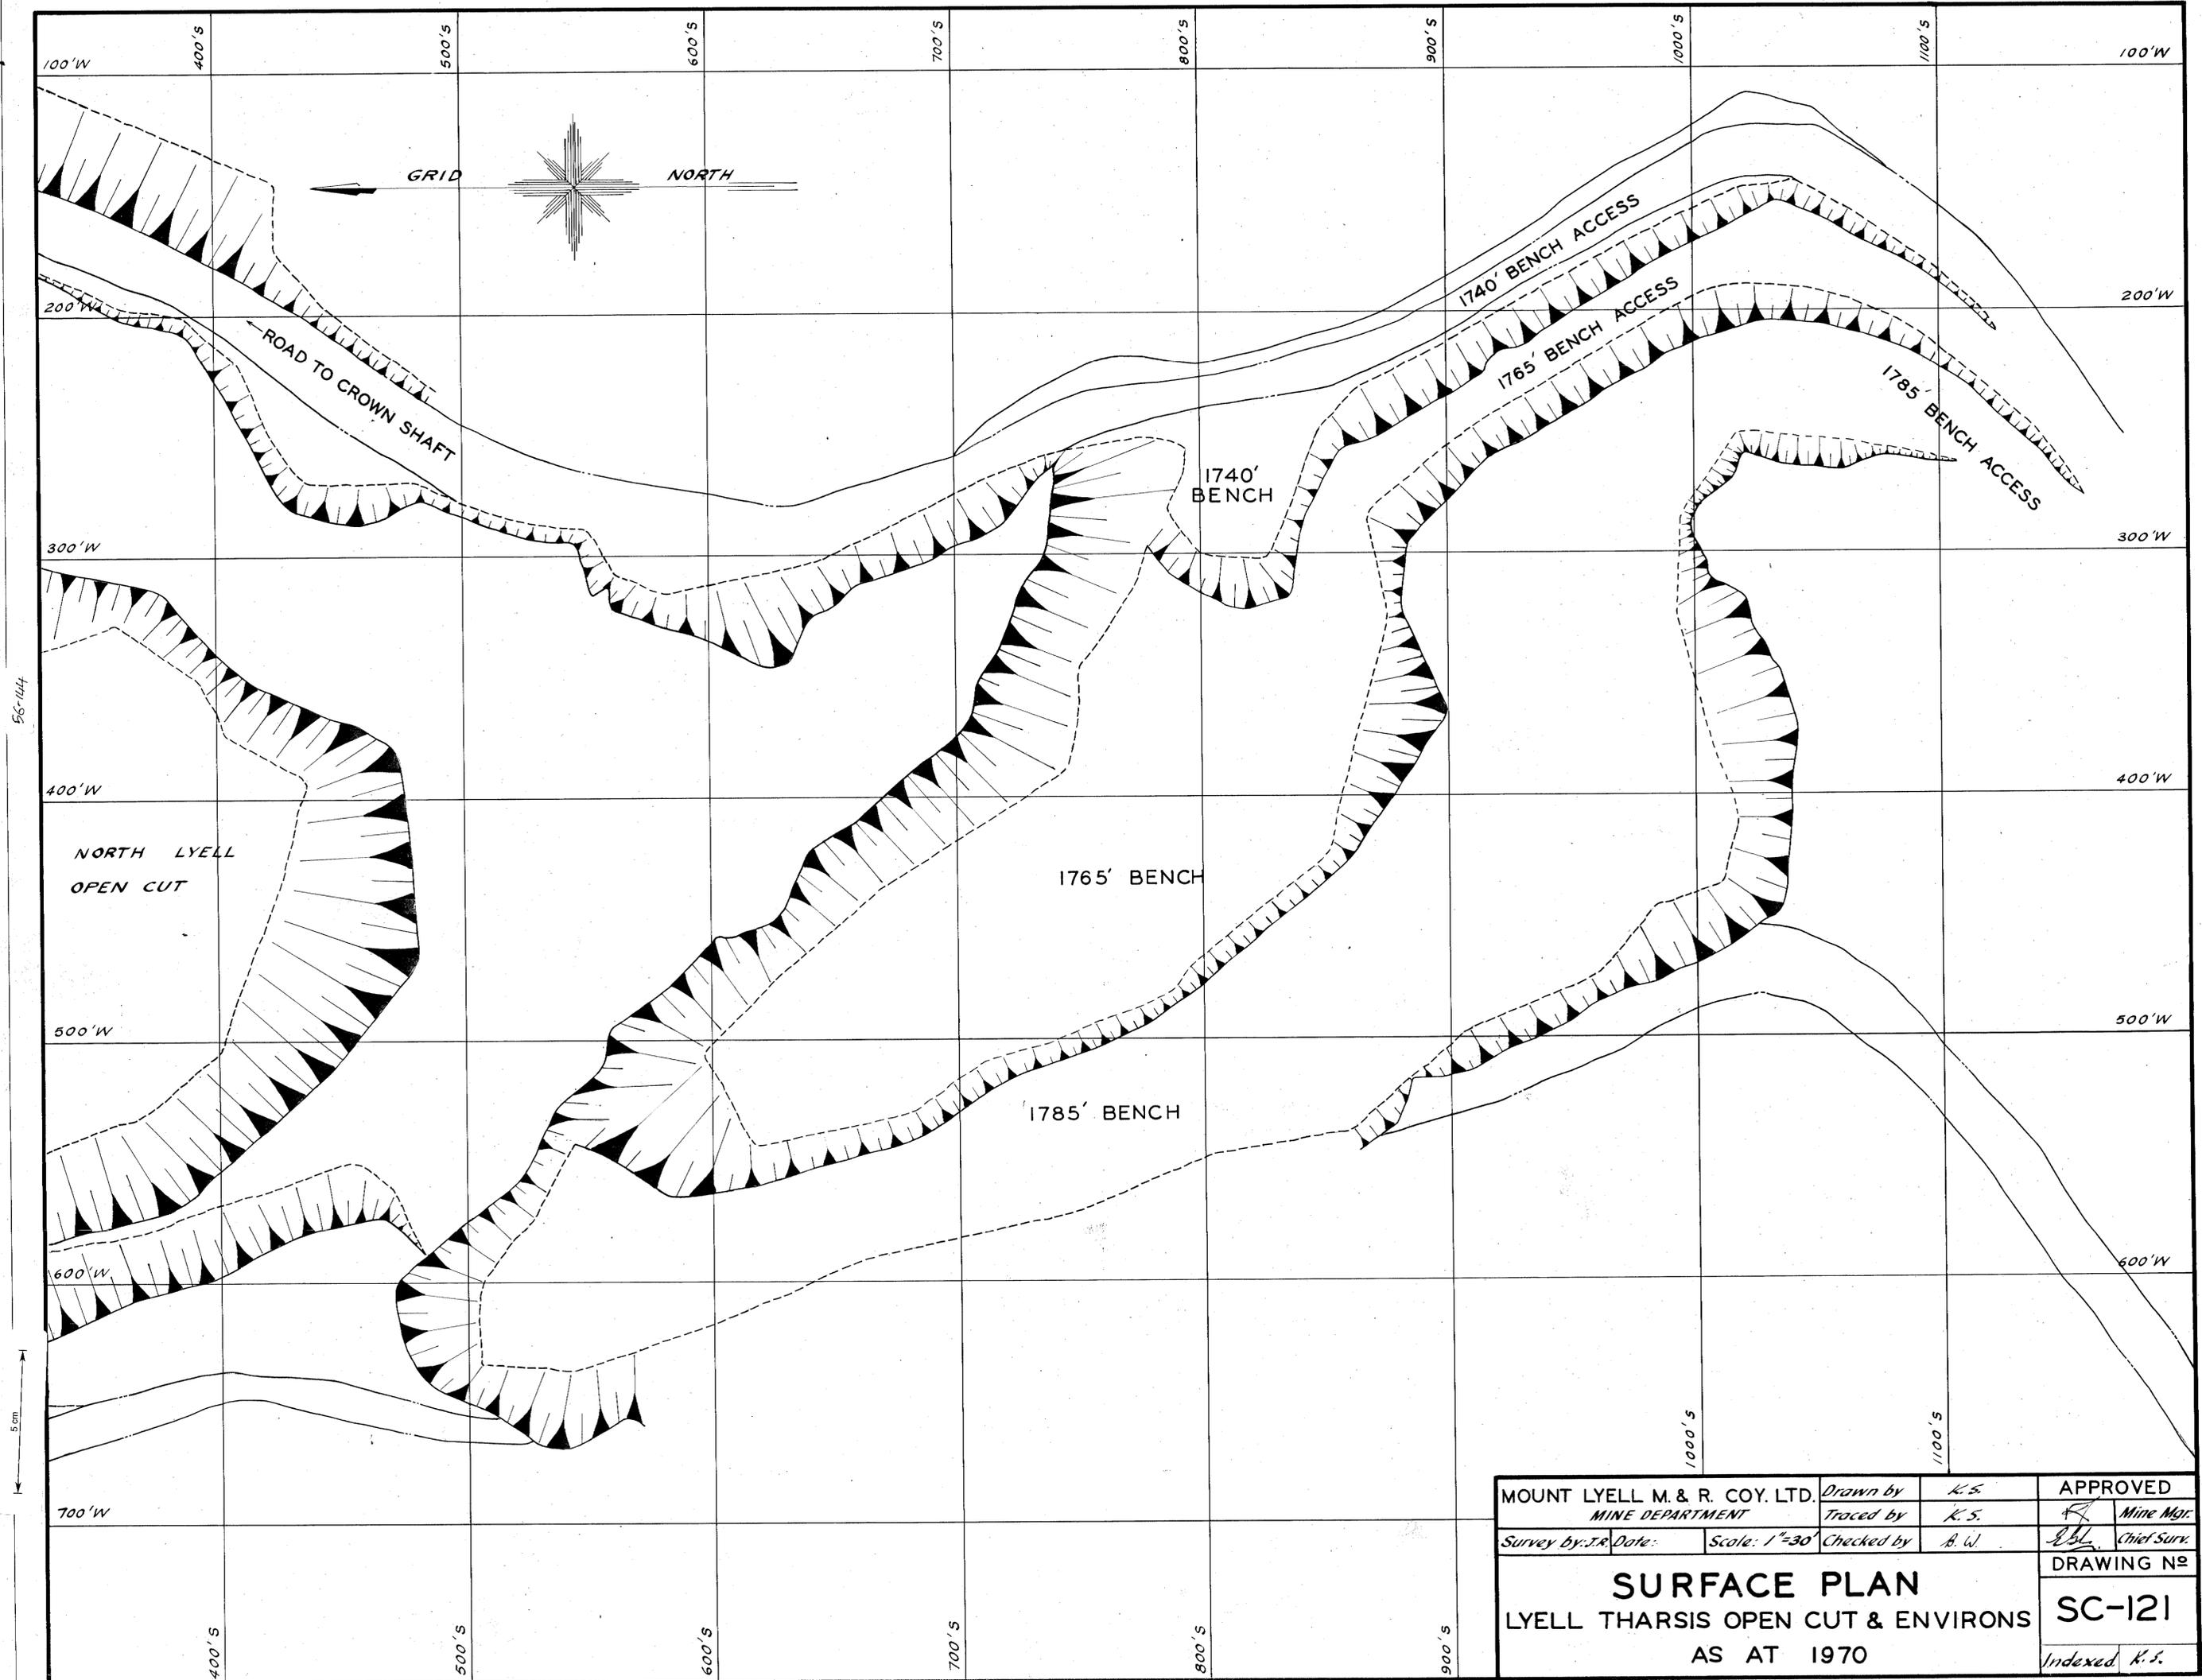

MOUNT LYELL M. & R. COY. LTD.		Drawn by	K.S.	APPROVED	
MINE DEPARTMENT		Traced by	K.S.	<i>[Signature]</i>	Mine Mgr.
Survey by: J.R.	Date:	Scale: 1"=30'	Checked by	A.W.	<i>[Signature]</i> Chief Surv.
<b>SURFACE PLAN</b> LYELL THARSIS OPEN CUT & ENVIRONS AS AT 1970				DRAWING N <sup>o</sup>	
				SC-121	
				Indexed K.S.	