

36-149


5 cm

1000 W.

900 W.

800 W.

700 W.

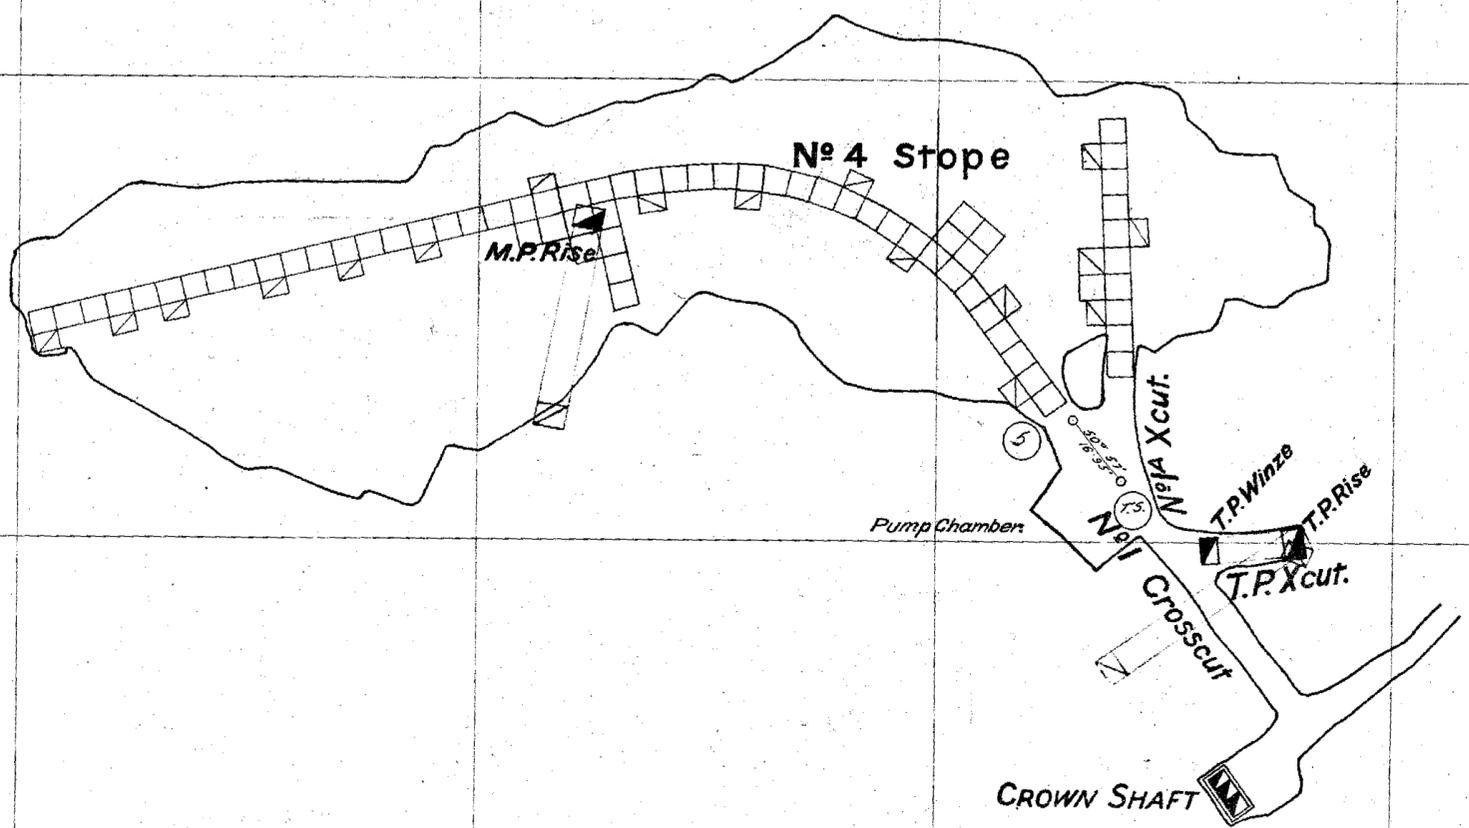

THE MOUNT LYELL M. & R. CO. LTD.

DETAIL PLAN

UNDERGROUND WORKINGS

400 FT. LEVEL

CROWN LYELL MINE

SCALE - 30 FEET TO THE INCH

W. W. ... GENERAL MANAGER.

G. ... MINE SUPERINTENDENT.

*Exc'd
2/6/38*

