


5 cm

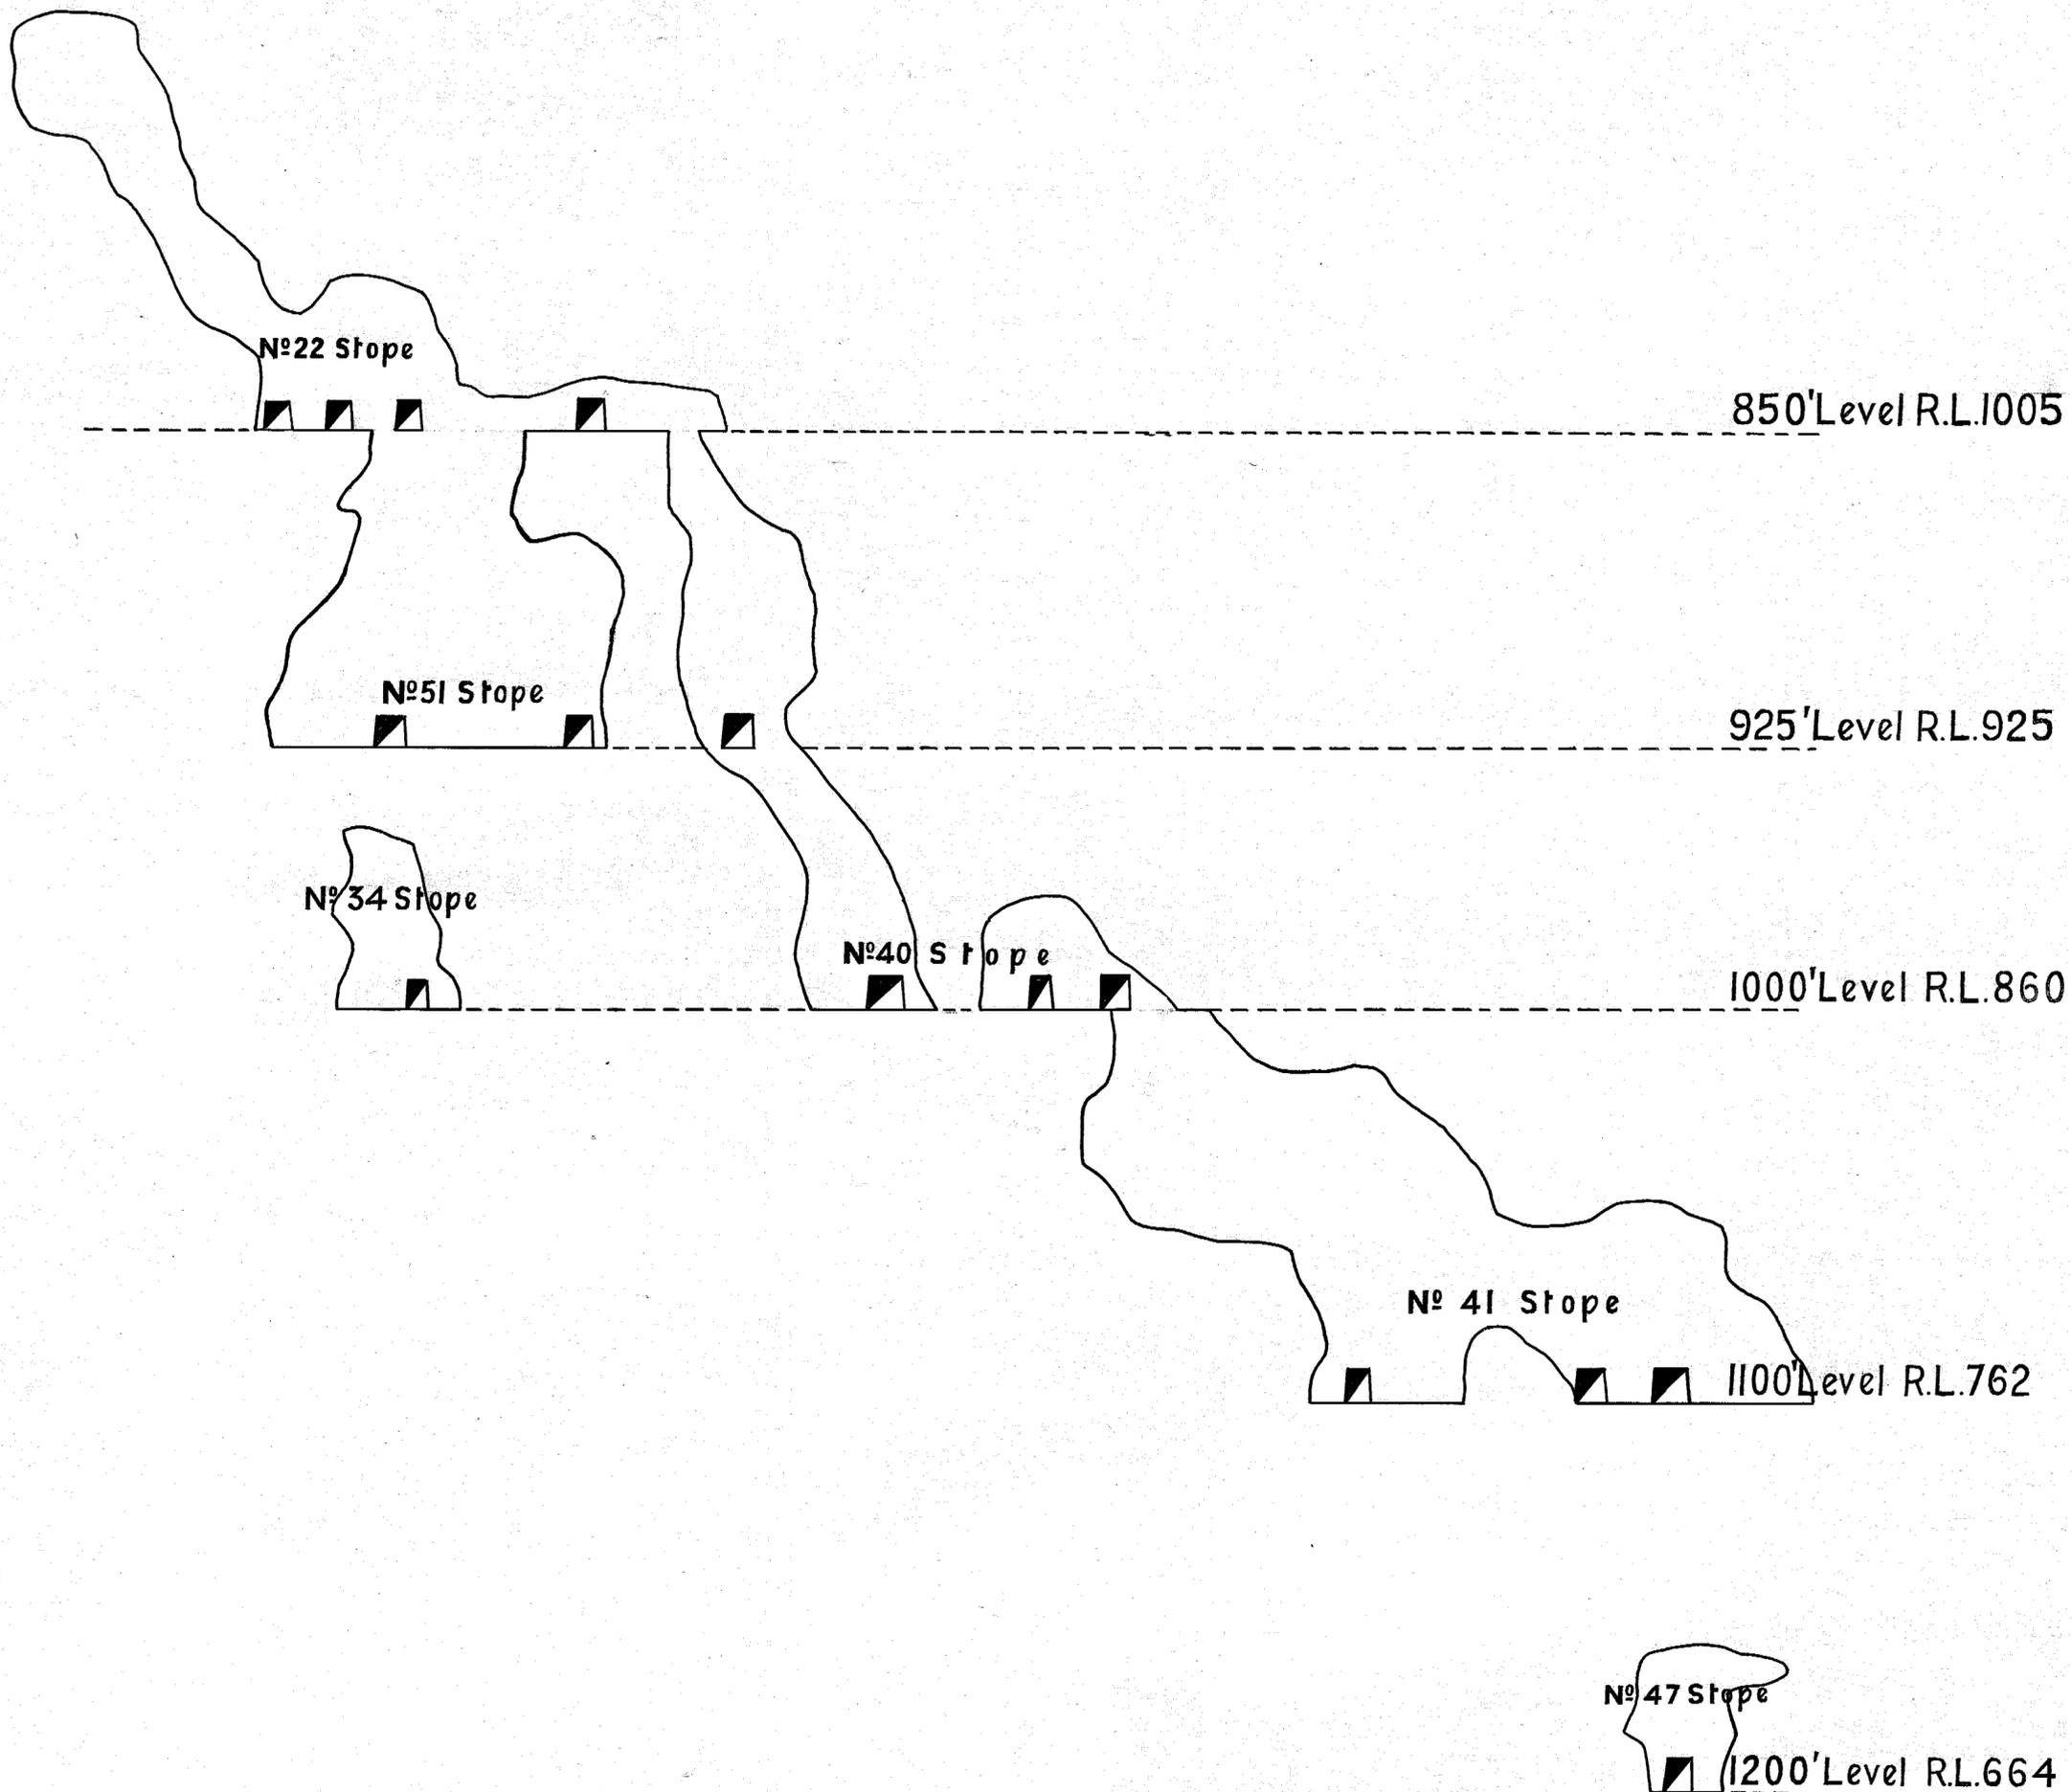

# The Mount Lyell Mining & Railway Co., Ltd.

Mine Department.

## NORTH LYELL MINE

Section on Line DD looking North

Brought up to Dec. 31<sup>st</sup> 1929

Scale 1" = 30'

*R. W. Murray* General Manager  
*G. Fred [unclear]* Mine Superintendent