


5 cm

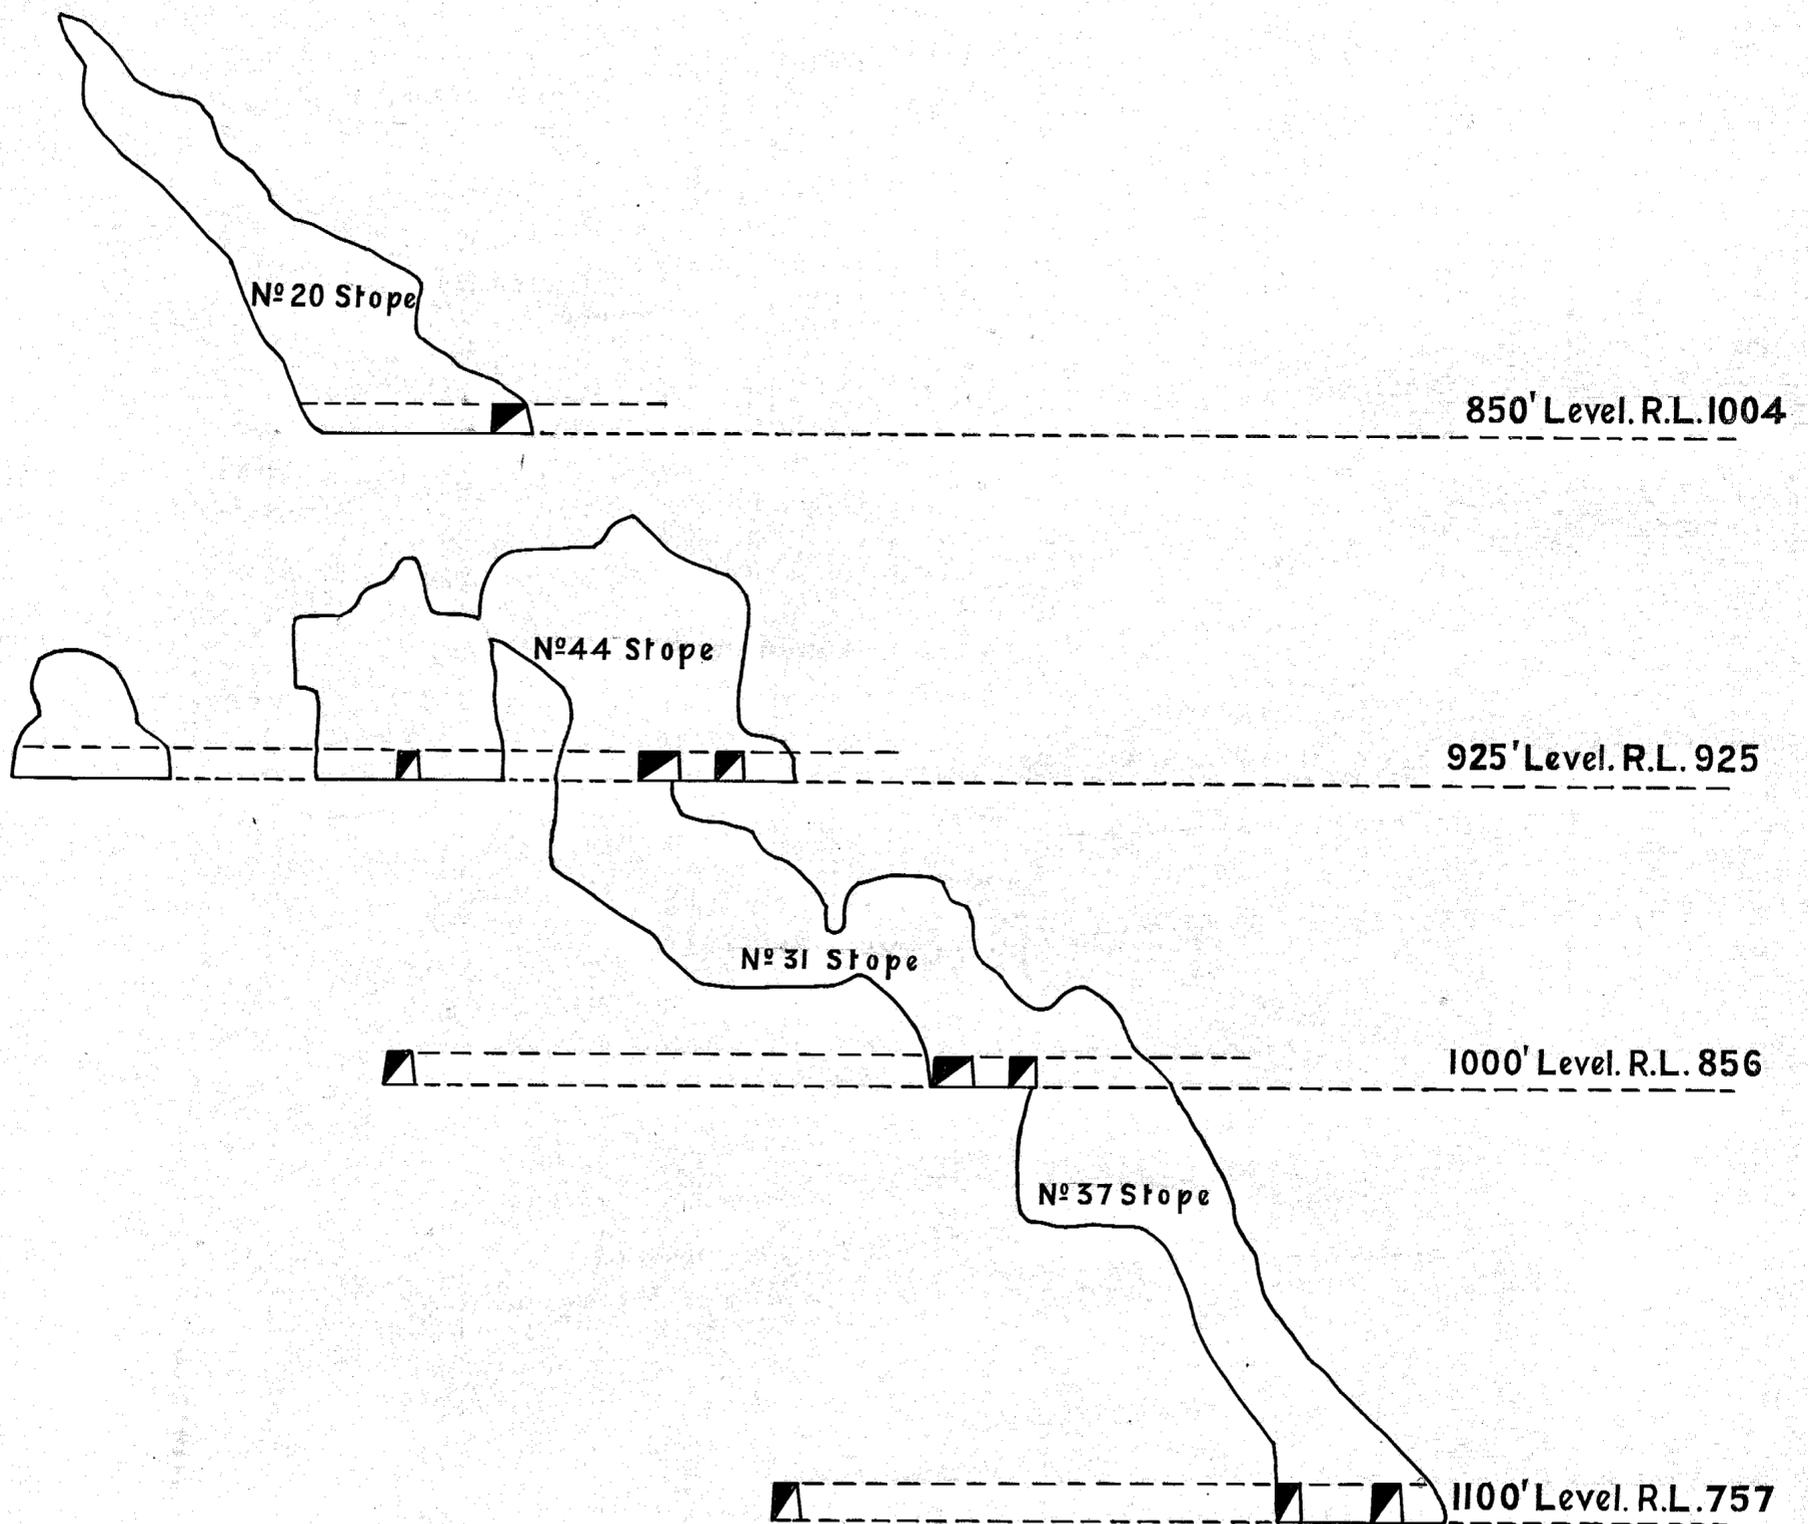

The Mount Lyell Mining & Railway Co., Ltd.

Mine Department.

NORTH LYELL MINE

Section on Line CC looking North

Brought up to Dec. 31st 1929

Scale 1" = 30'

R. J. Murray - General Manager
S. H. Jackson - Mine Superintendent