

5 cm

# The Mount Lyell Mining & Railway Co Ltd


Mine Department.

SHEET N<sup>o</sup> 4

FIELD NOTES OF UNDERGROUND WORKINGS UP TO 31-12-31.

*R. Williams* General Manager  
*J. T. ...* Mine Superintendent

INSTRUMENT USED 5" THEODOLITE.

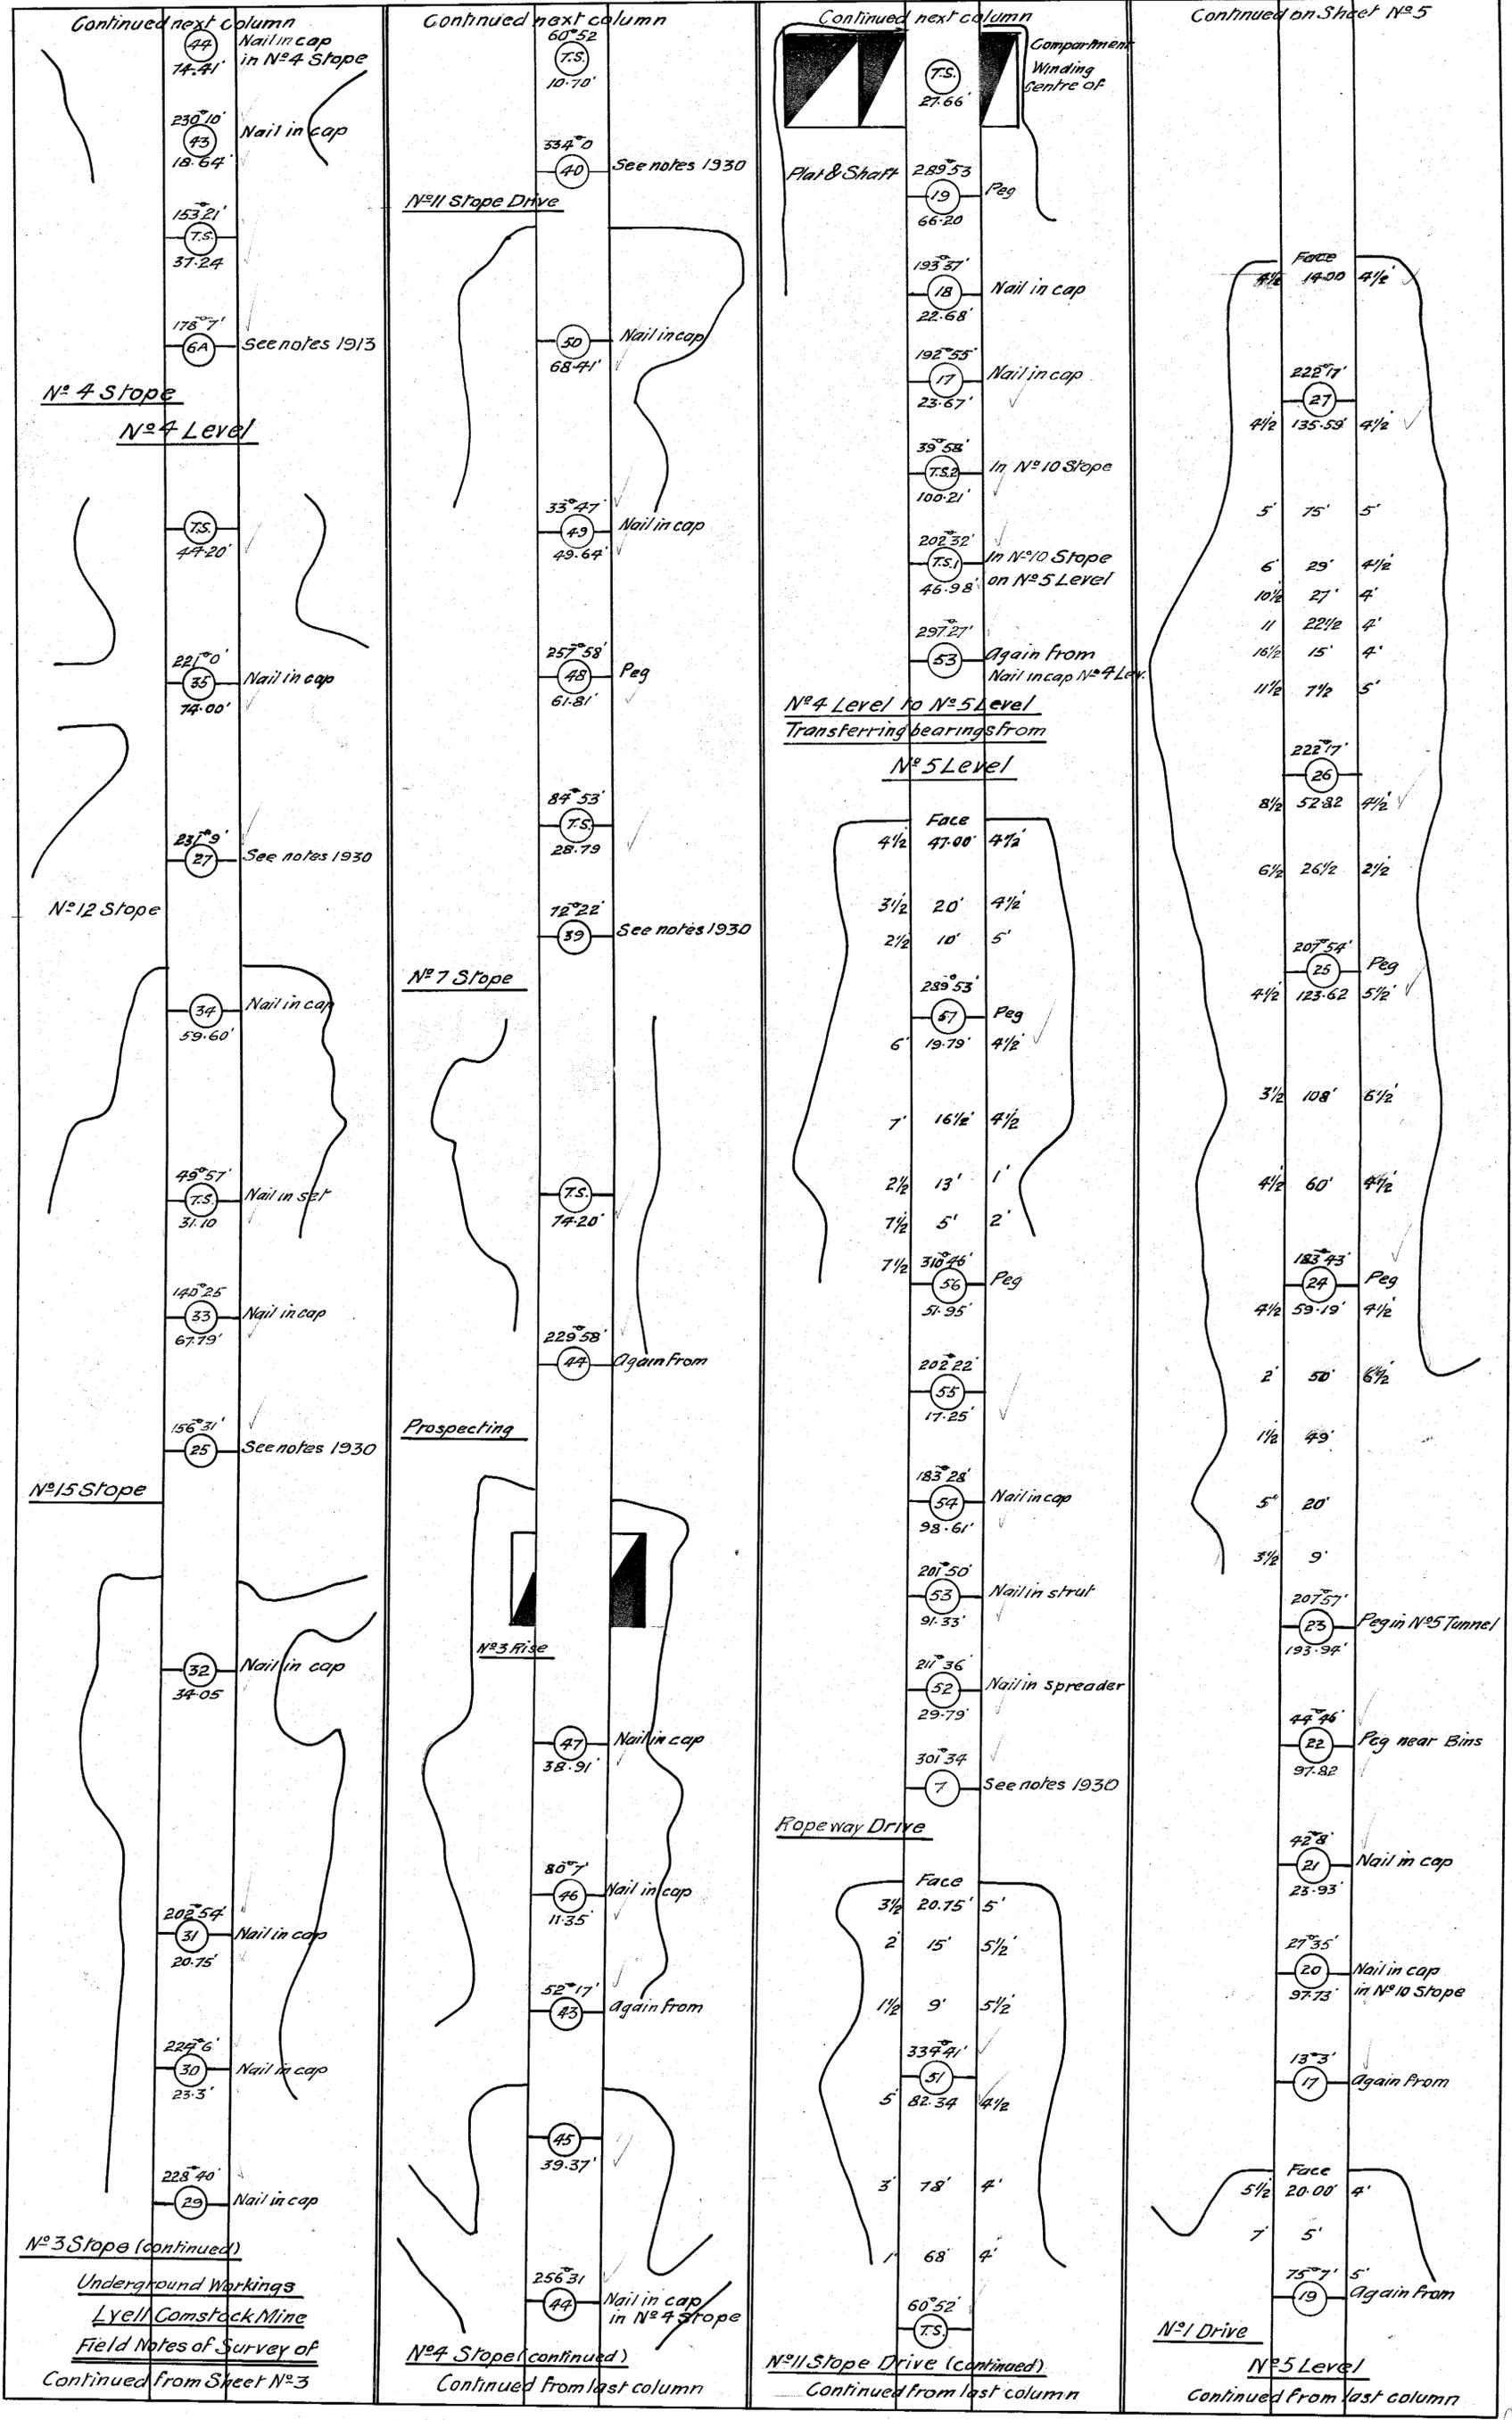

N<sup>o</sup> 3 Slope (continued)  
 Underground Workings  
 Lyell Comstock Mine  
 Field Notes of Survey of  
 Continued from Sheet N<sup>o</sup> 3

N<sup>o</sup> 4 Slope (continued)  
 Continued from last column

N<sup>o</sup> 11 Slope Drive (continued)  
 Continued from last column

N<sup>o</sup> 5 Level  
 Continued from last column