

5 cm

The Mount Lyell Mining & Railway Co Ltd


Mine Department

FIELD NOTES OF UNDERGROUND WORKINGS UP TO 31-12-

INSTRUMENT USED 5" THEODOLITE

SHEET N^o 5

R. Williams General Manager
J. H. de la Roche Mine Superintendent

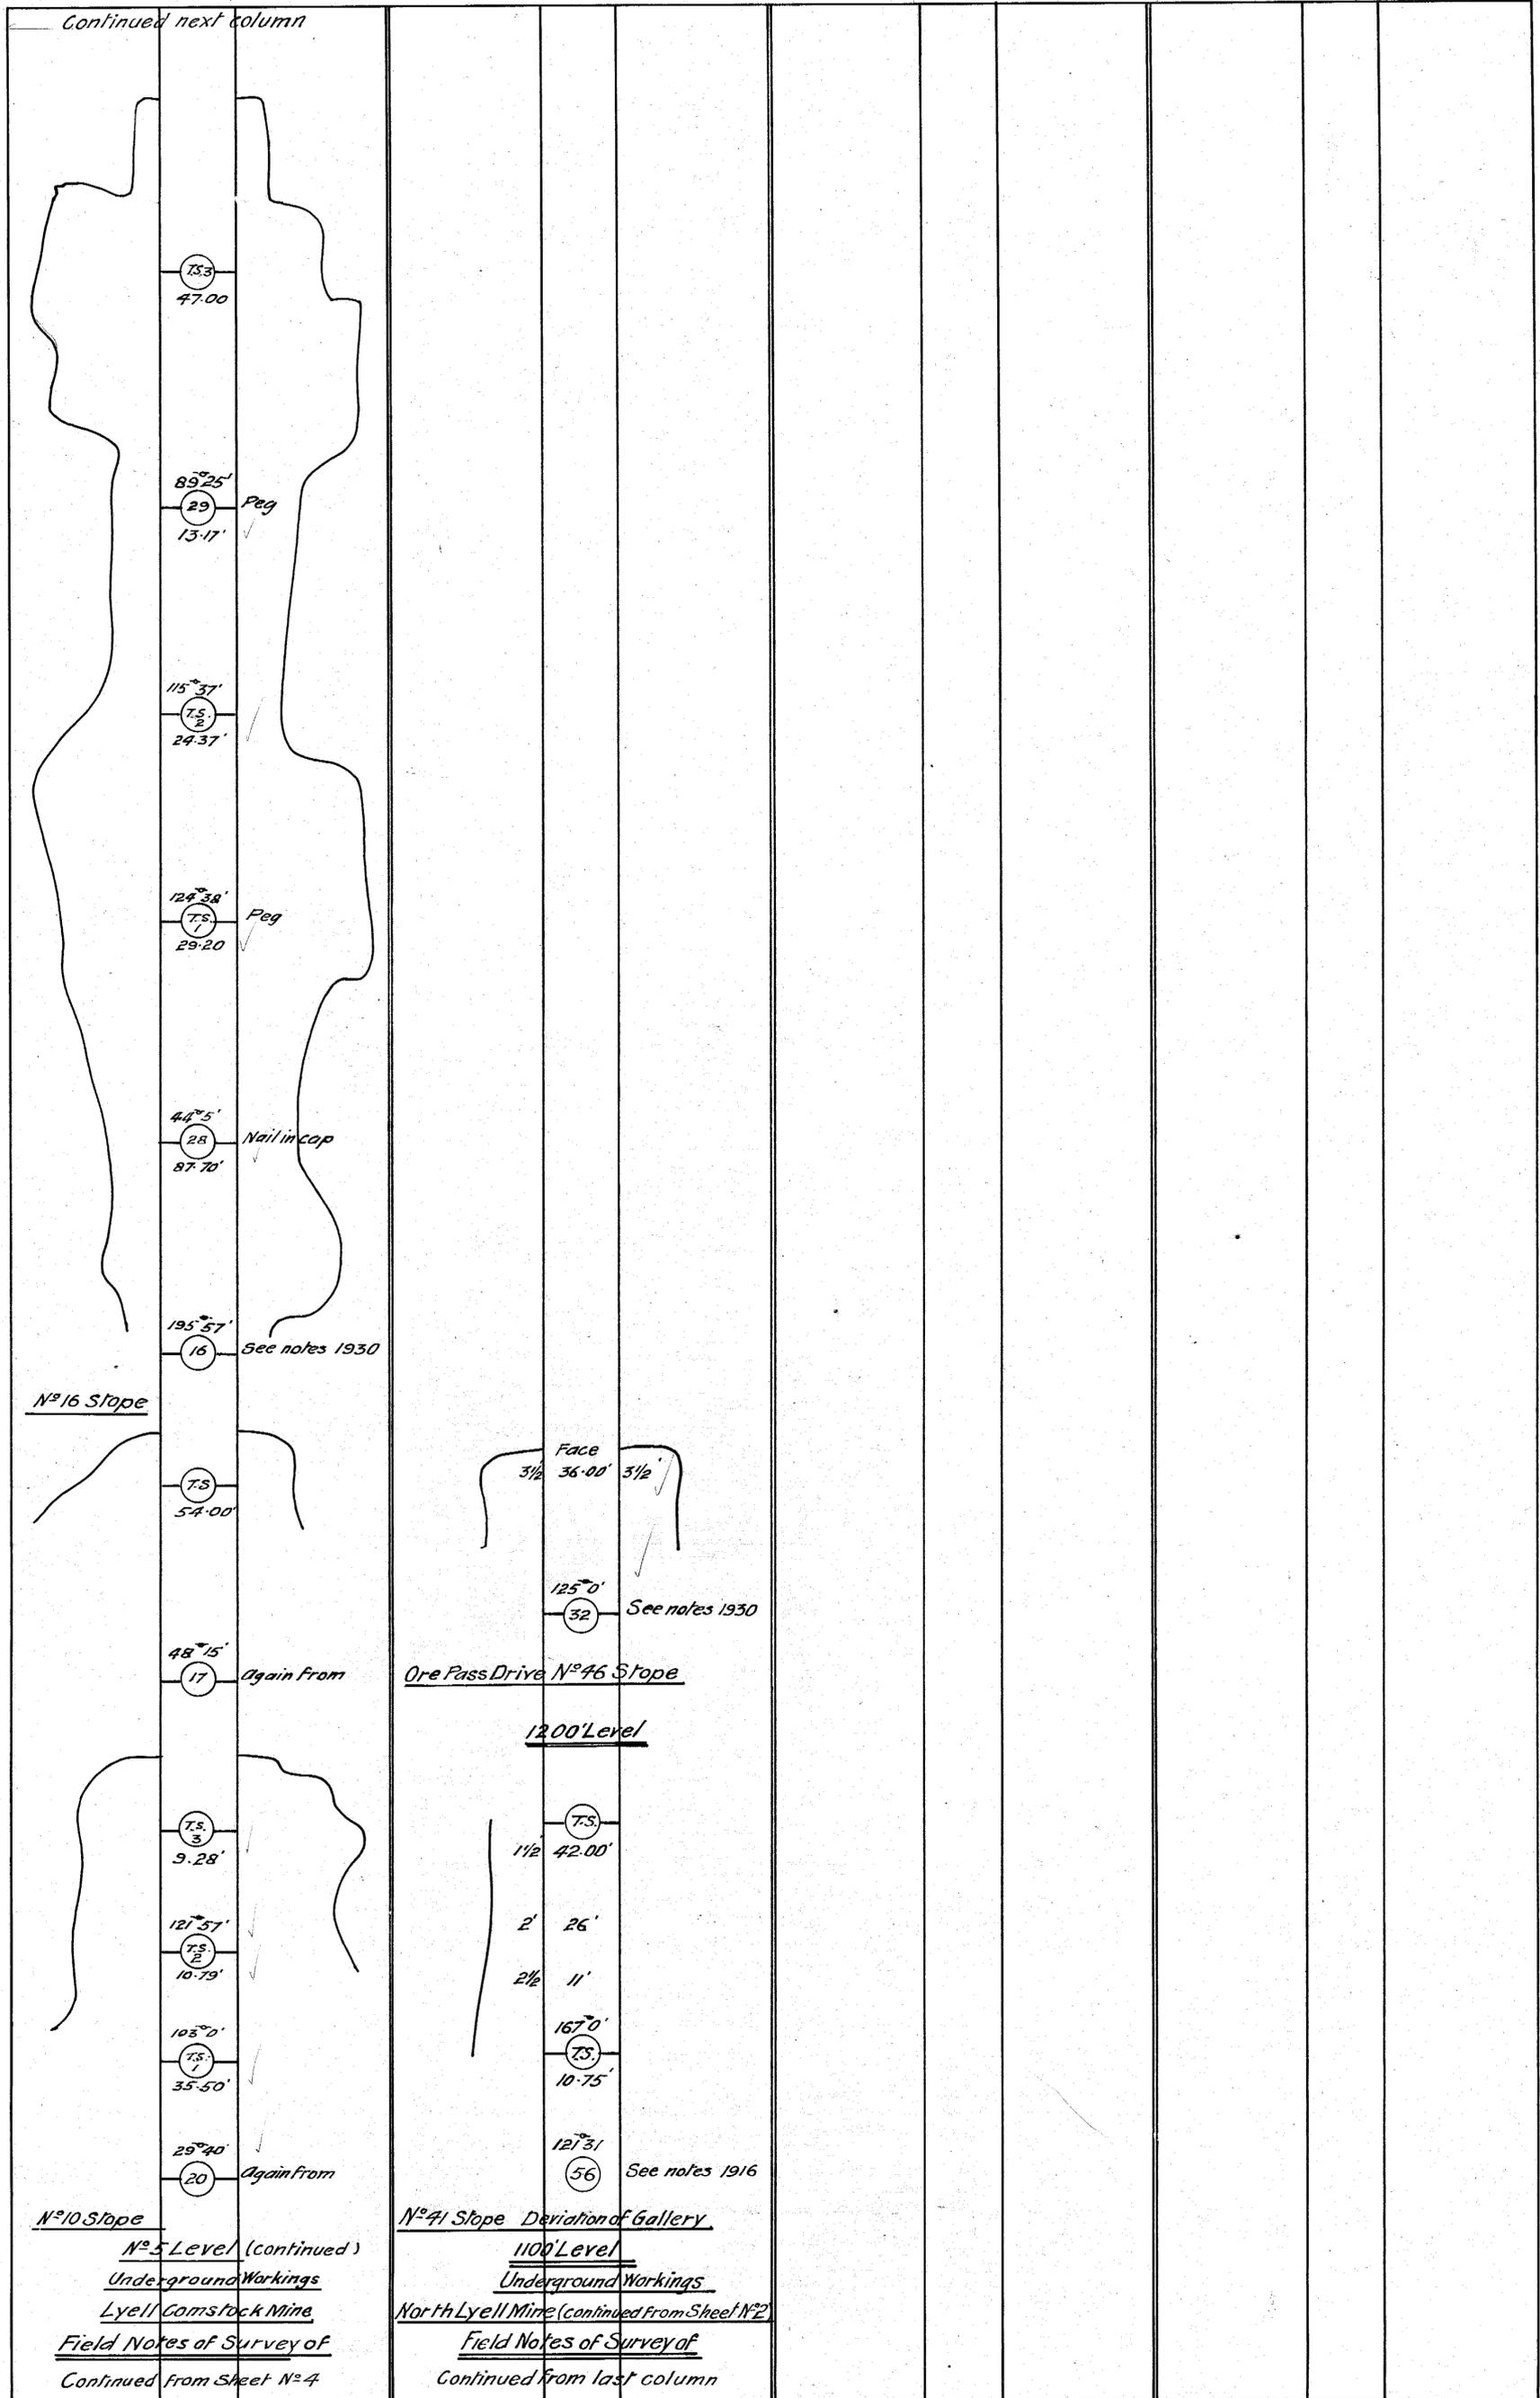

14/1/12