


0056-166

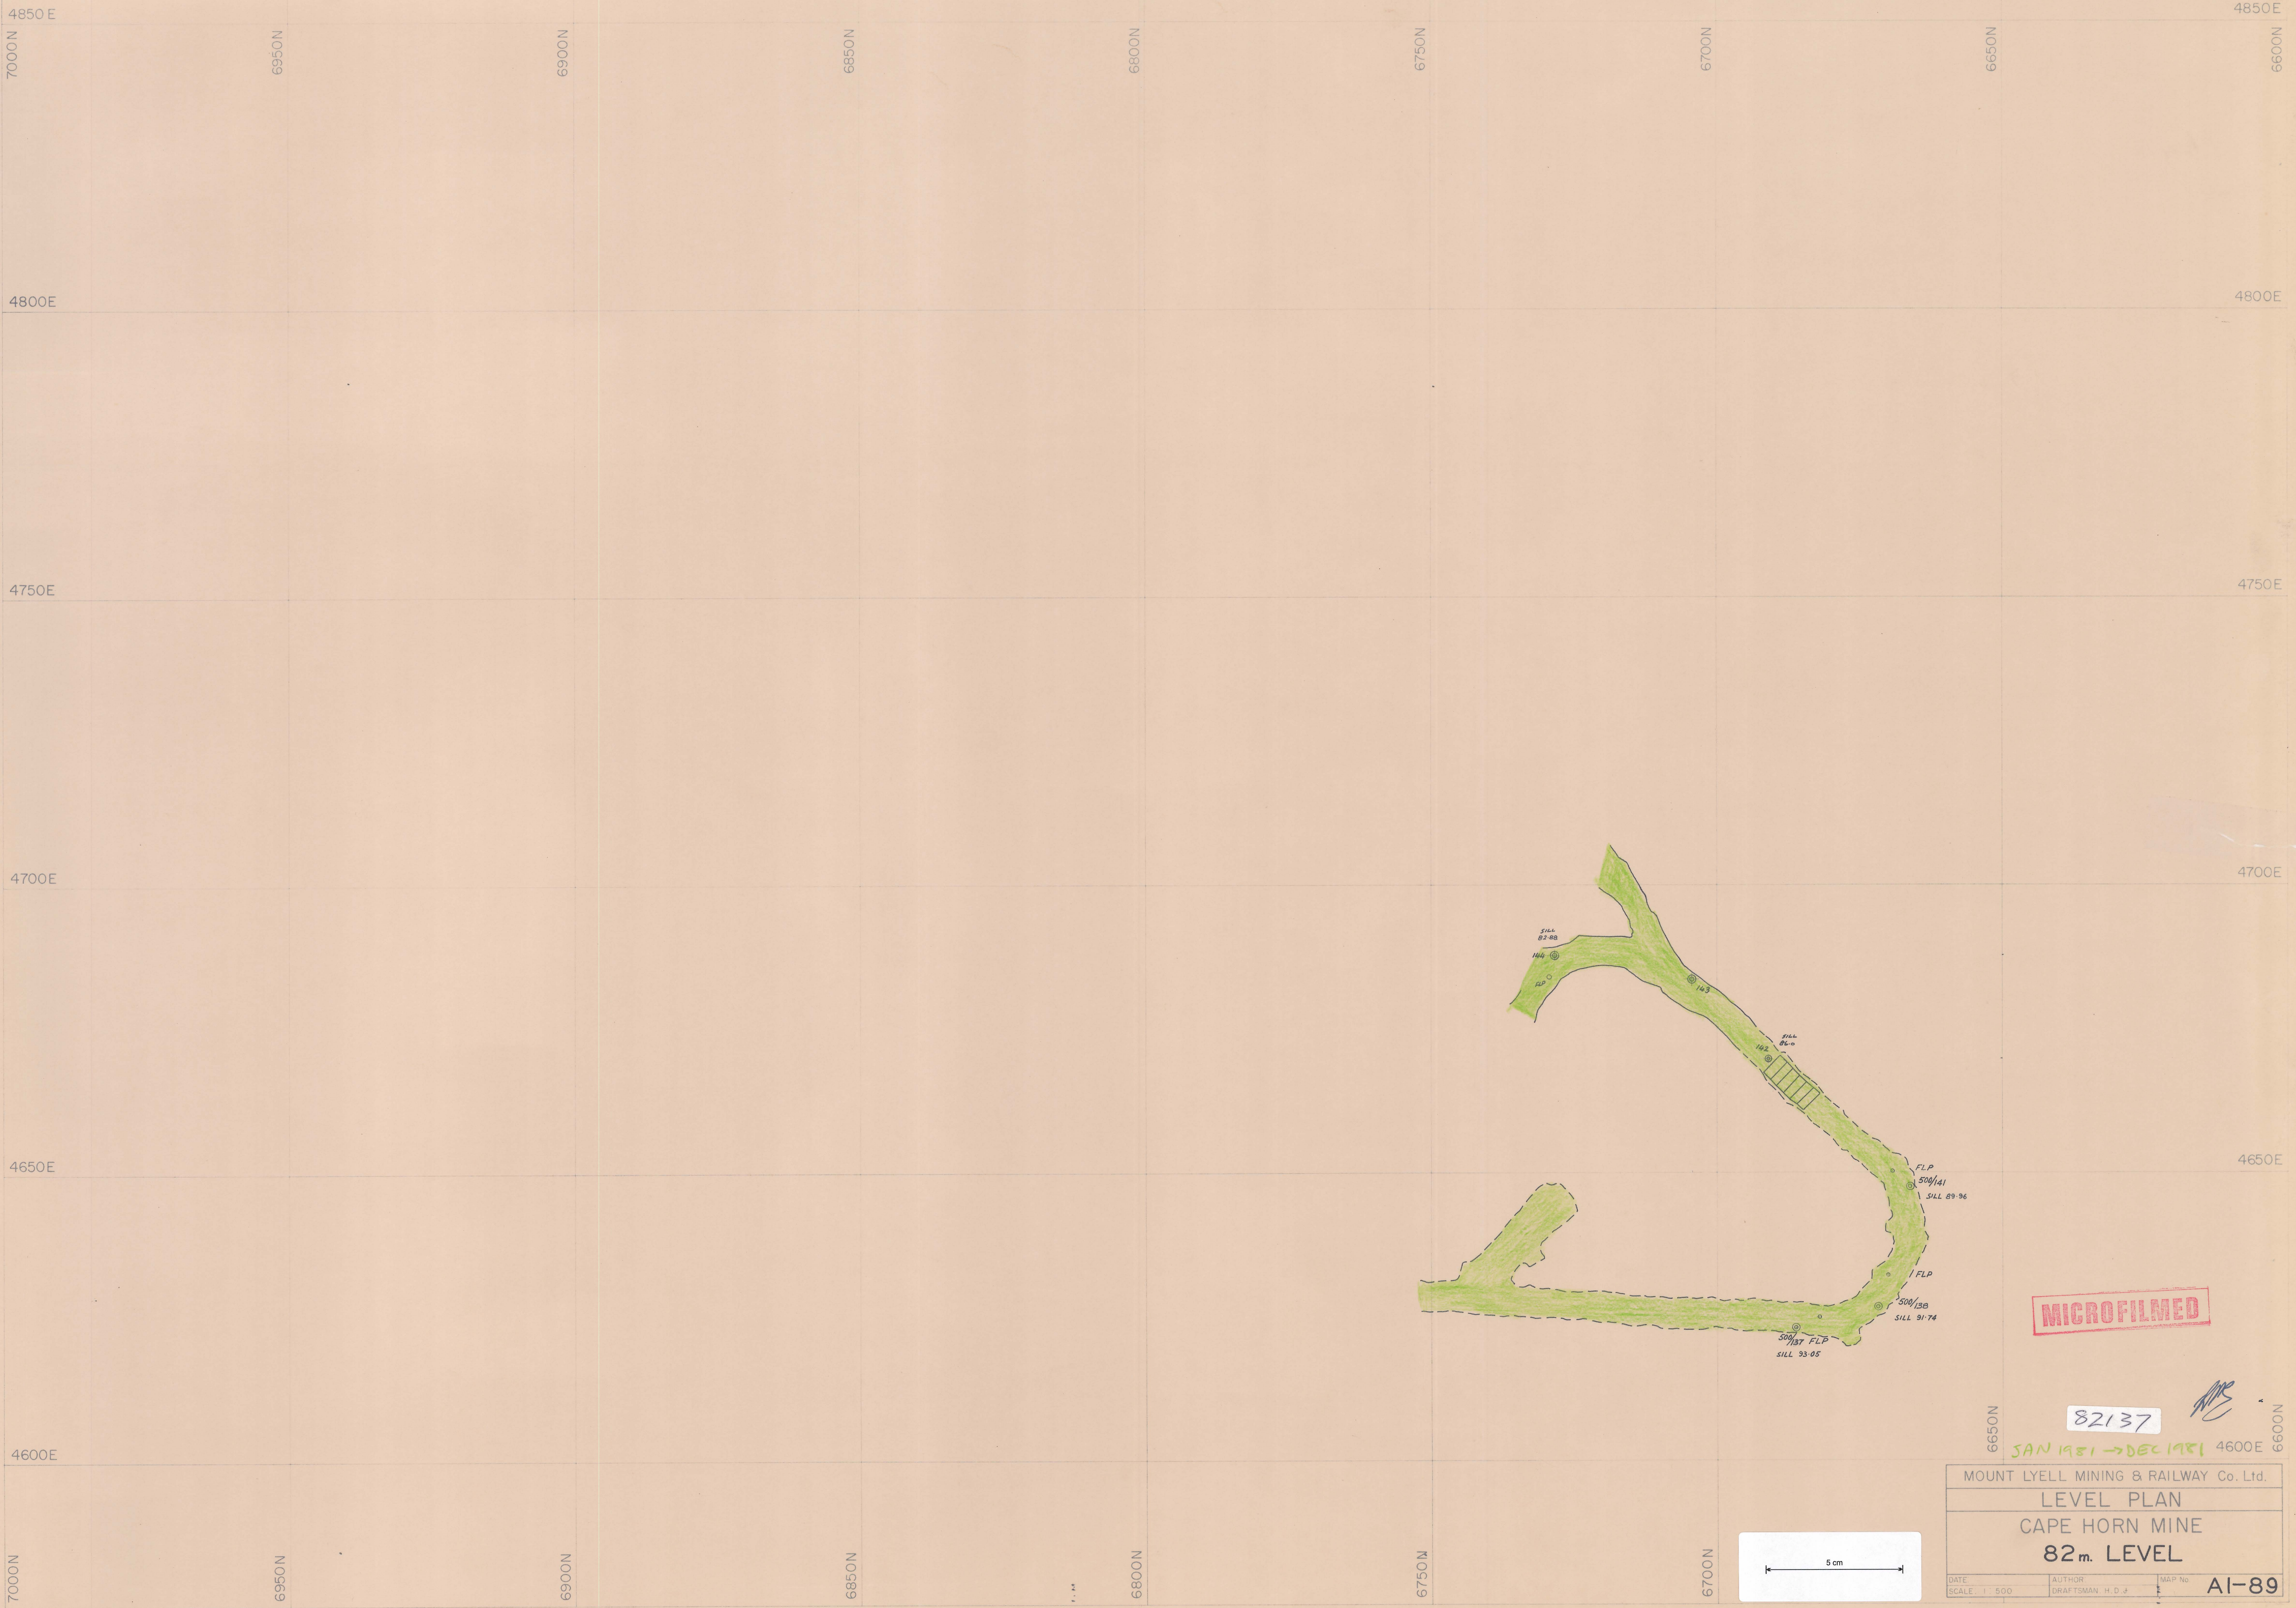

MICROFILMED

82137

JAN 1981 → DEC 1981

MOUNT LYELL MINING & RAILWAY Co. Ltd.		
LEVEL PLAN		
CAPE HORN MINE		
82m. LEVEL		
DATE	AUTHOR	MAP No
SCALE 1:500	DRAFTSMAN H.D.J.	AI-89

