



0056-168

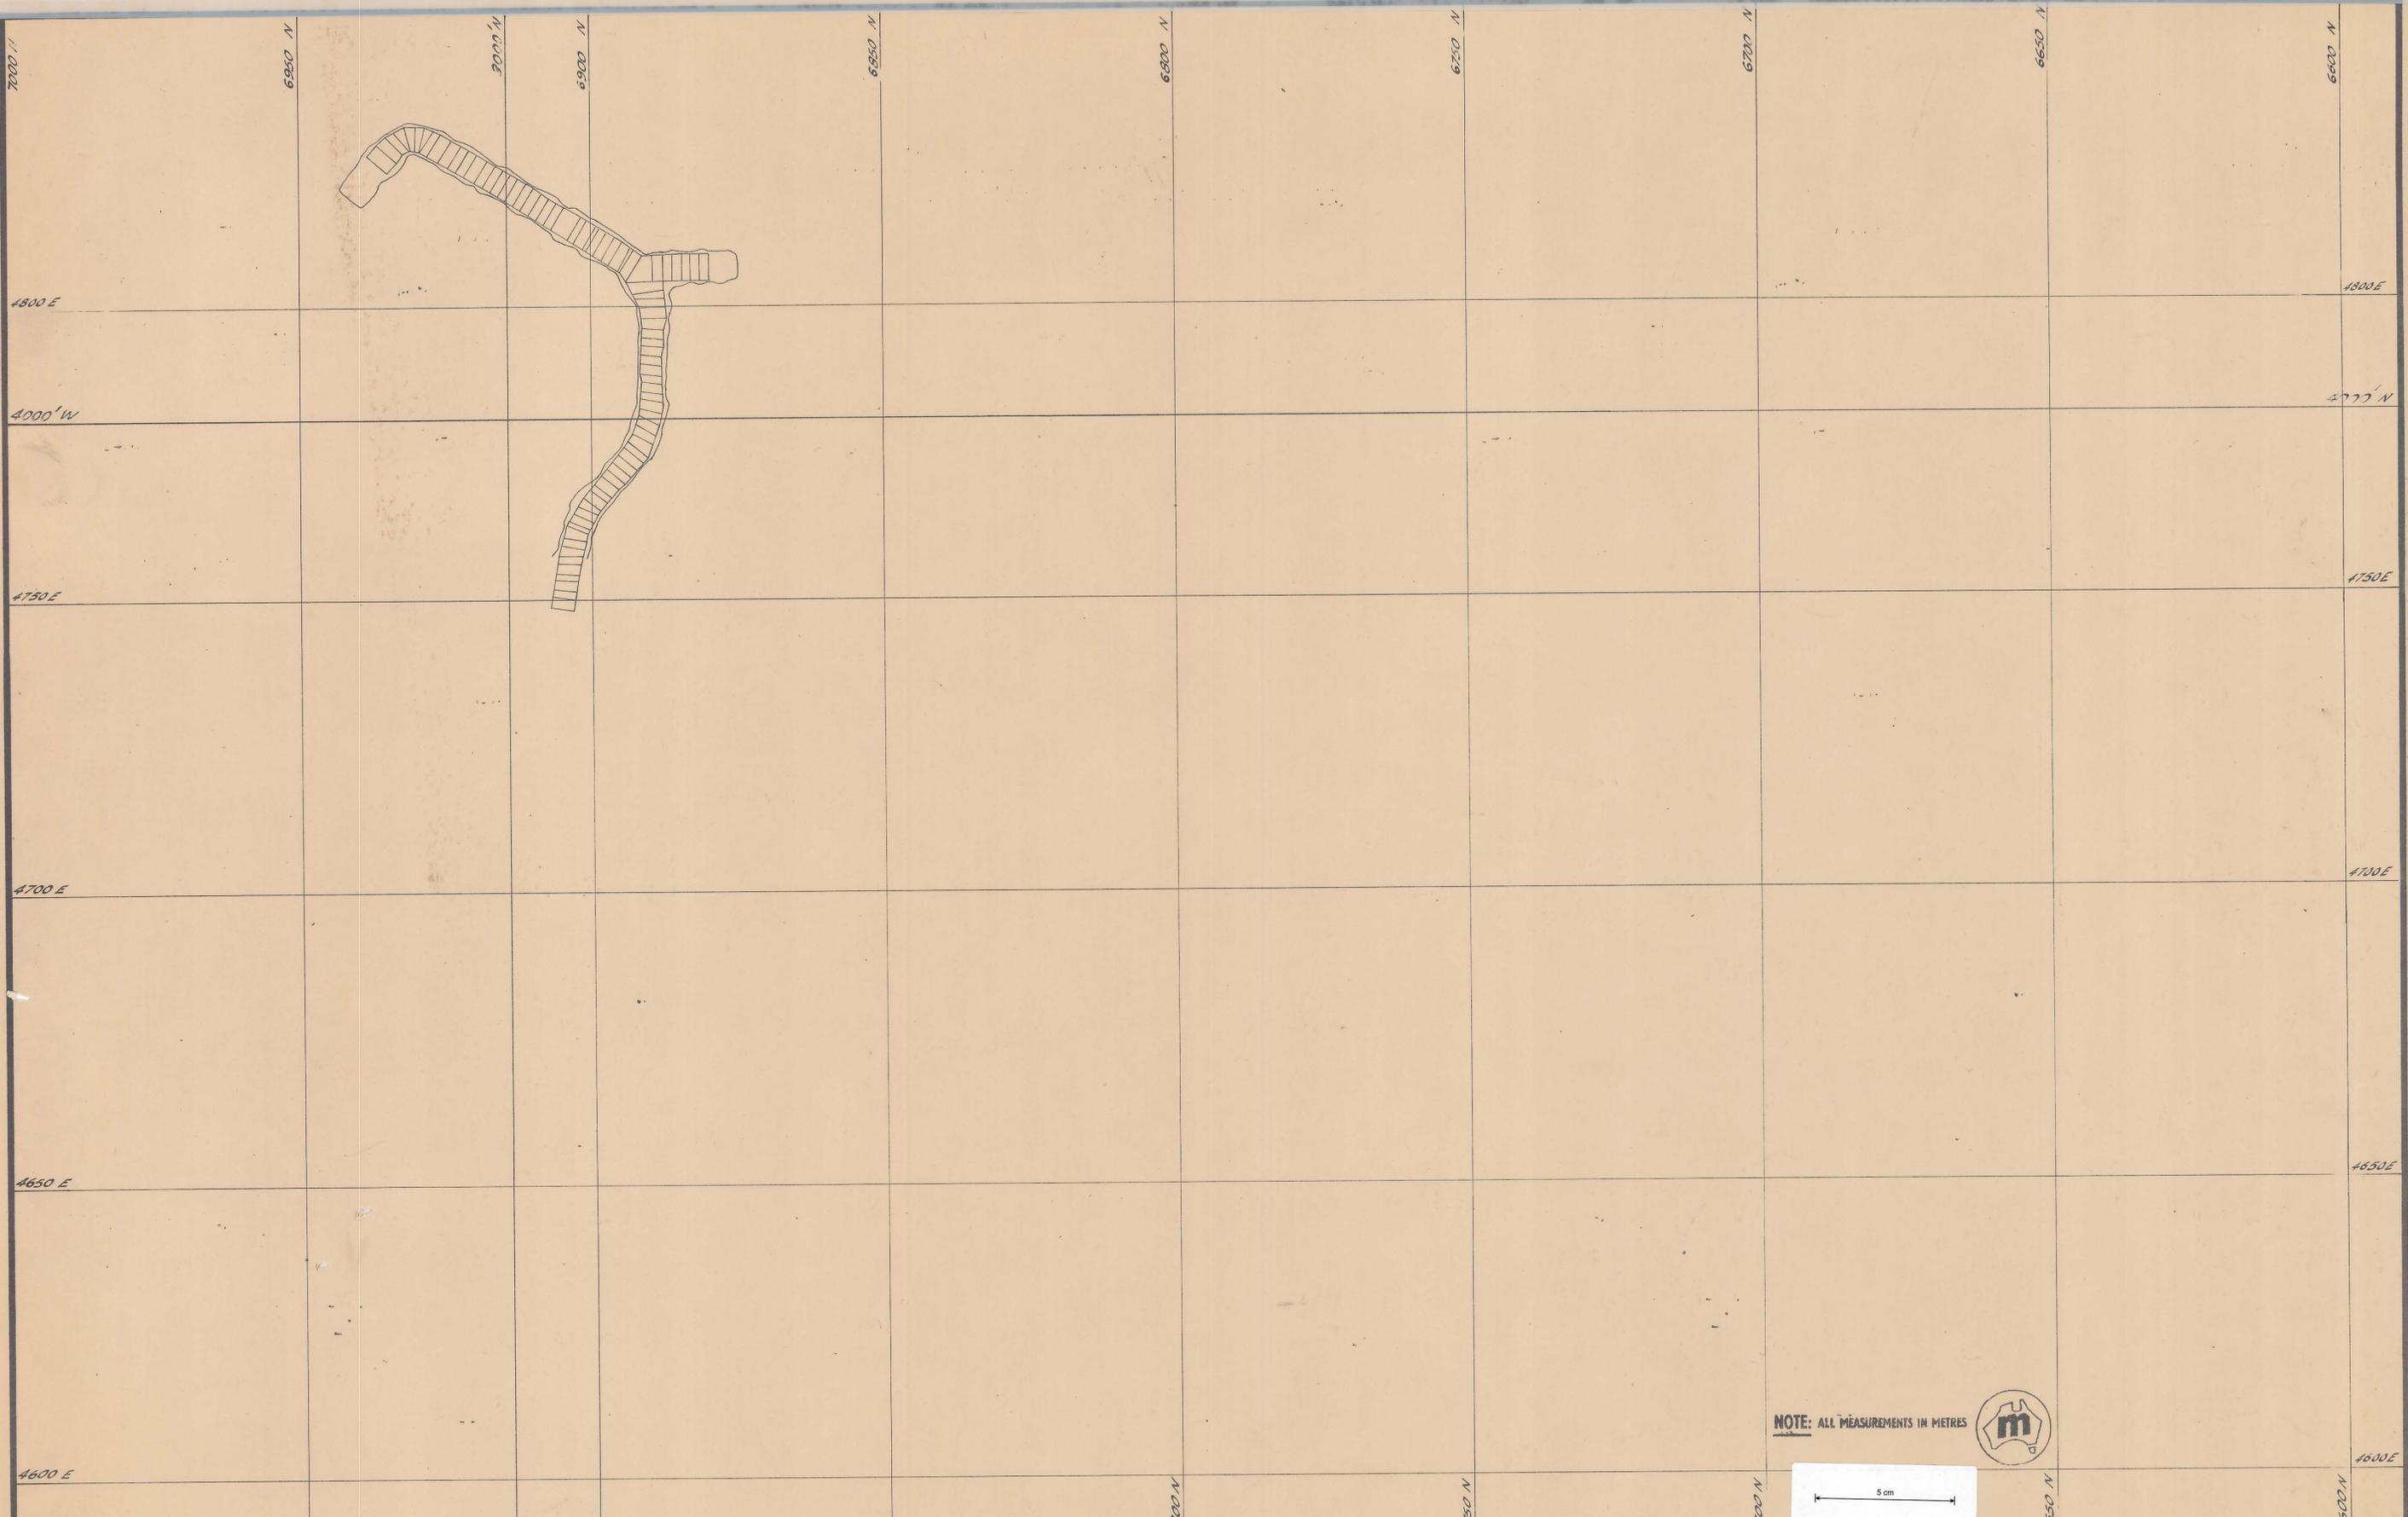

NOTE: ALL MEASUREMENTS IN METRES

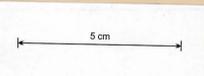

N ^o	DATE	APPD	AMENDMENT

MOUNT LYELL M. & R. CO. LTD.
MINE DEPARTMENT

Scale: 1:500
Date: JUNE 1973

Surveyed:
Designed:
Drawn:
Traced:
Checked:
Checked:

APPROVED
U/G Mgr.
C/M Eng.
C/Surv.
C/Geol.
Mine Supt.

DRAWING N^o
AI-31
SHEET N^o
Indexed
Drawer N^o

CAPE HORN MINE
382m. LEVEL SILL PLAN